



590

Cedar Creek Addition
Oct. 97

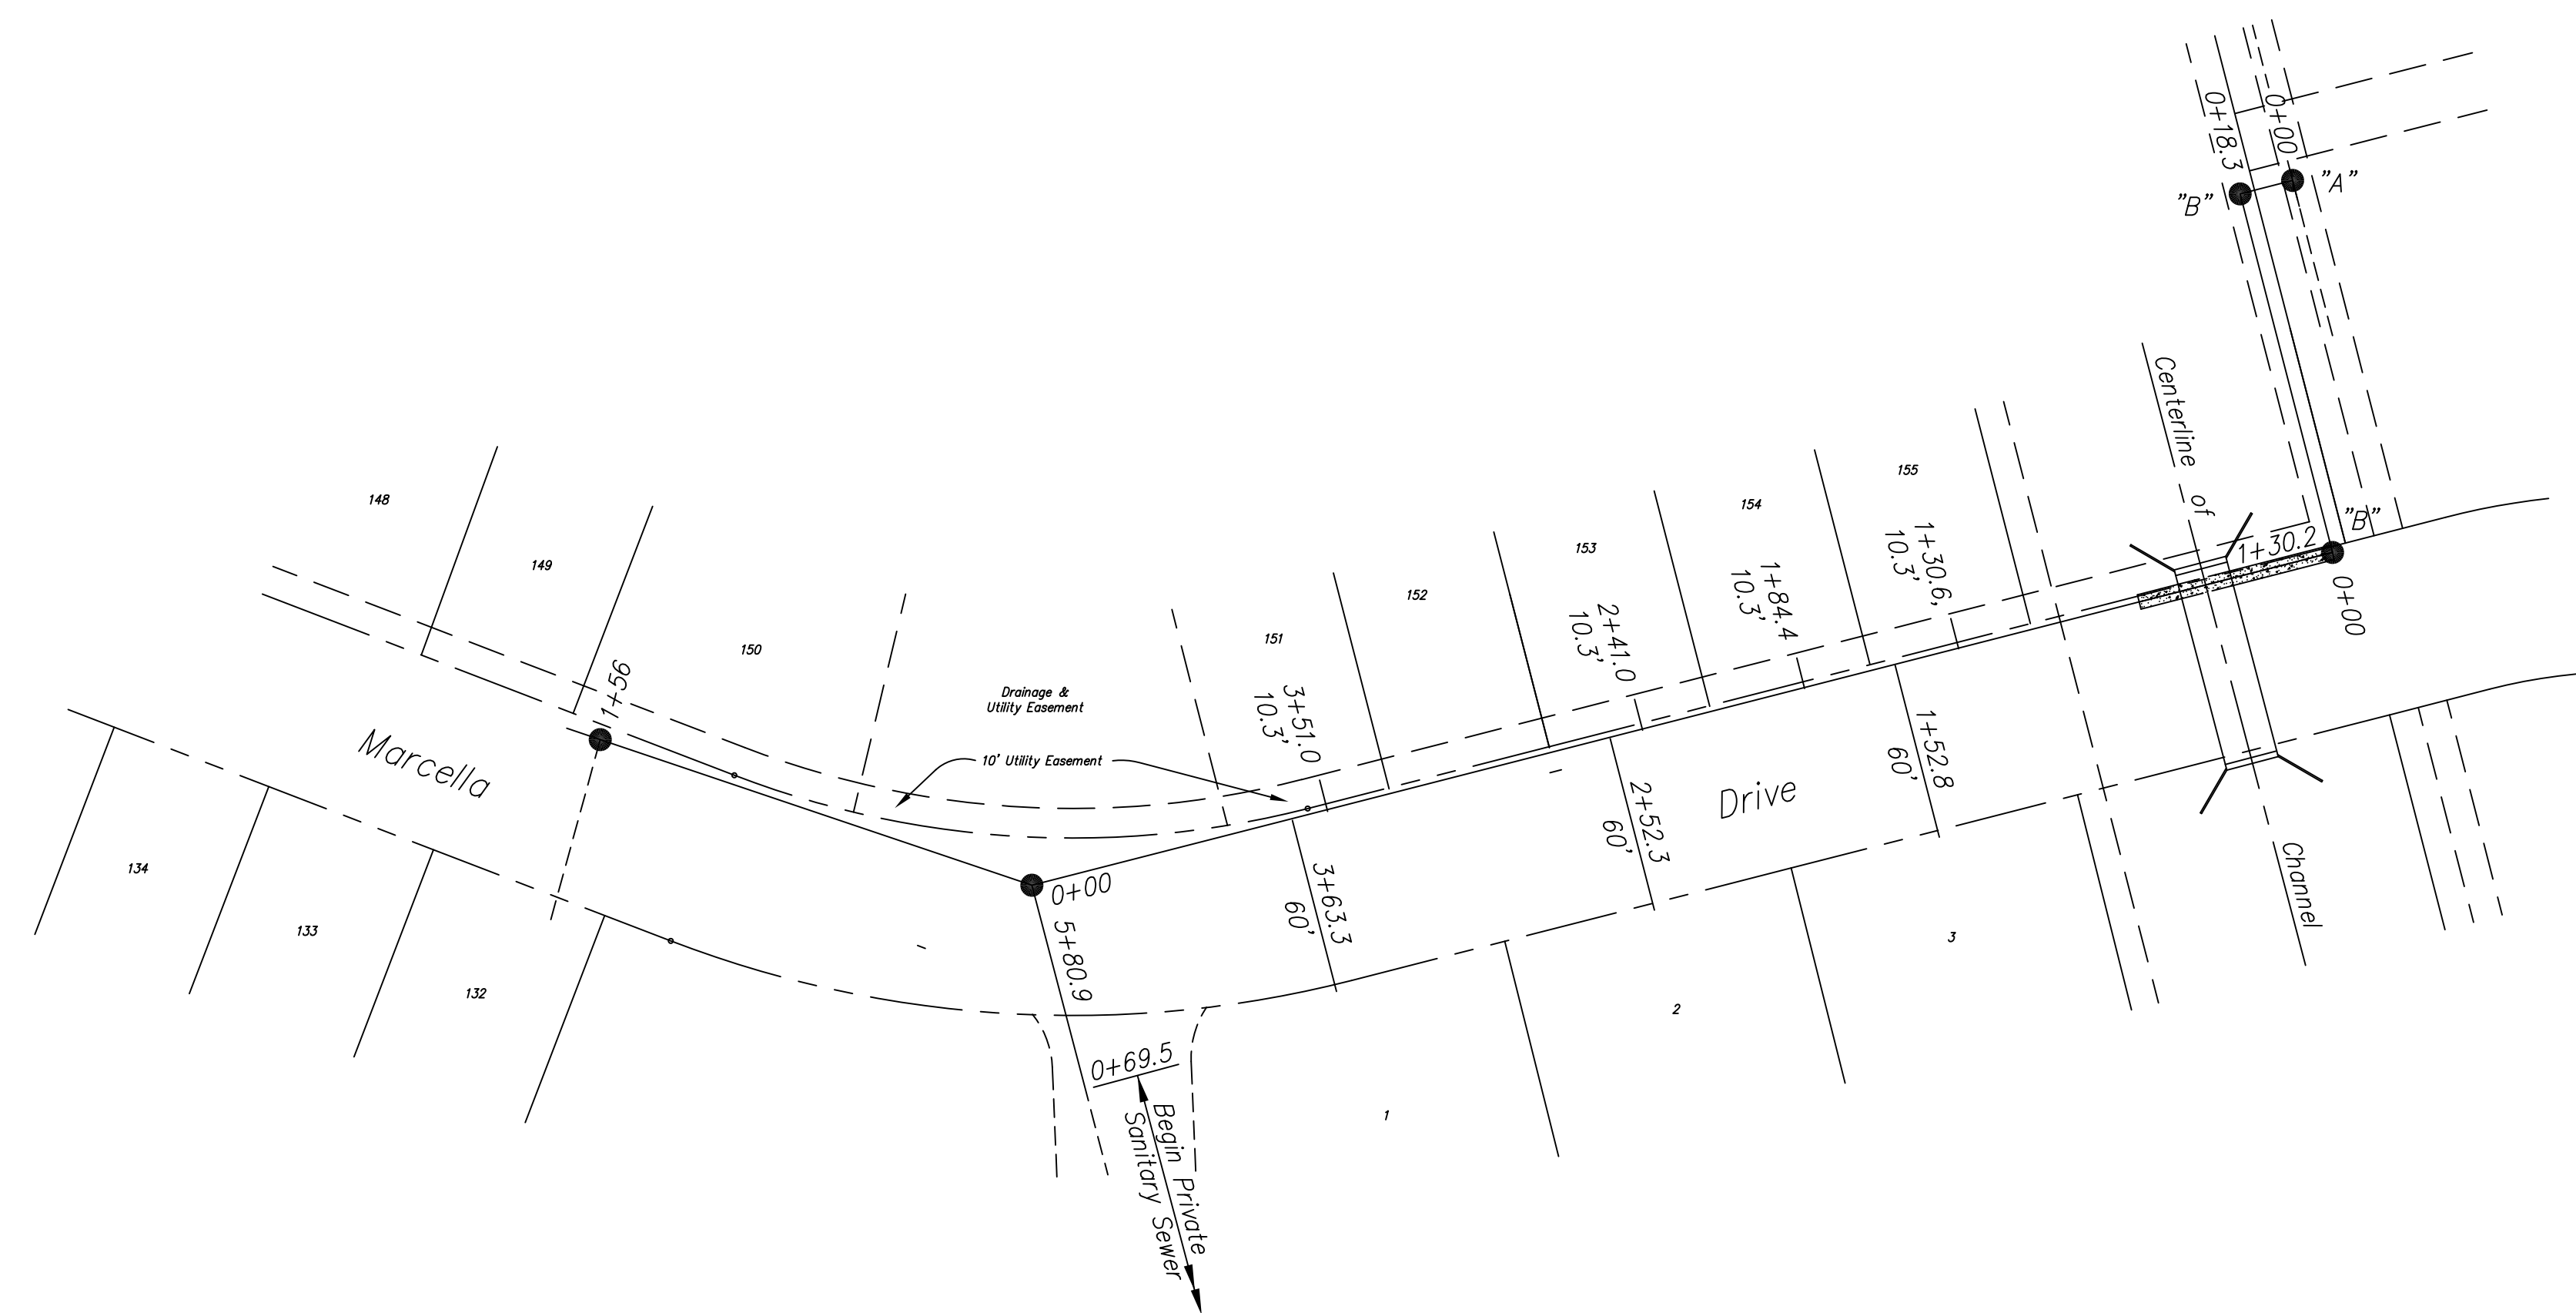

SCALE:
Plan: 1" = 50'
Profile -
Horizontal: 1" = 50'
Vertical: 1" = 5'

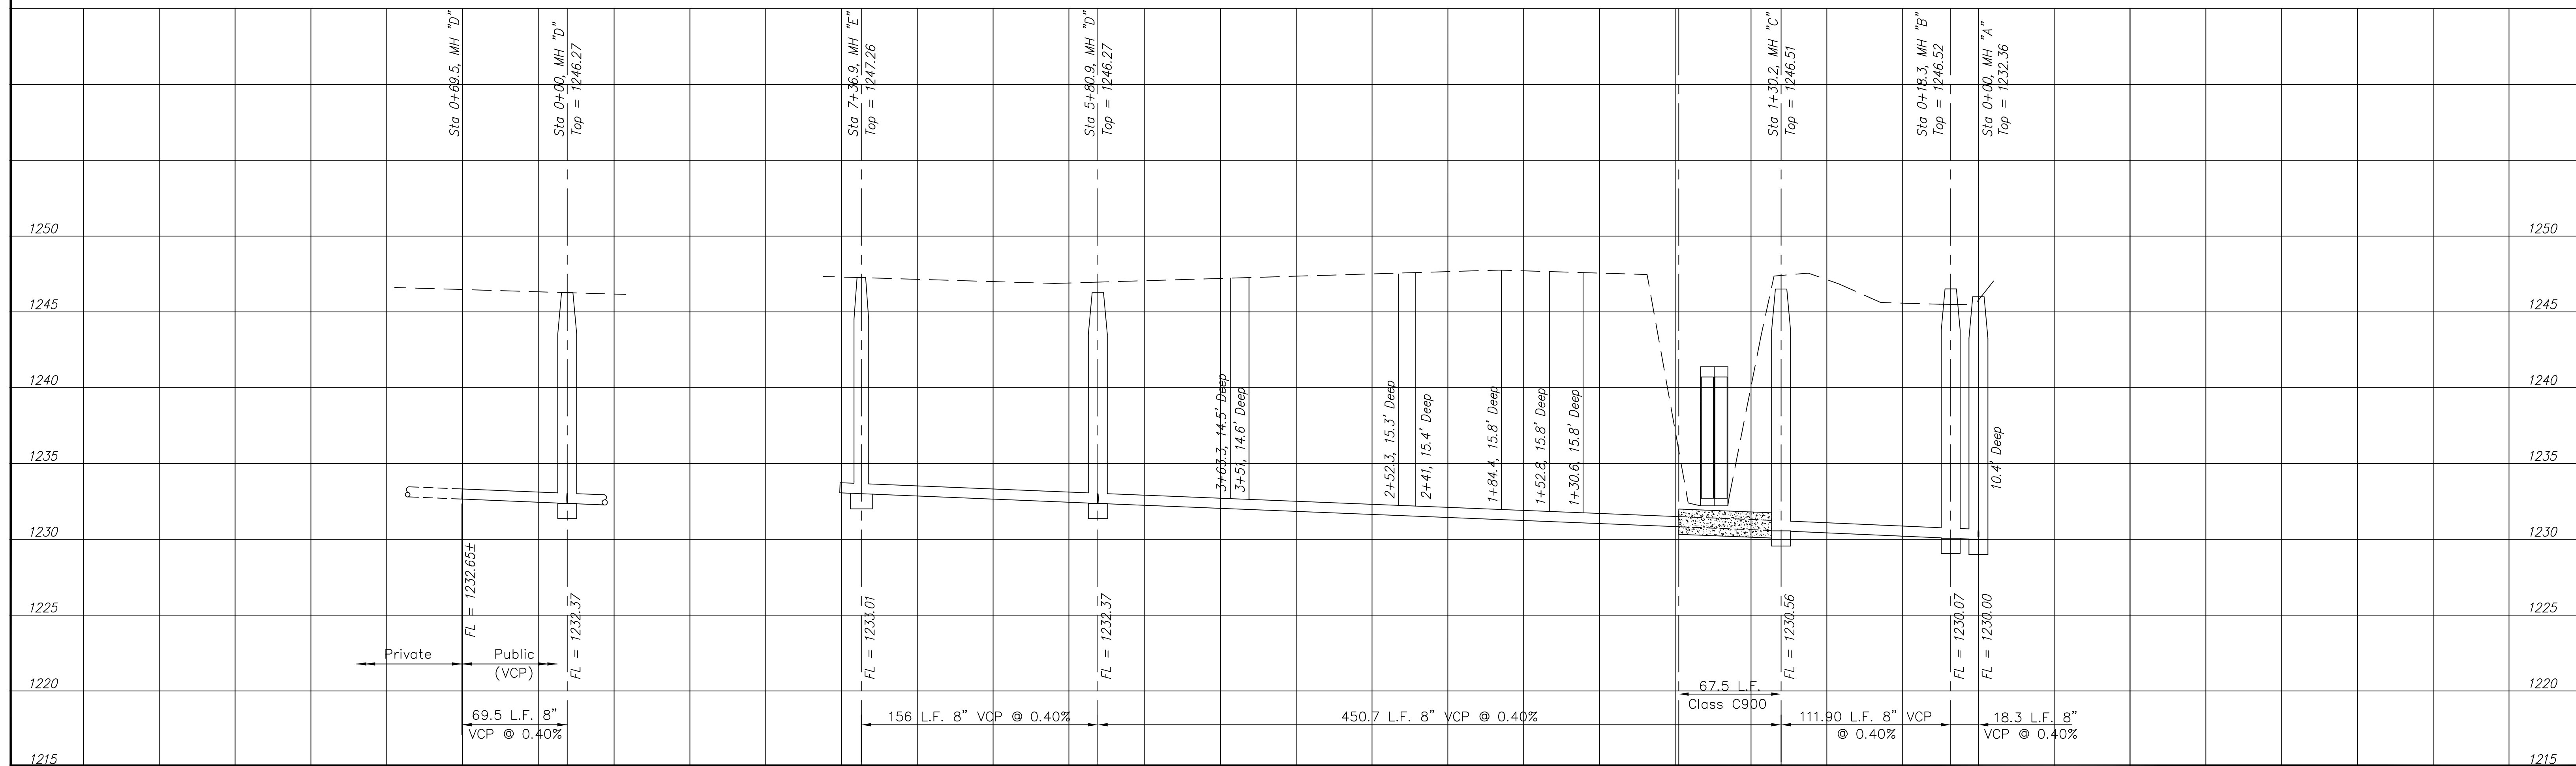

PROJECT TITLE:						SCALE:		DESIGN:		CHECKED:		CITY OF SALINA ENGINEERING DEPARTMENT 300 WEST ASH SALINA, KANSAS 67401 (913)826-7290		DATE:		PROJ. NO.:	
NO. REVISIONS						DATE		DRAWN:		APPROVED:		FILENAME:		SHEET:		OF:	