


591

Bonnie Ridge
Planned
Community
July, 1997

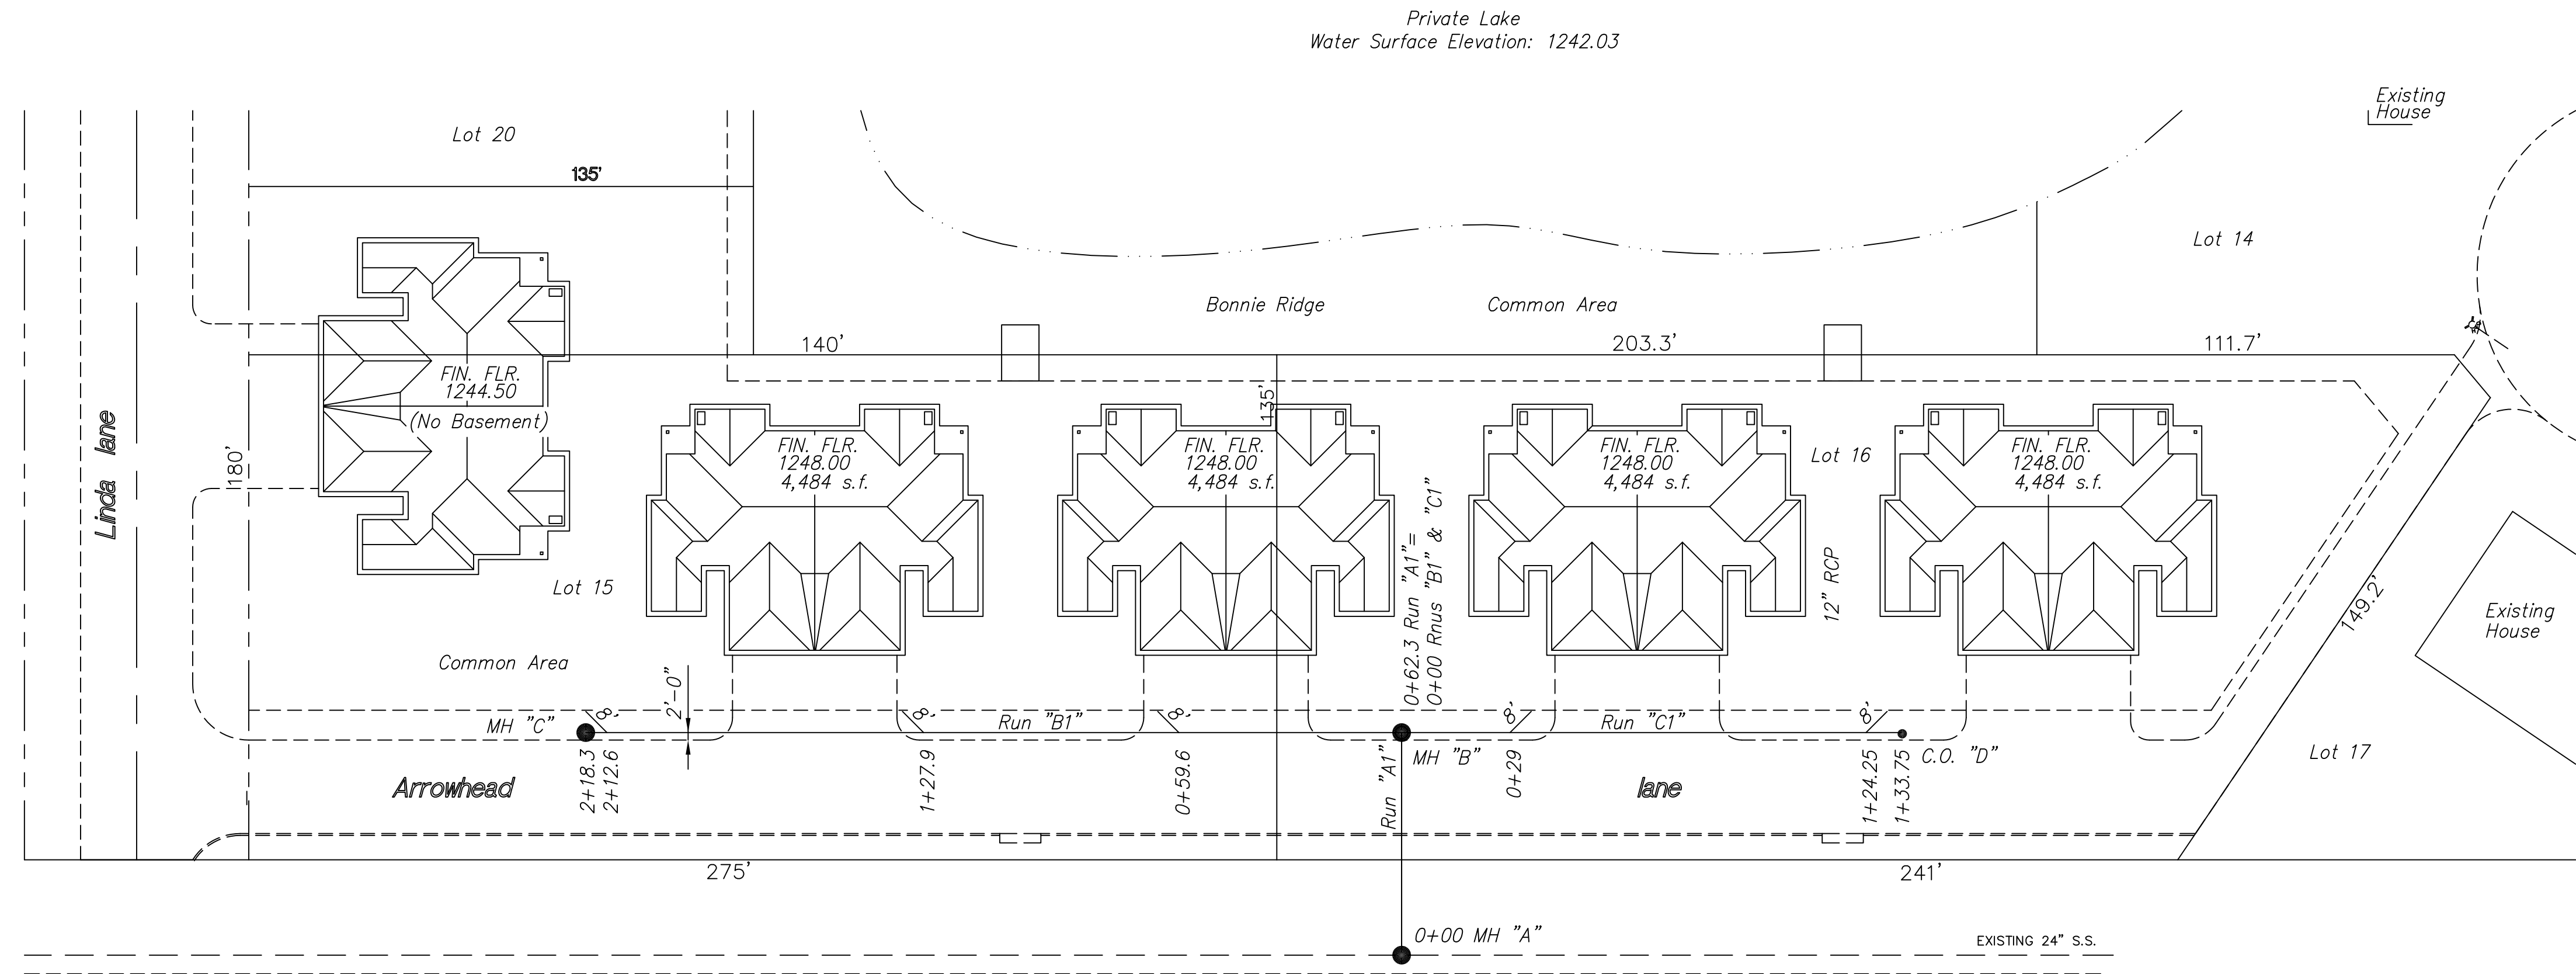

Bench Mark
U.S.C.&G. Survey disk Stamp "B292 1952"
Beneath Center of Powerline Tower at
Magnolia Road and Belmont Boulevard.
Elevation = 1238.734

SCALE:
Plan: 1" = 30'
Profile -
Horizontal: 1" = 30'
Vertical: 1" = 3'

