



593

Woodland Hills
Estates Addition
Phase 11
Oct 1997

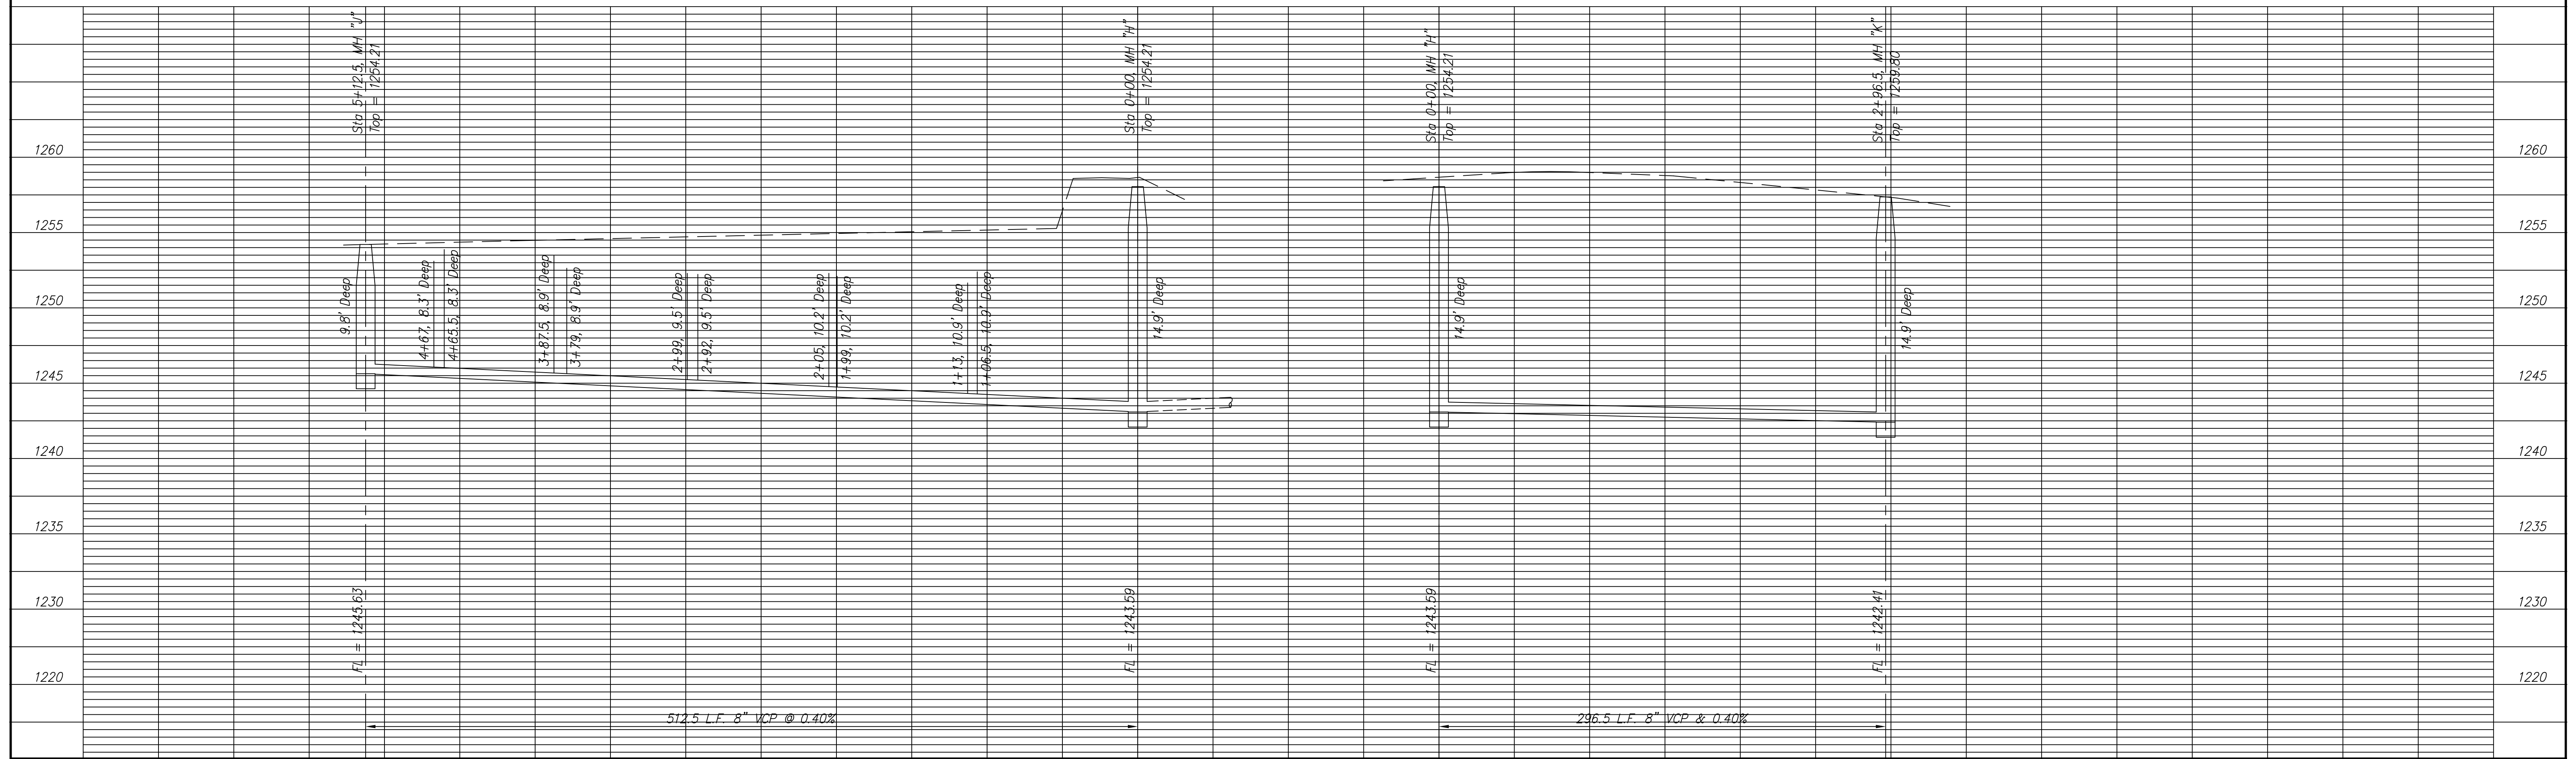

SCALE:
Plan: 1" = 50'
Profile: -
Horizontal: 1" = 50'
Vertical: 1" = 5'

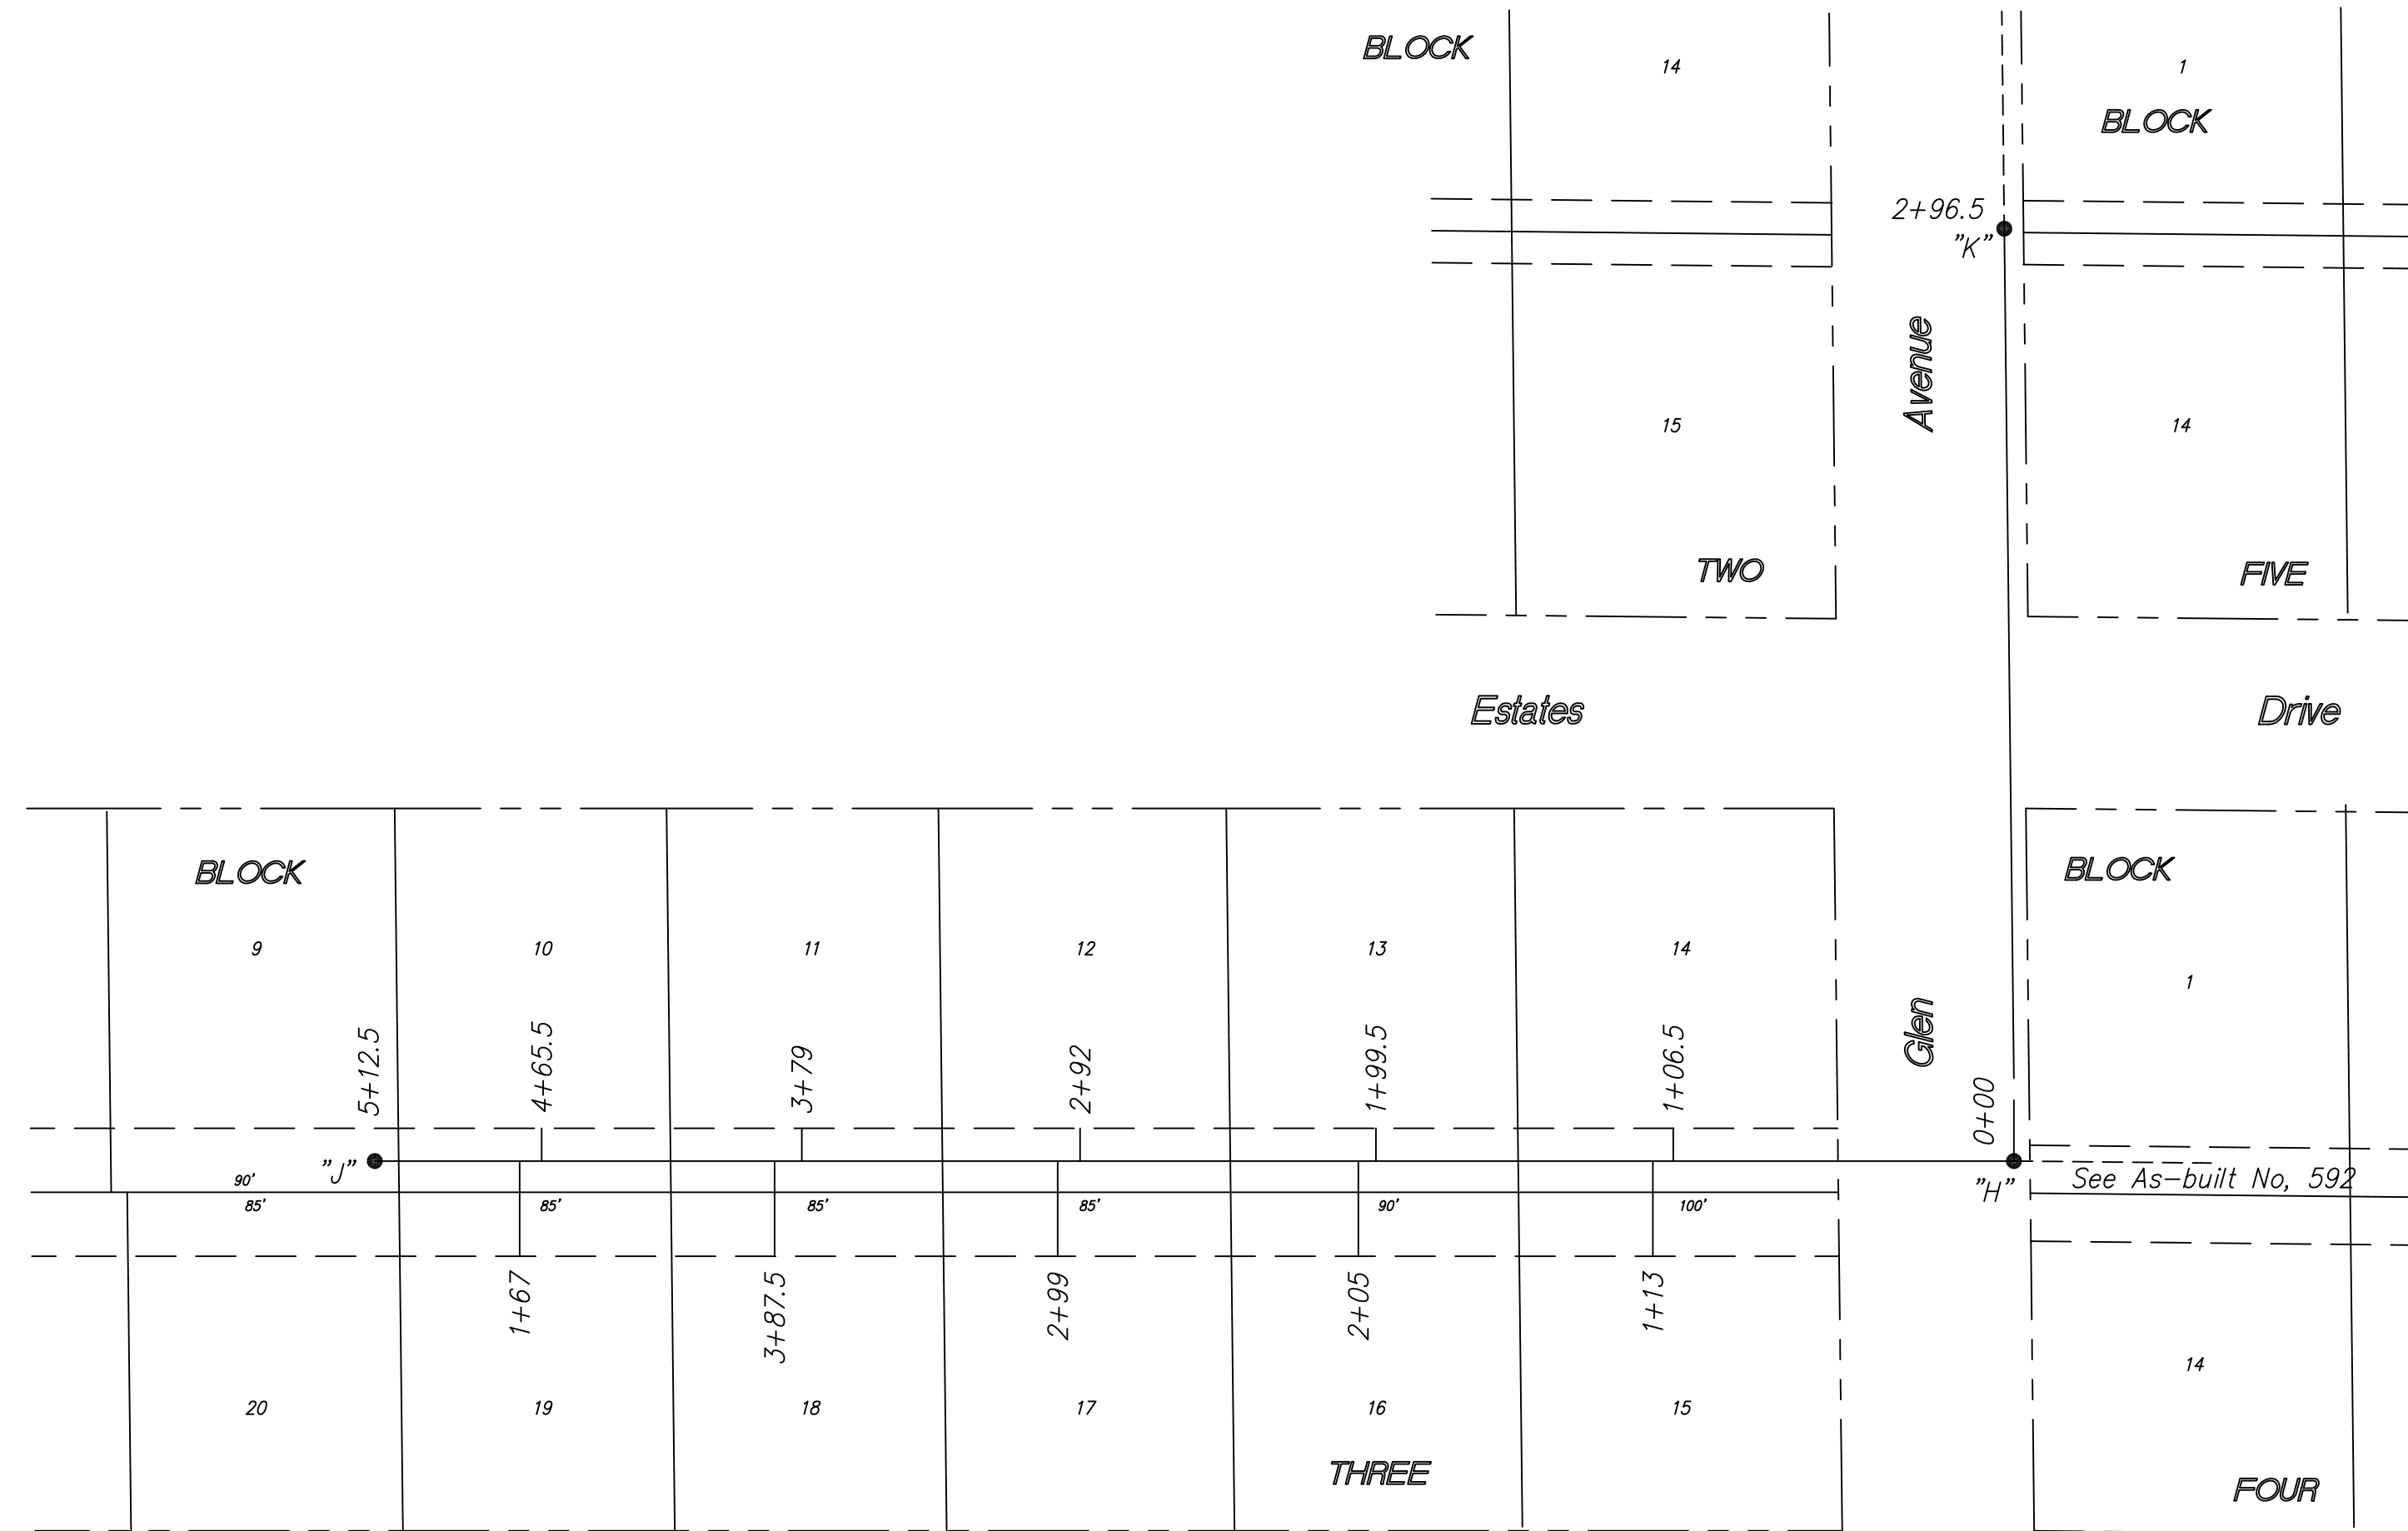

PROJECT TITLE:										SCALE:		DESIGN:		CHECKED:		CITY OF SALINA ENGINEERING DEPARTMENT		DATE:		PROJ. NO.:	
NO. REVISIONS										DRAWN:		APPROVED:		300 WEST ASH SALINA, KANSAS 67401 (913)826-7290		FILENAME:		SHEET: OF:			