
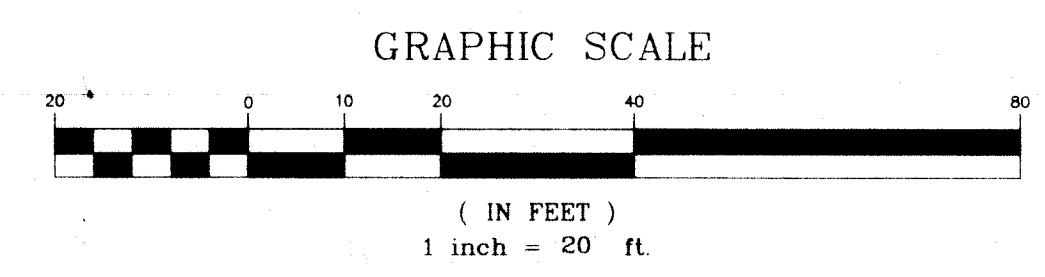


NINTH STREET

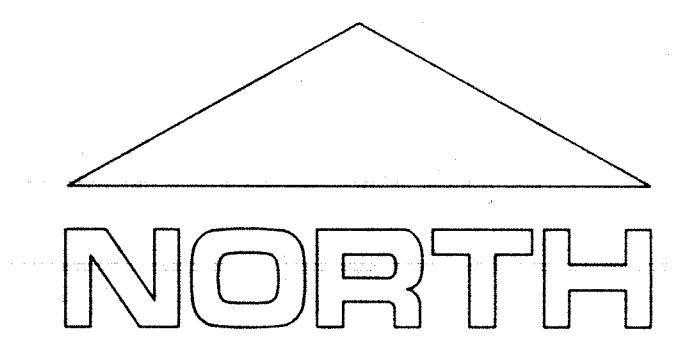

NOTES:
 All Sanitary Sewer Line shall be special trench Compacted.
 BM # 1 - Square Cut on NE Corner Of Concrete of Existing Wet Well (Elev. - 1247.87)

Quantities
 8" Sanitary Sewer Pipeline - 309.10 l.f.
 Type I Manholes - 3 ea.
 Extra Manhole Depth - 27.53 l.f.
 8" Pavement Removal & Replacement - 73.20 s.y.
 Curb & Gutter Removal & Replacement - 20 l.f.
 Trench & Backfill (14' - 16') - 309.1 l.f.
 Connect to Exist. Manhole - 1 ea.
 Traffic Control - 1 l.s.
 Special Trench Compaction - 309.10 l.f.

c:\44362.dwg 10/19/98

PROJECT TITLE						SCALE		DESIGN	CHECKED	CITY OF SALINA		DATE	PROJ. NO.	
RELOCATION OF EXISTING SEWER LINE AT SCHILLING & RIFFEL						As Shown		DRAWN	APPROVED	ENGINEERING DEPARTMENT		March 2001	Private	
NO.	REVISIONS	DATE	BY	NO.	REVISIONS	DATE	BY			300 WEST ASH SALINA, KANSAS 67401		FILENAME	SHEET	OF
										(913)826-7290		Sch9thSSr13.dwg	1	1