



596

Brock Addition Dec 1998

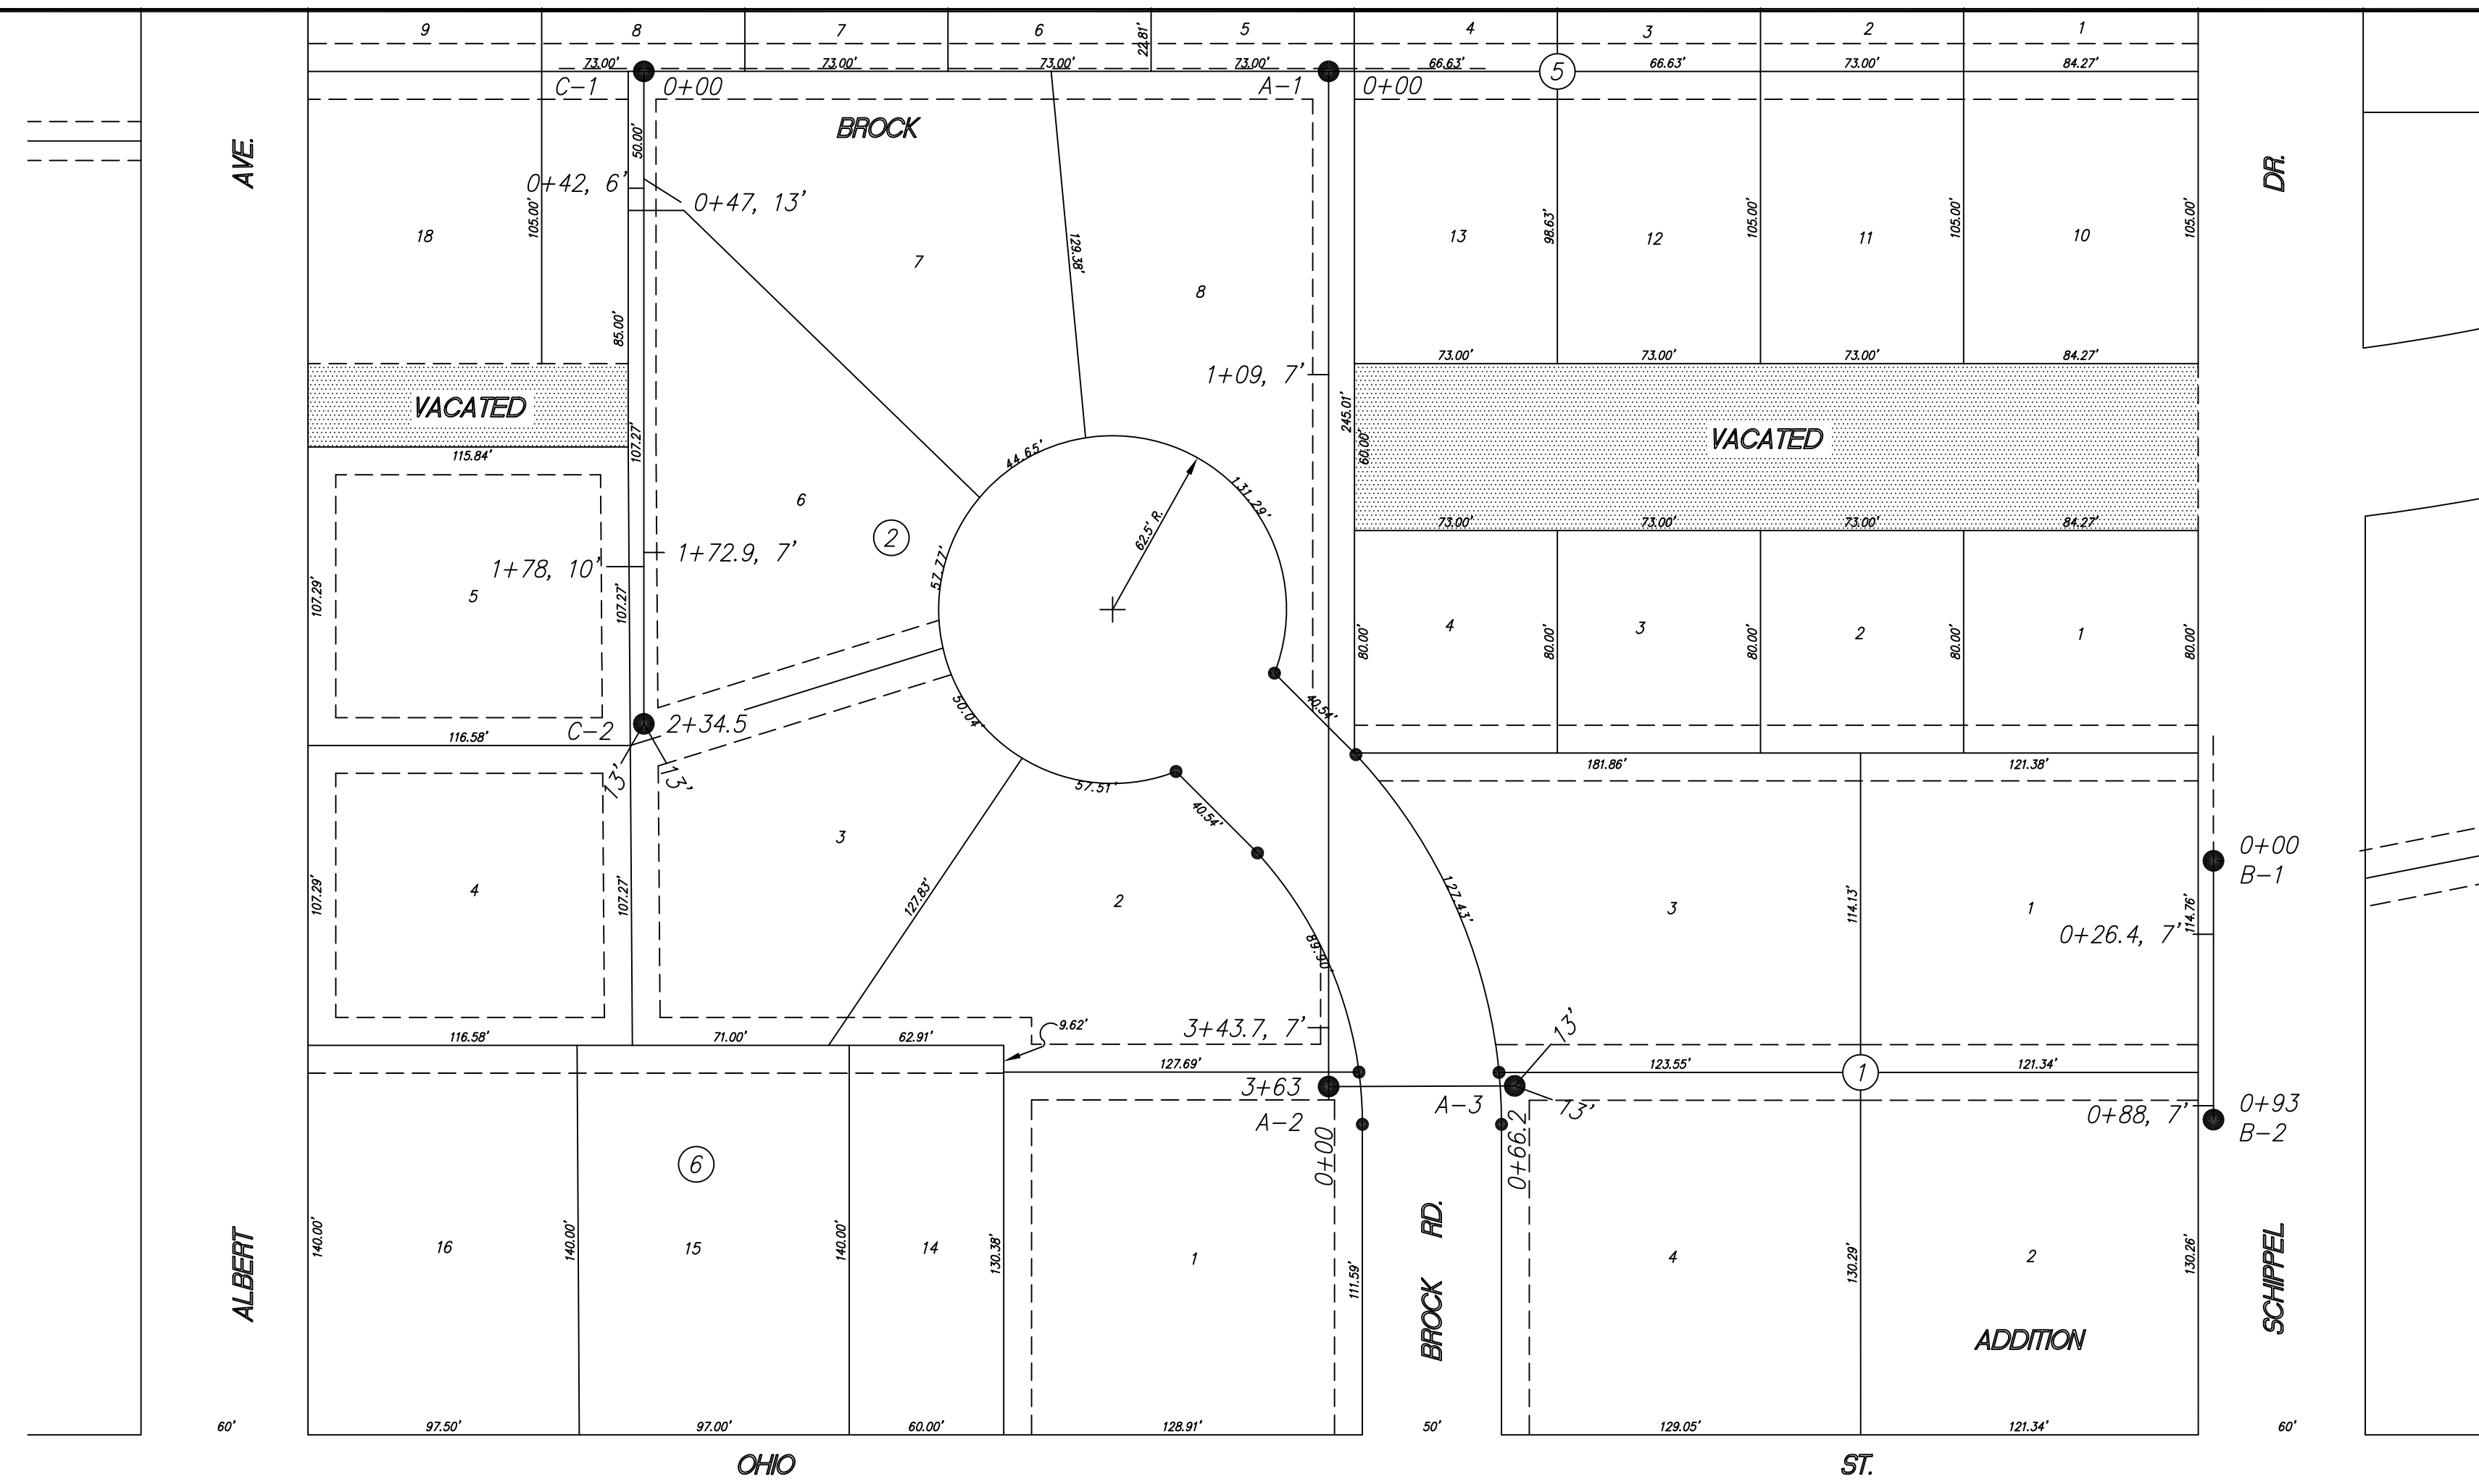

SCALE:
 Plan: 1" = 50'
 Profile: -
 Horizontal: 1" = 50'
 Vertical: 1" = 5'

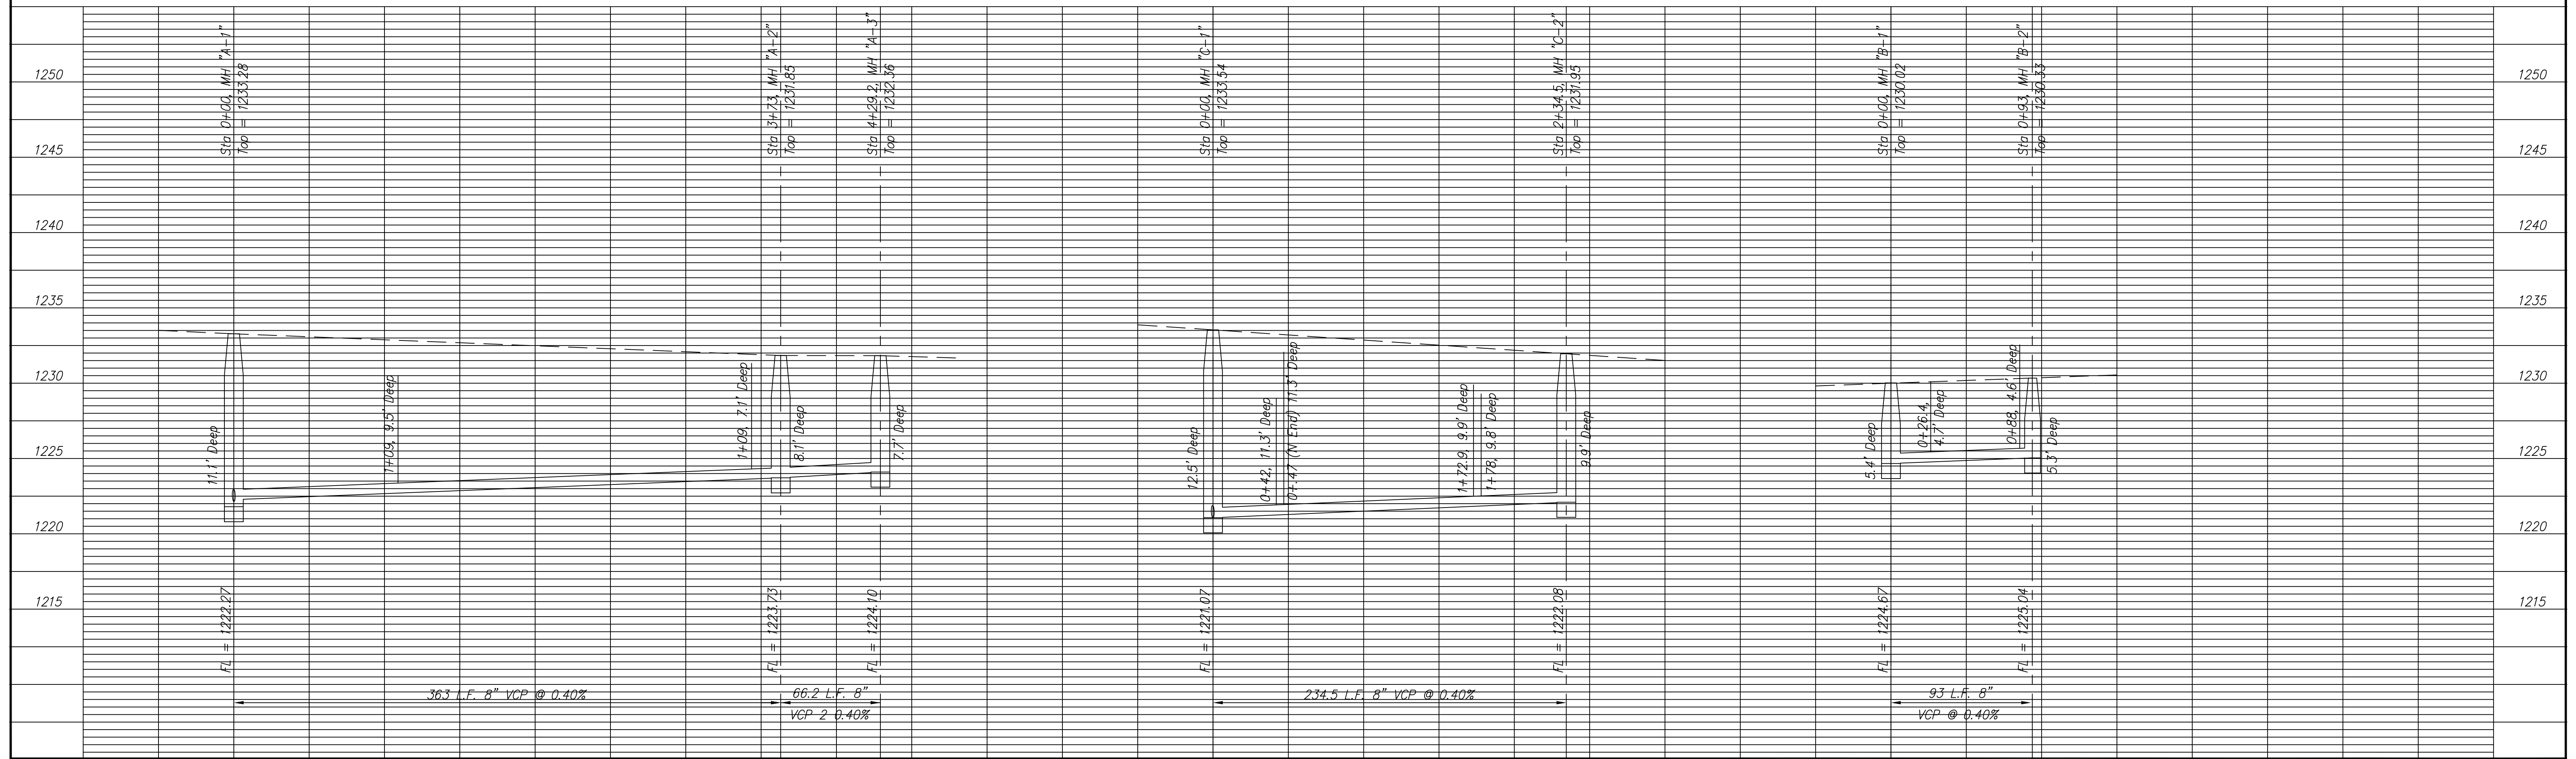

NO.					REVISIONS					DATE					BY					PROJECT TITLE:					SCALE:					DESIGN:					CHECKED:					CITY OF SALINA ENGINEERING DEPARTMENT 300 WEST ASH SALINA, KANSAS 67401 (913)826-7290					DATE:					PROJ. NO.:				
