

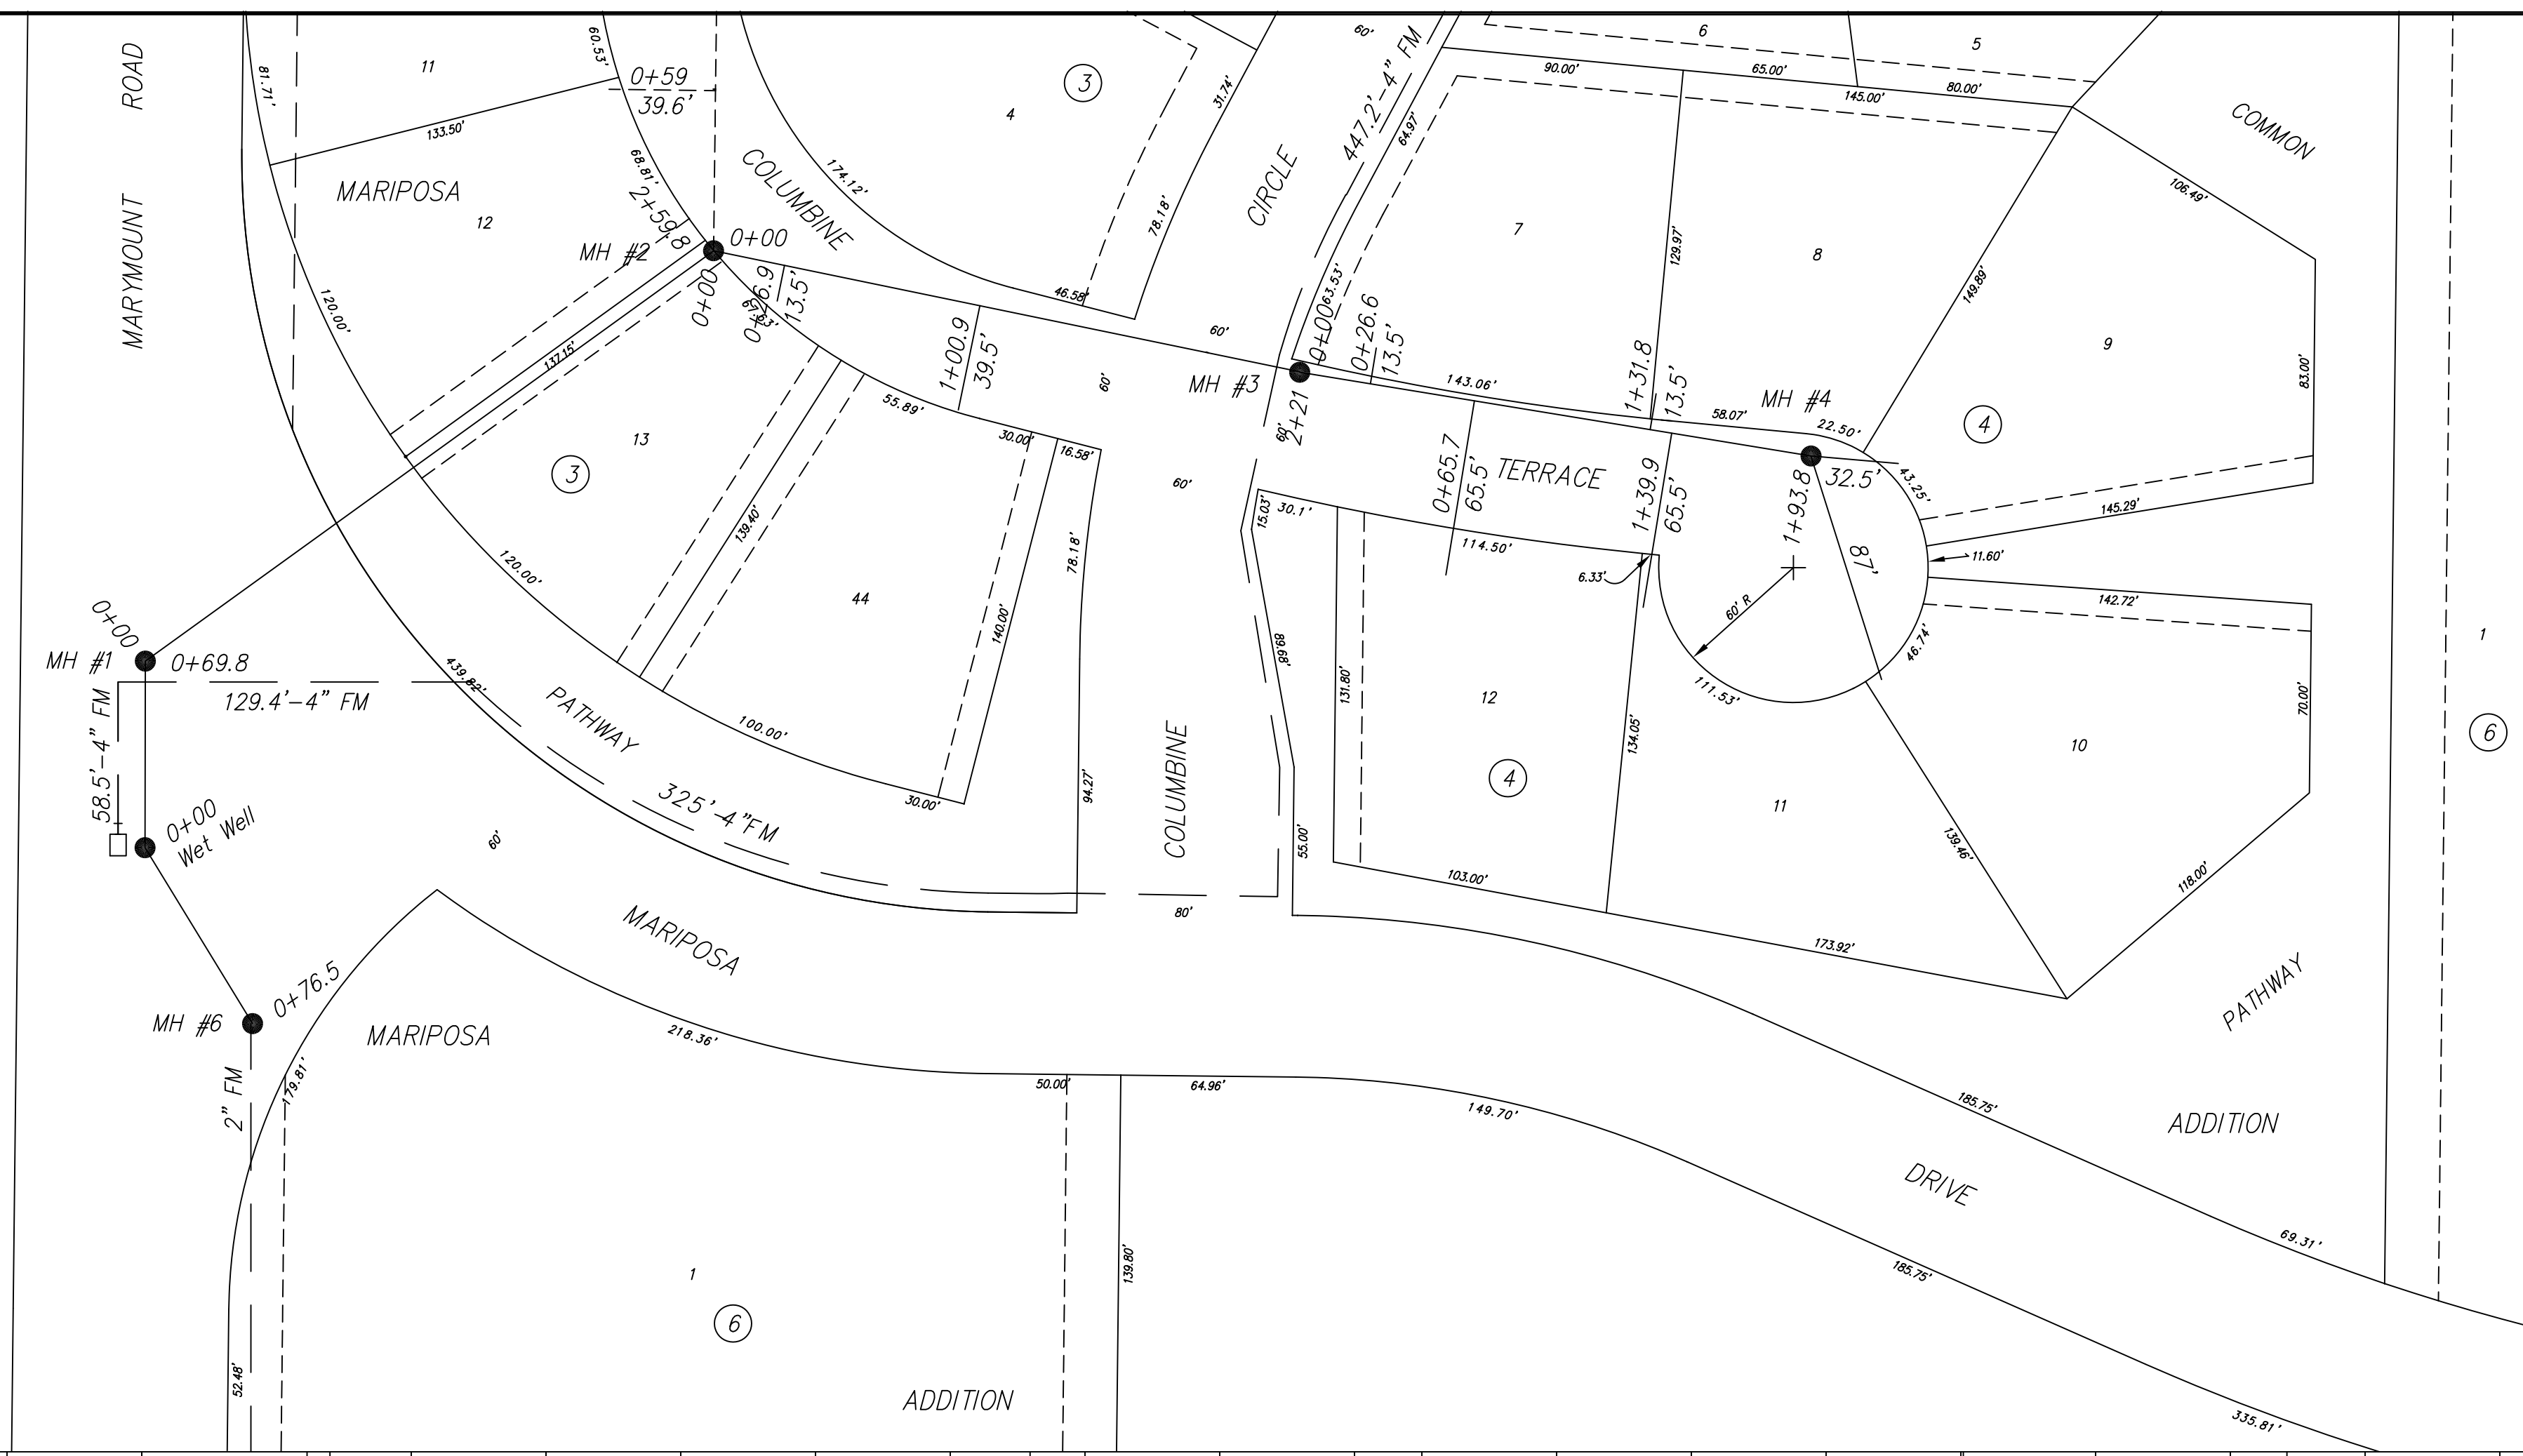
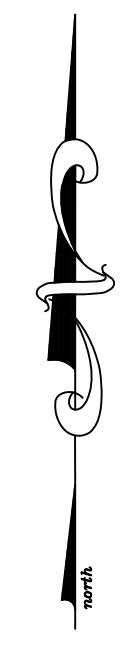
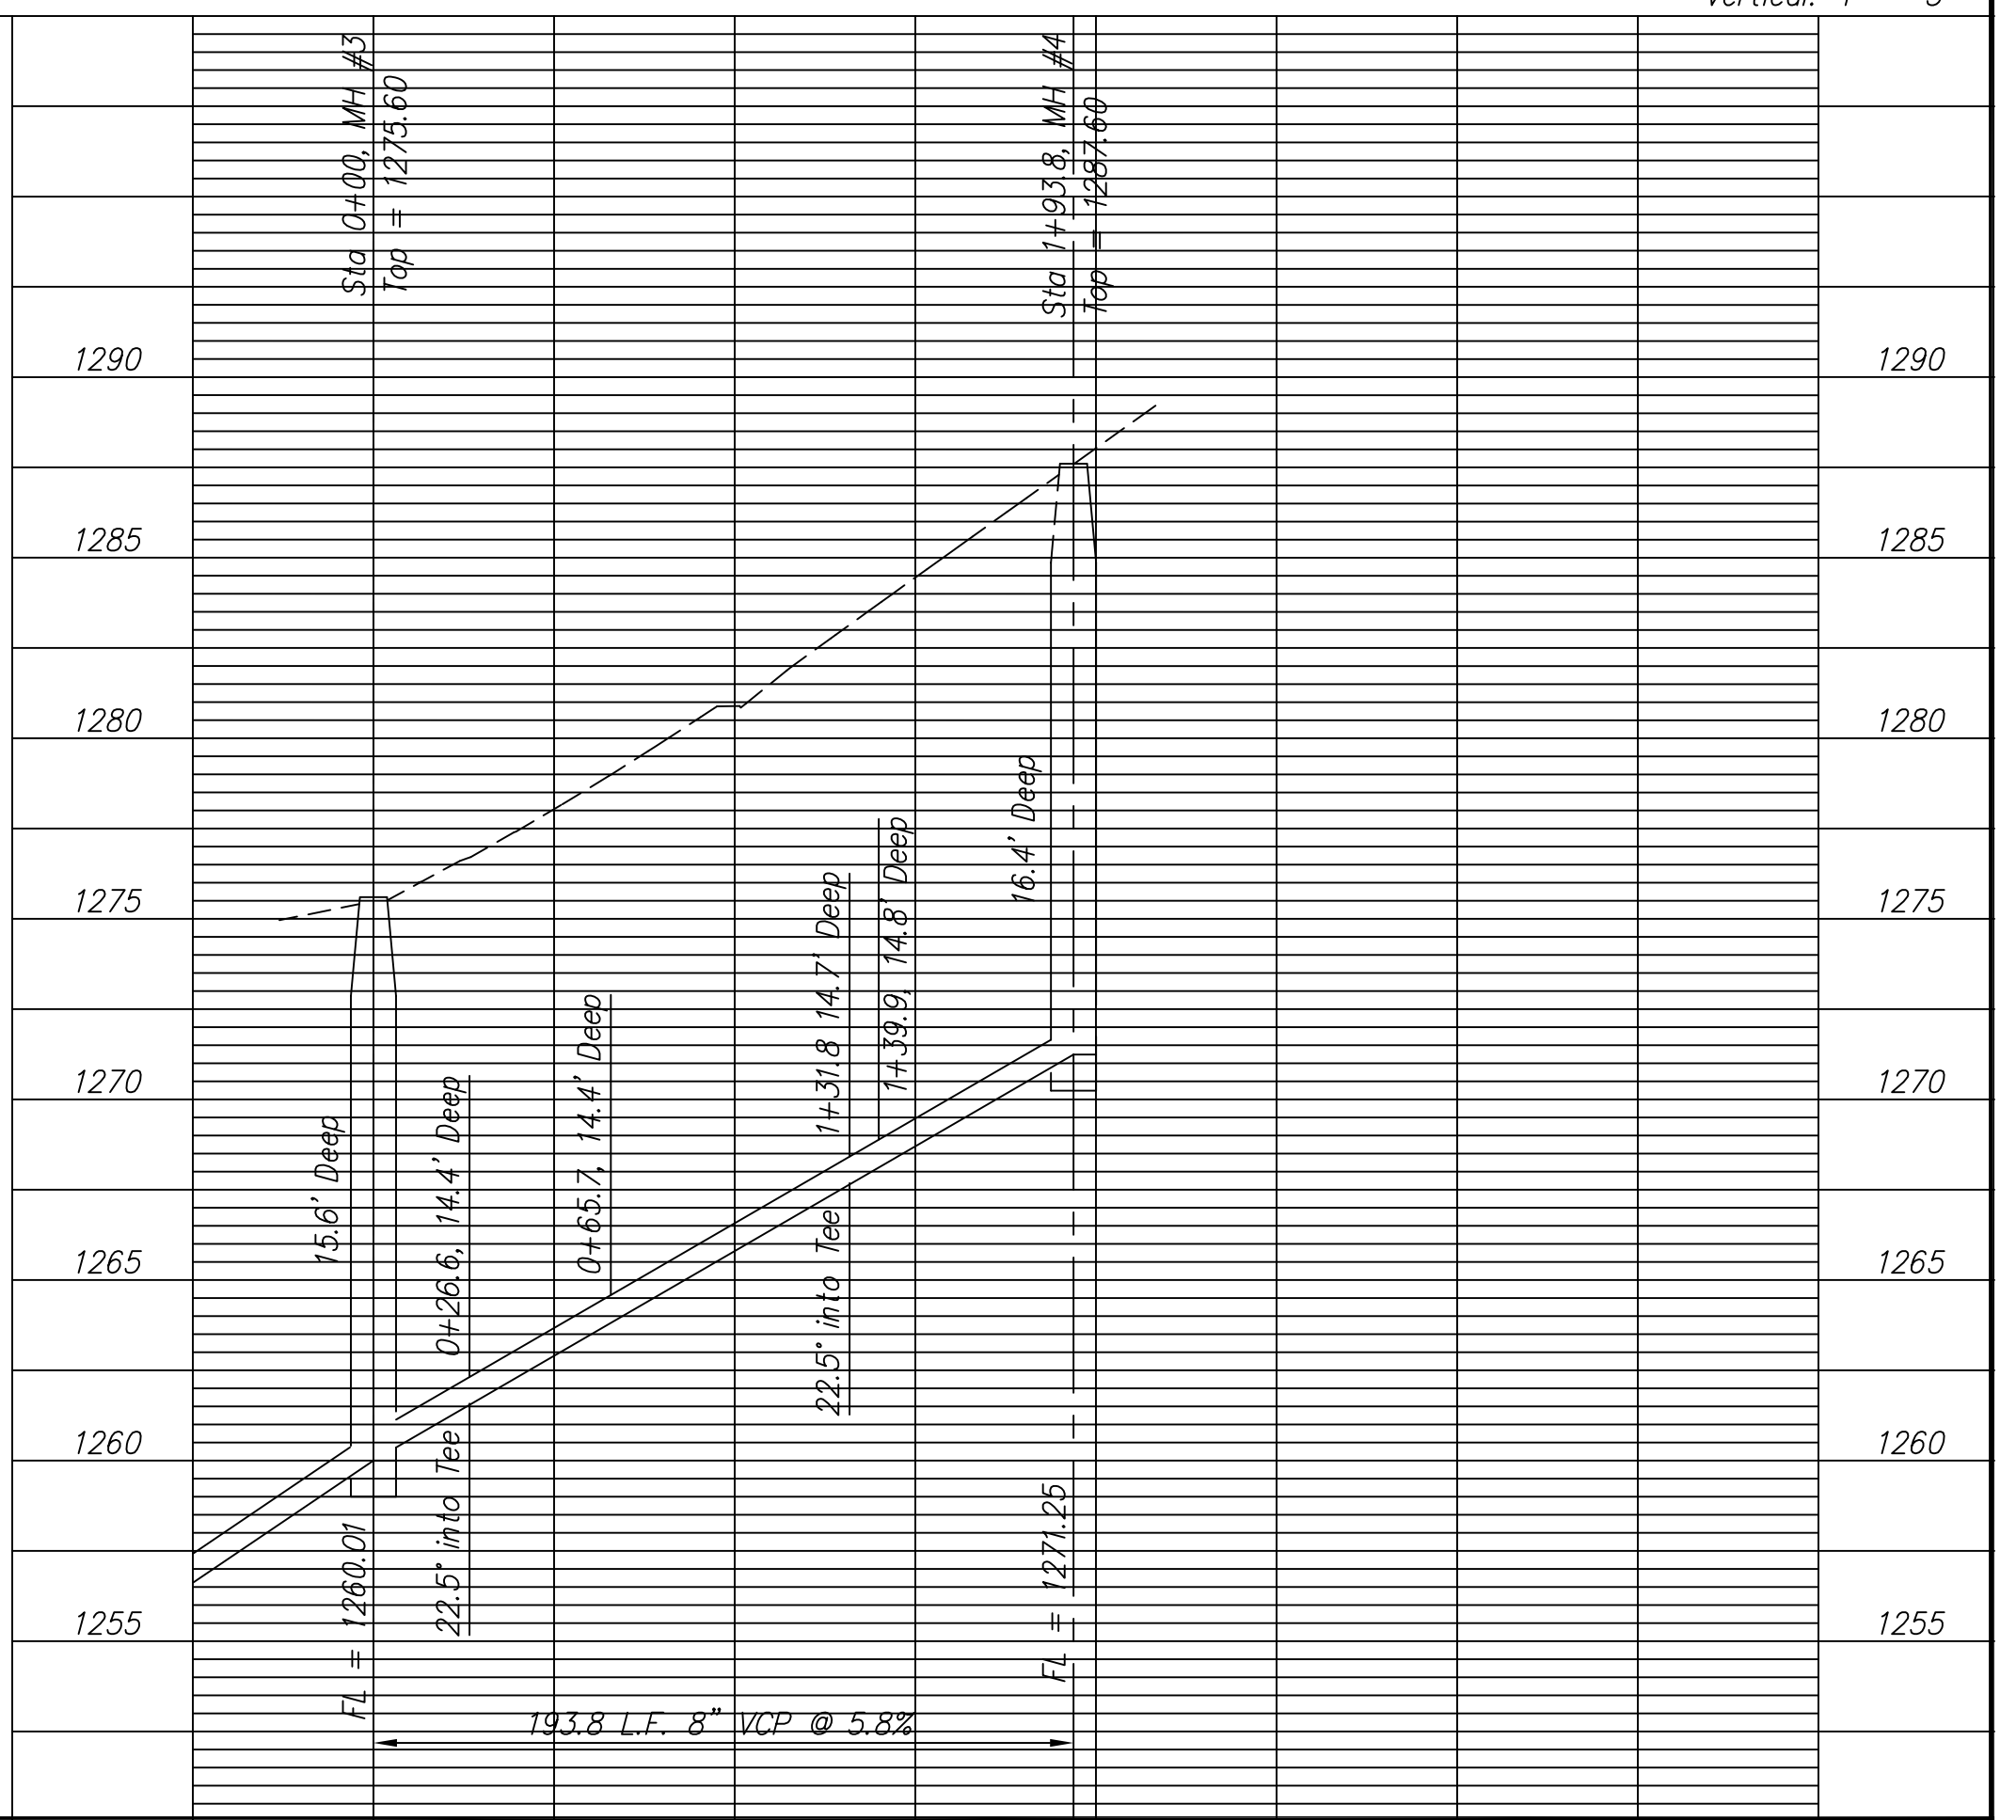


598

Mariposa Addition -  
Phase II  
Dec 1998

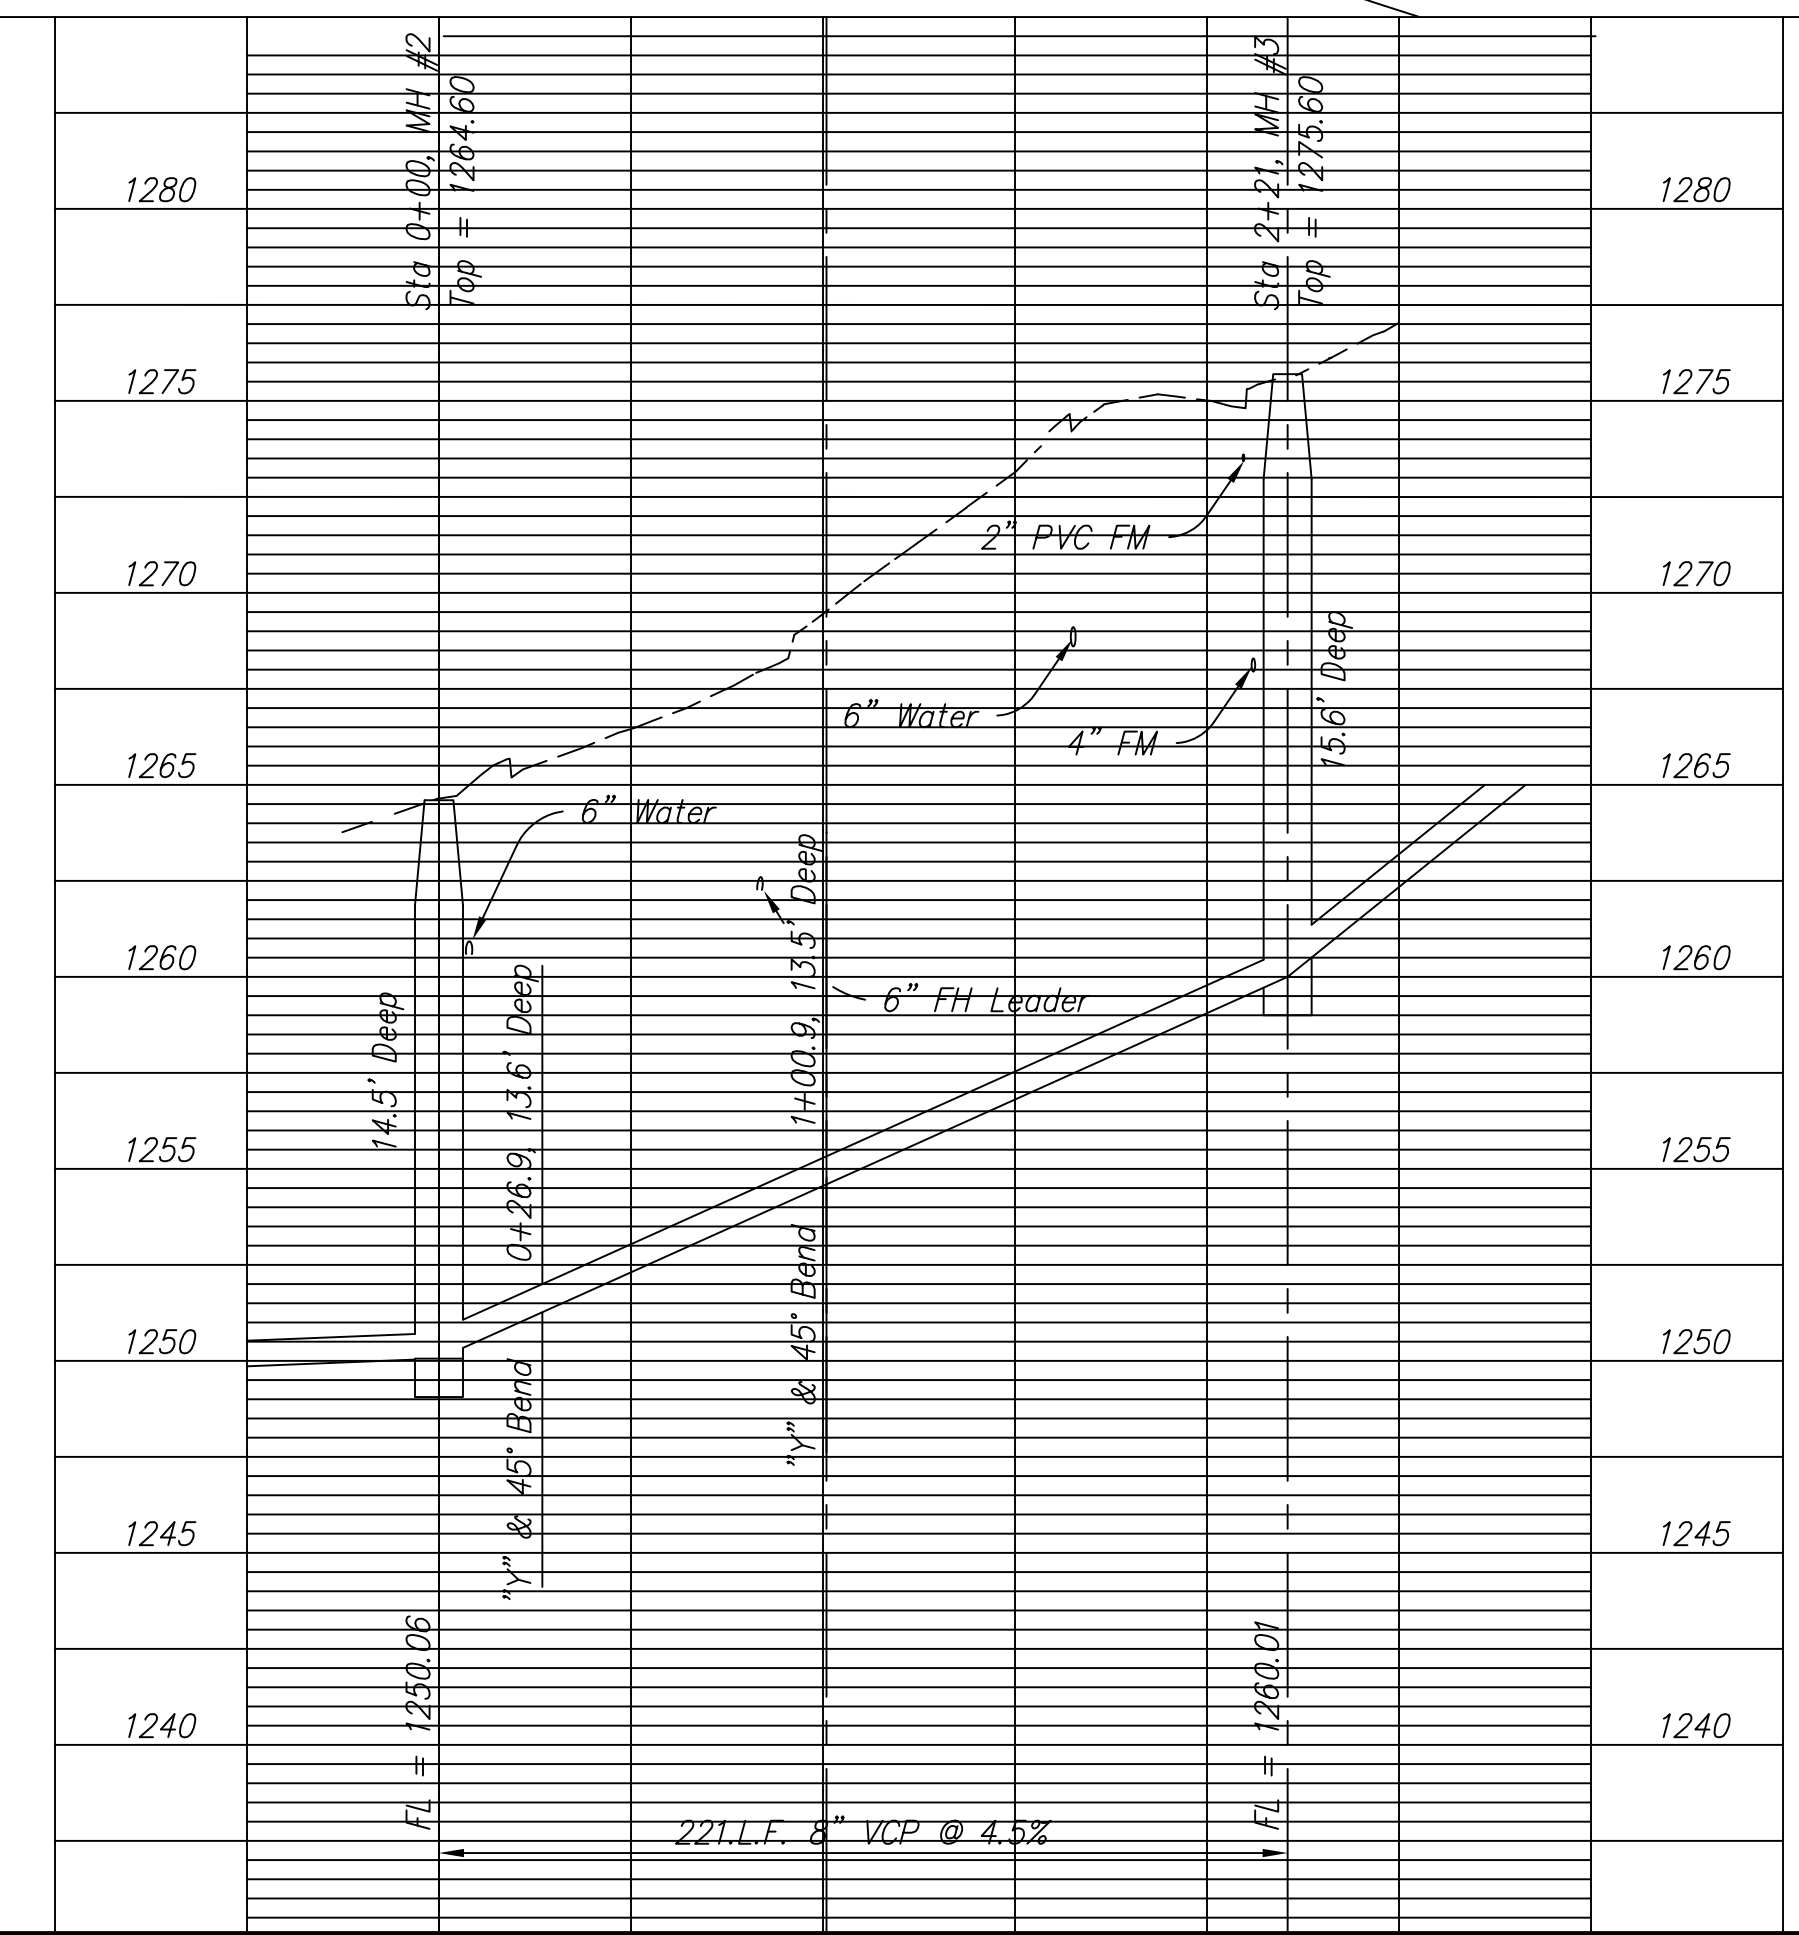

SCALE:  
Plan: 1" = 50'  
Profile -  
Horizontal: 1" = 50'  
Vertical: 1" = 5'

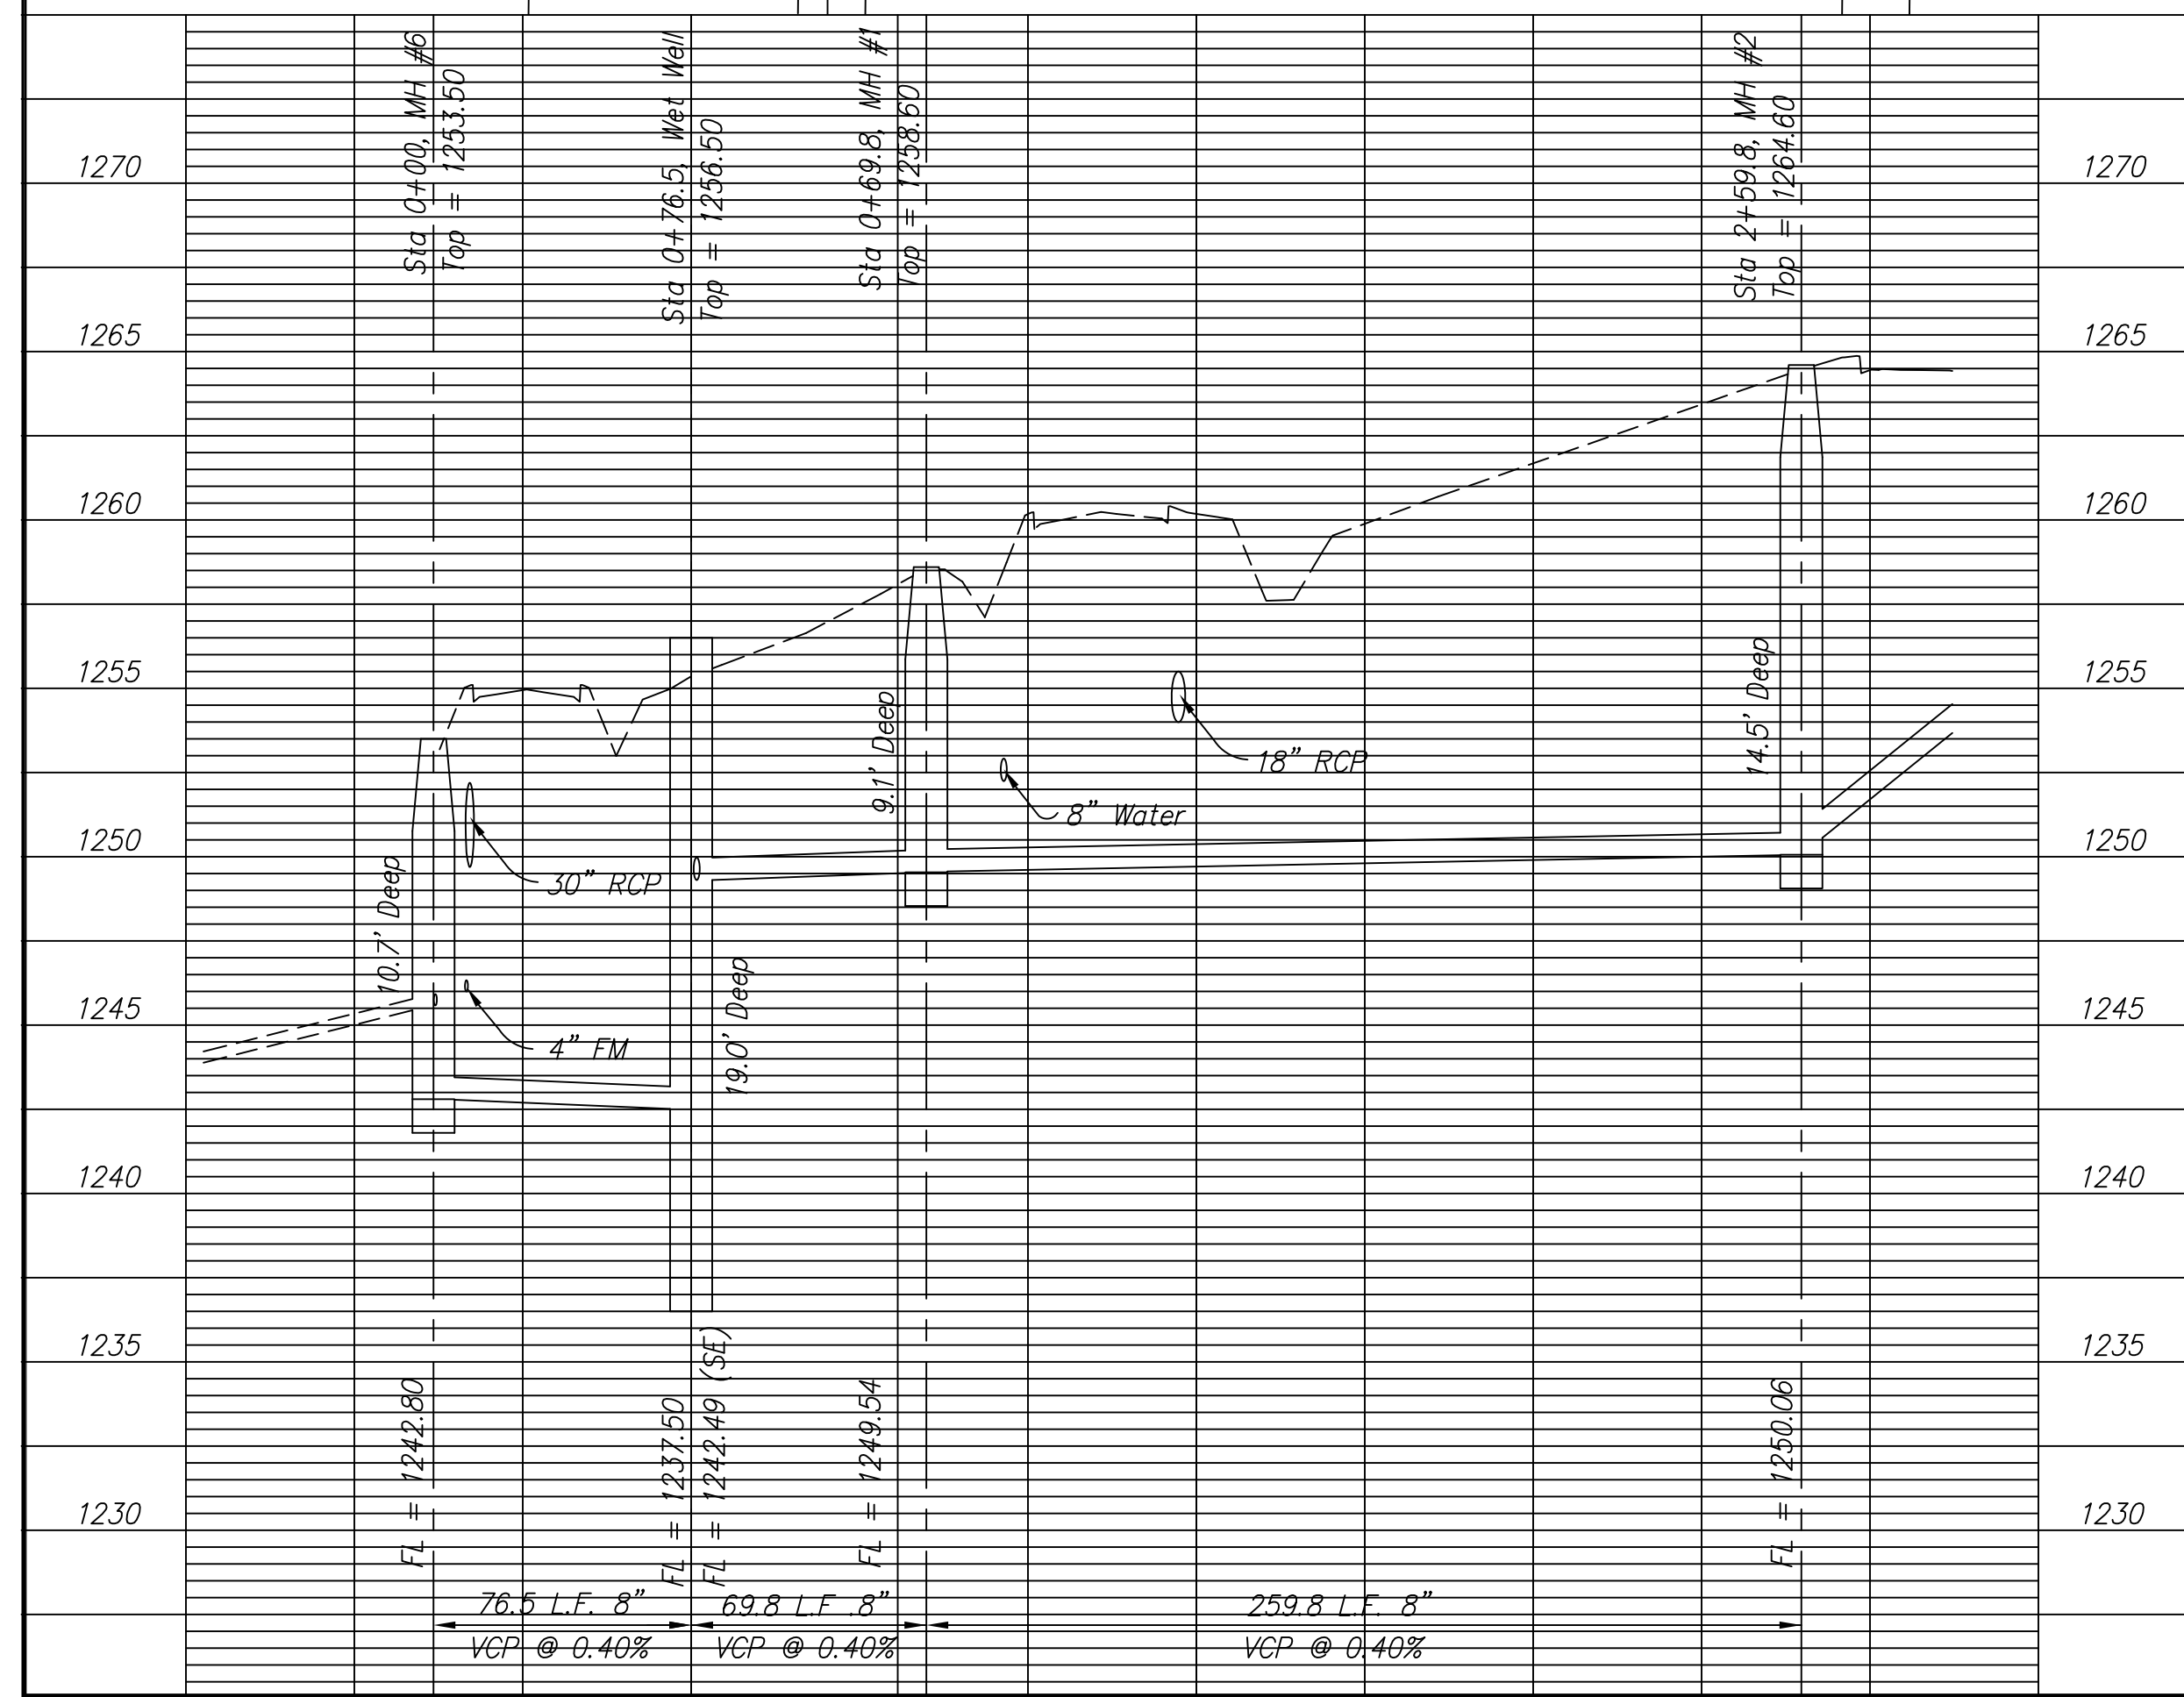

PROJECT TITLE:				CONSTRUCTED BY: Stevens Contractors Inc		SCALE: As Shown		DESIGN:		CHECKED:		CITY OF SALINA ENGINEERING DEPARTMENT 300 WEST ASH SALINA, KANSAS 67401 (913)826-7290		DATE: 18 Feb 98		PROJ. NO: 98-1137	
NO.	REVISIONS	DATE	BY	NO.	REVISIONS	DATE	BY	DRAWN:	APPROVED:	FILENAME:	SHEET:	OF:					