


River Trail Addition and Golden Eagle Estates Addition - Phase 3

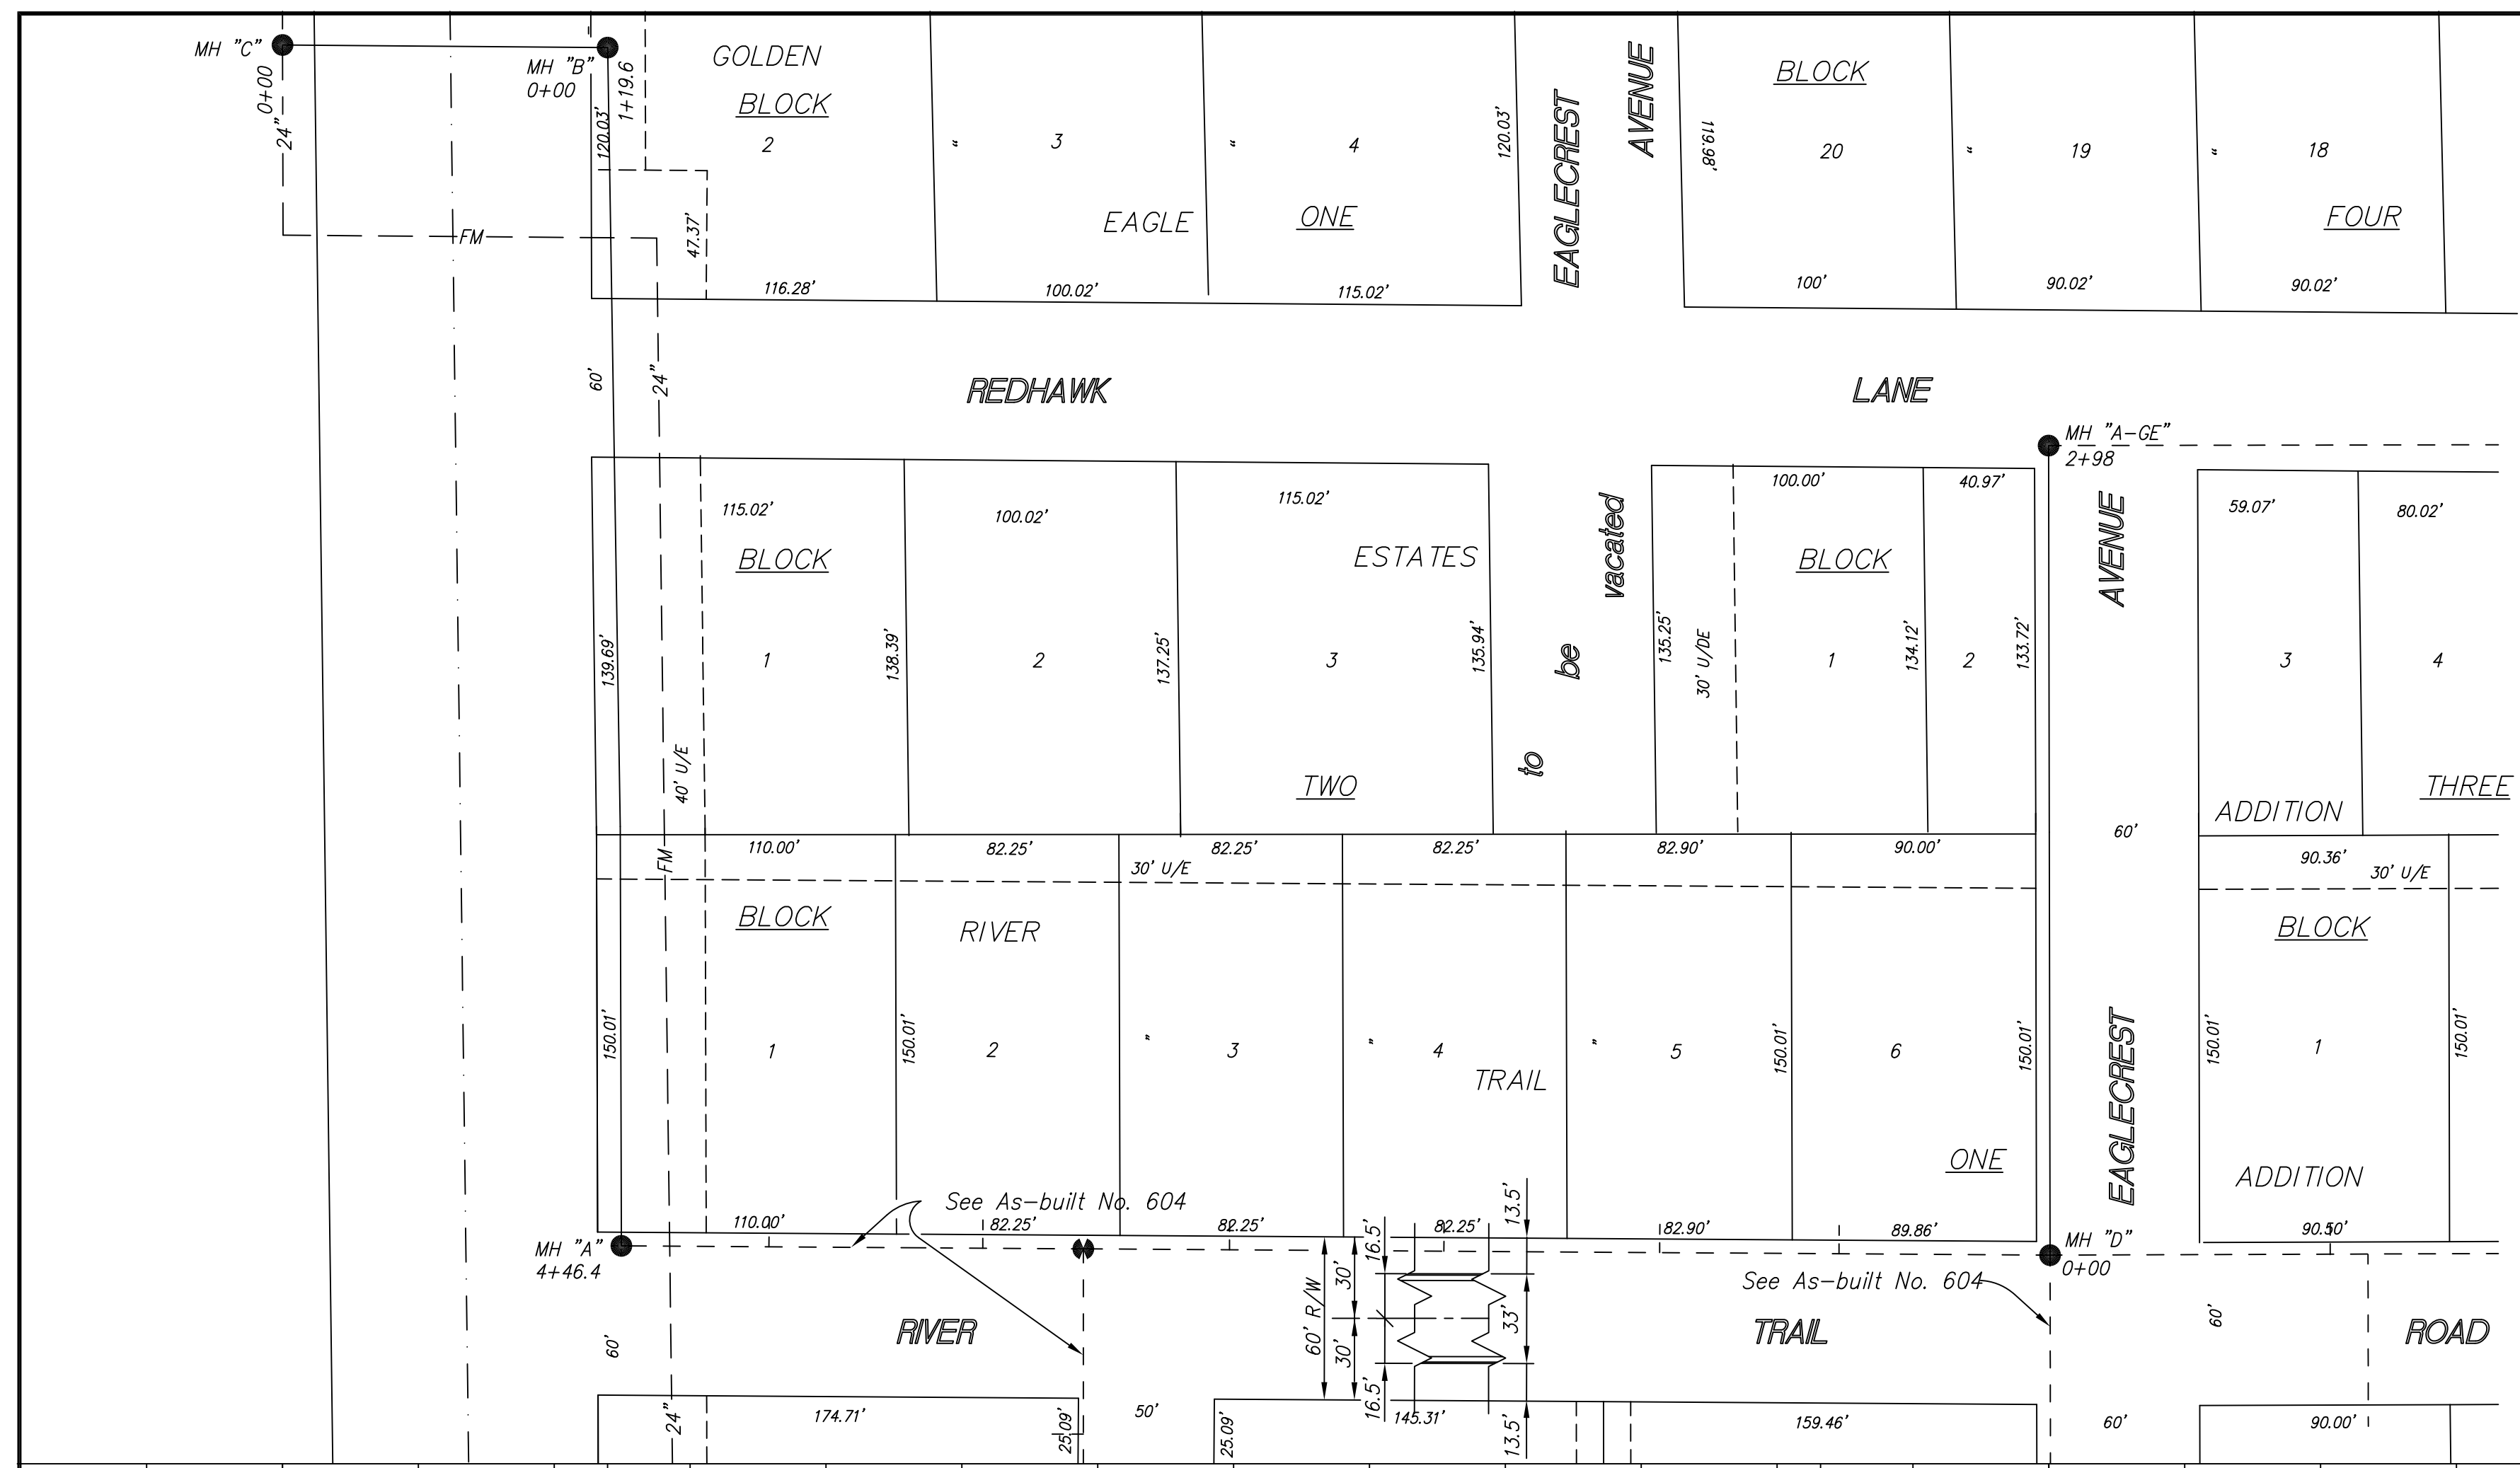


BM # 26L: Chiseled square SE corner of well diversion structure, Sta 130+99. Elev = 1245.67

NOTE: All Sanitary Sewer mains are 8" unless noted otherwise.

NOTE: Distance from back of curb to property line is based on the street being built in the center of the right-of-way.

NOTE: All Streets are 33' back to back of curb. Right-of-Ways are 60' unless noted otherwise.

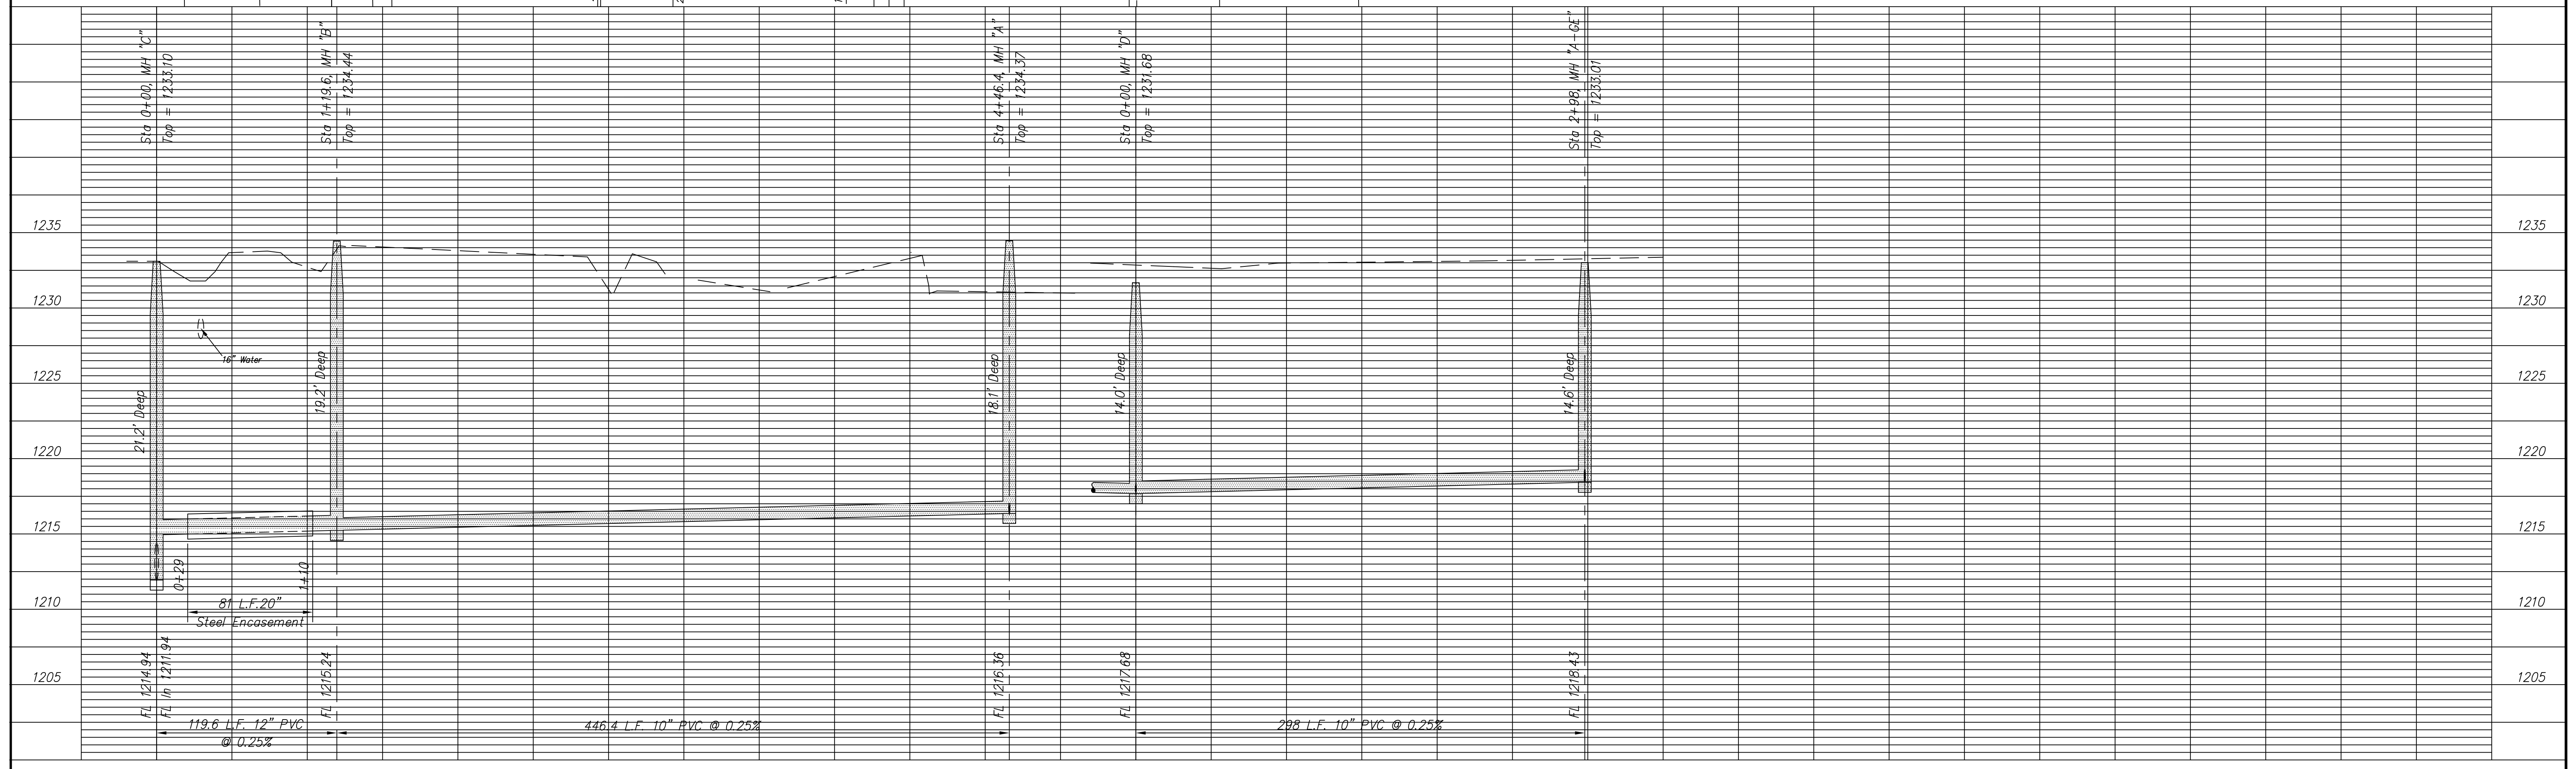

PROJECT TITLE			CONSTRUCTED BY:			SCALE: Plan: 1" = 50'			DESIGN:			CHECKED:			CITY OF SALINA			DATE: Jan 2000			PROJ. NO: 99-1180		
Sanitary Sewer As-Built Drawing			Smoky Hill Contractors			Profile -									ENGINEERING DEPARTMENT								
						Horizontal: 1" = 50'			DRAWN:			APPROVED:			300 WEST ASH			FILENAME: 605.dwg			SHEET: OF:		
						Vertical: 1" = 5'									SALINA KANSAS 67401								
															(913)826-7290								
NO. REVISIONS			DATE BY			NO. REVISIONS			DATE BY			NO. REVISIONS			DATE BY			NO. REVISIONS			DATE BY		