

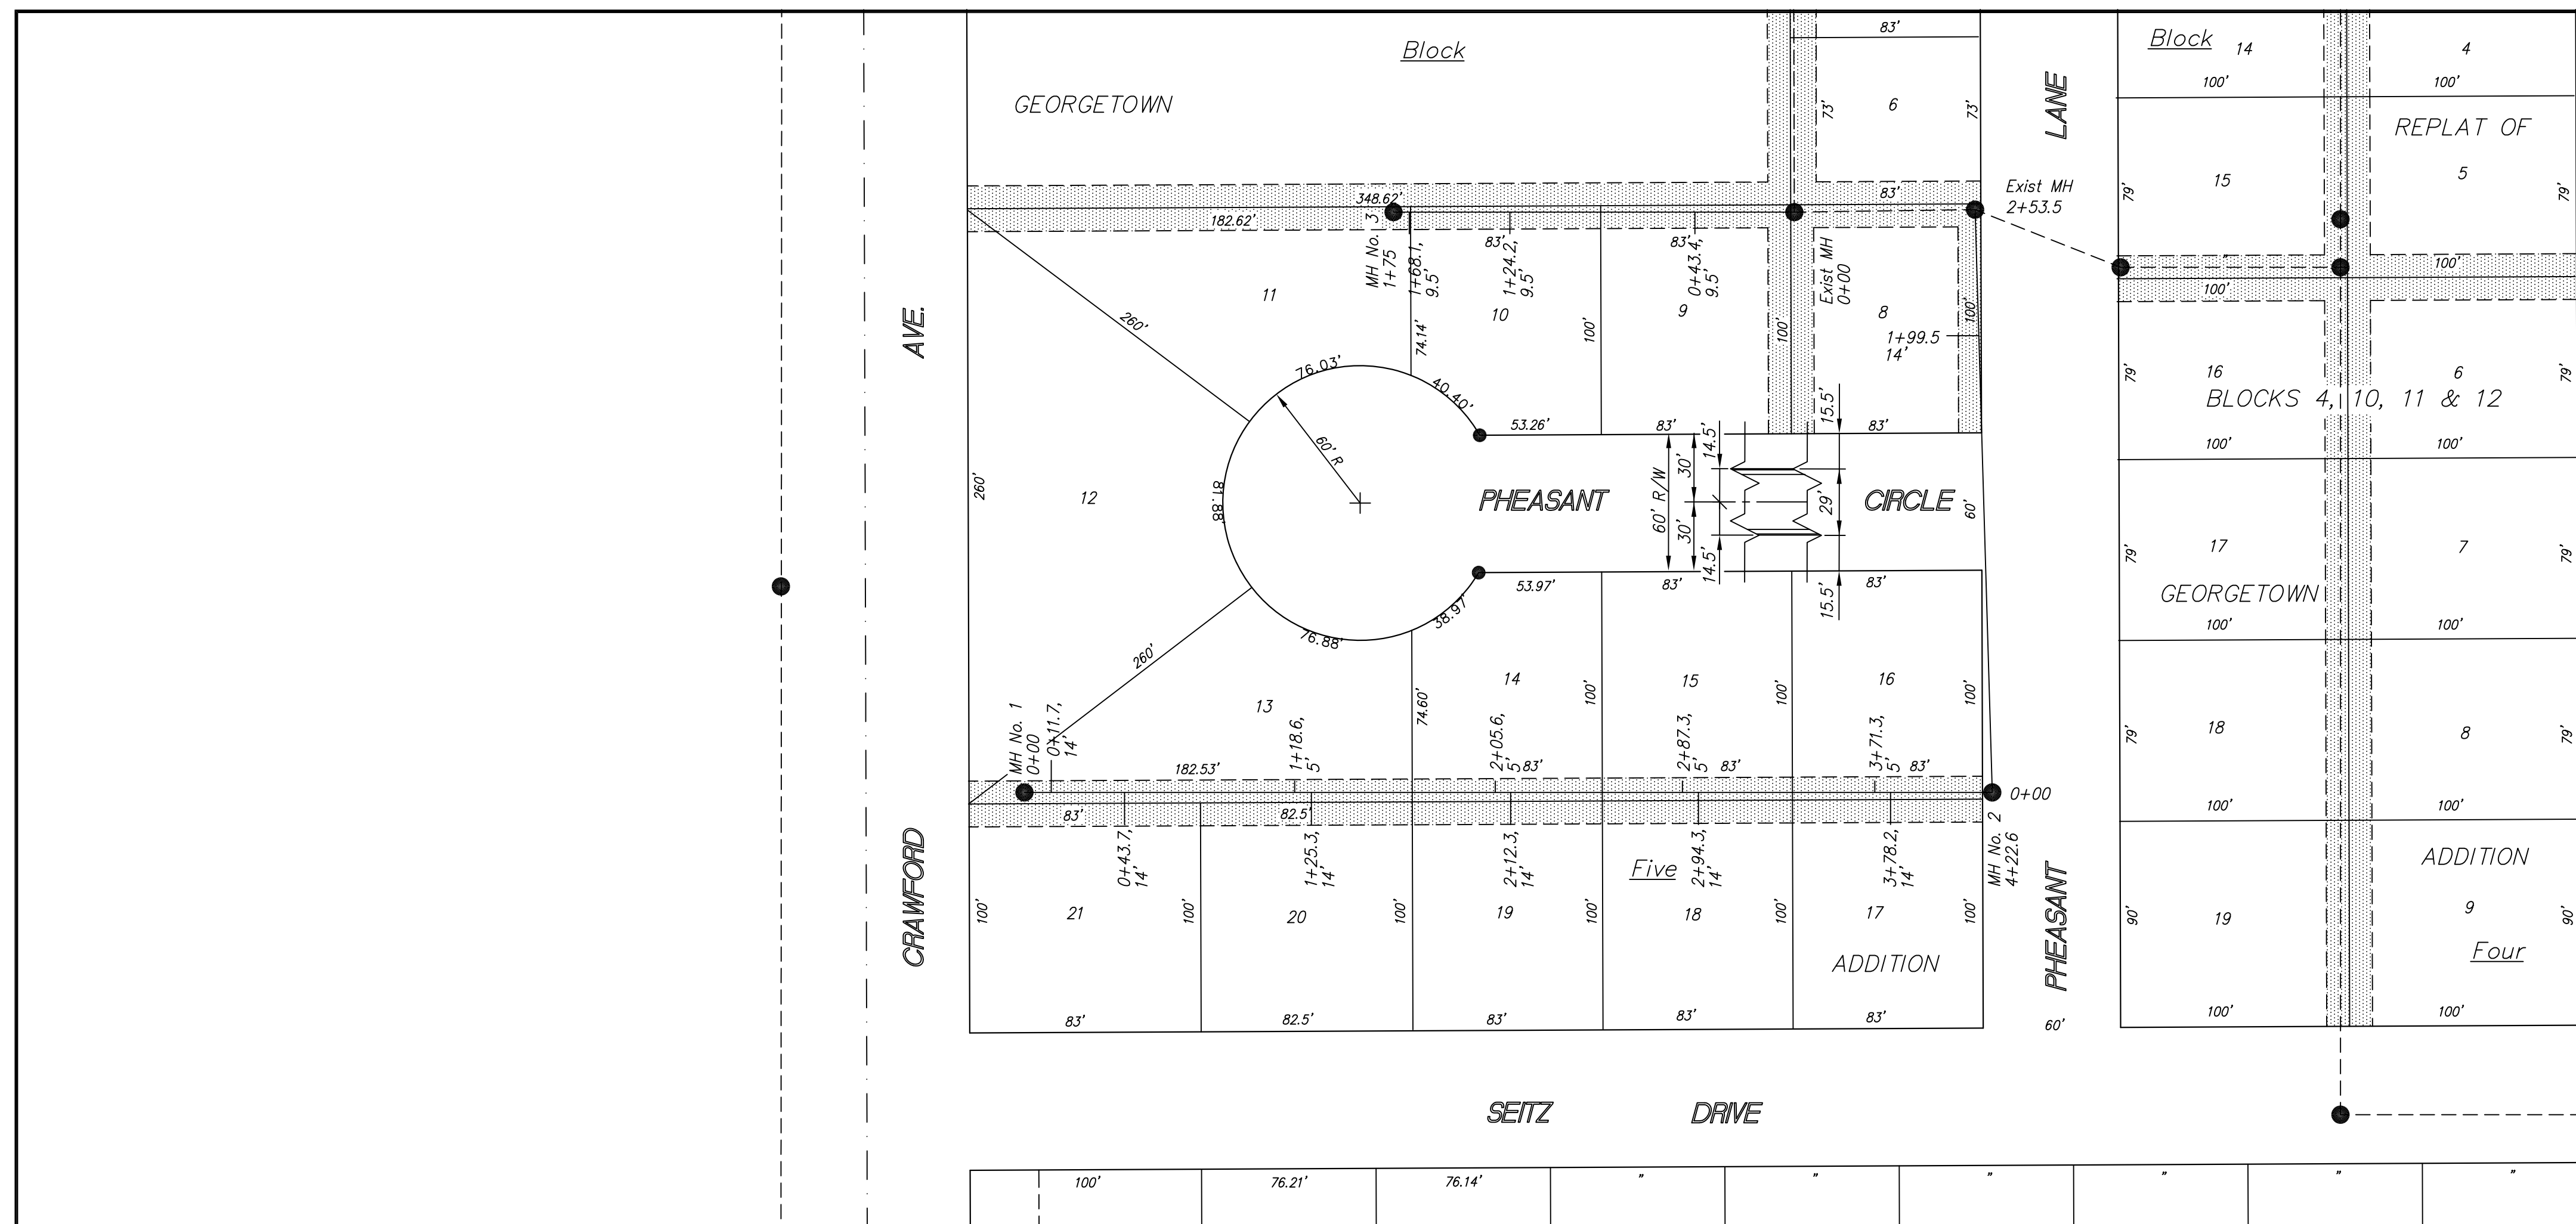


608

Georgetown Addition
Phase 2
Feb. 2000

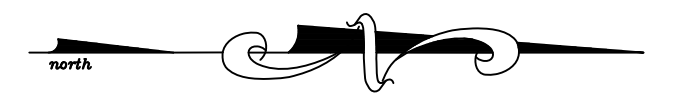

NOTE: All Sanitary Sewer mains are 8" Unless Noted Otherwise.
NOTE: Distance from back of curb to property line is based on the street being built in the center of the right-of-way.
NOTE: All Streets are 33' back to back of curb and Right-of-Ways are 60' Unless Noted Otherwise.

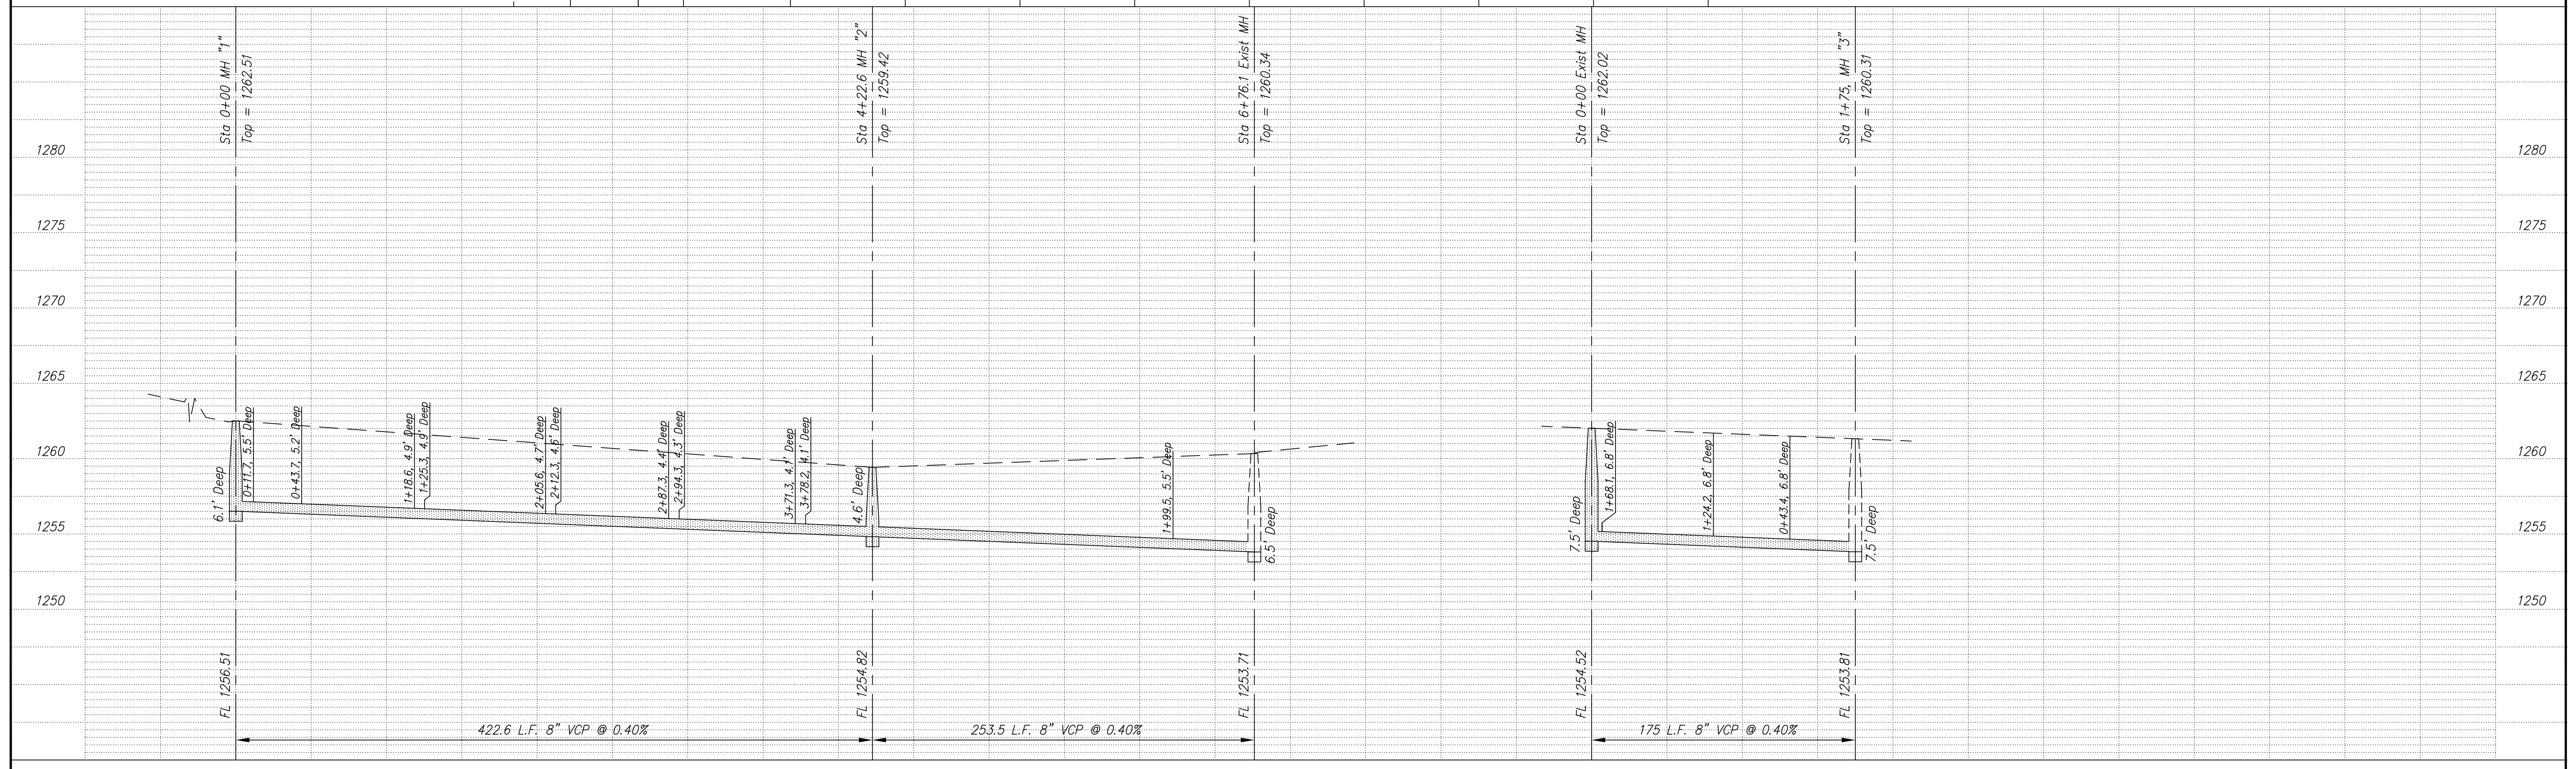

NO.	REVISIONS	DATE	BY

PROJECT TITLE
Sanitary Sewer As-Built Drawing

CONSTRUCTED BY:
Stevens Contractors, Inc.

SCALE: Plan: 1" = 50'
Profile: 1" = 50'
Horizontal: 1" = 50'
Vertical: 1" = 5'

DESIGN:
CITY OF SALINA
ENGINEERING DEPARTMENT
300 WEST ASH SALINA, KANSAS 67401
(913)826-7290

CHECKED:
APPROVED:
DATE: Feb 2000
FILENAME: 608.dwg
PROJ. NO.: 99-1198
SHEET: OF: