
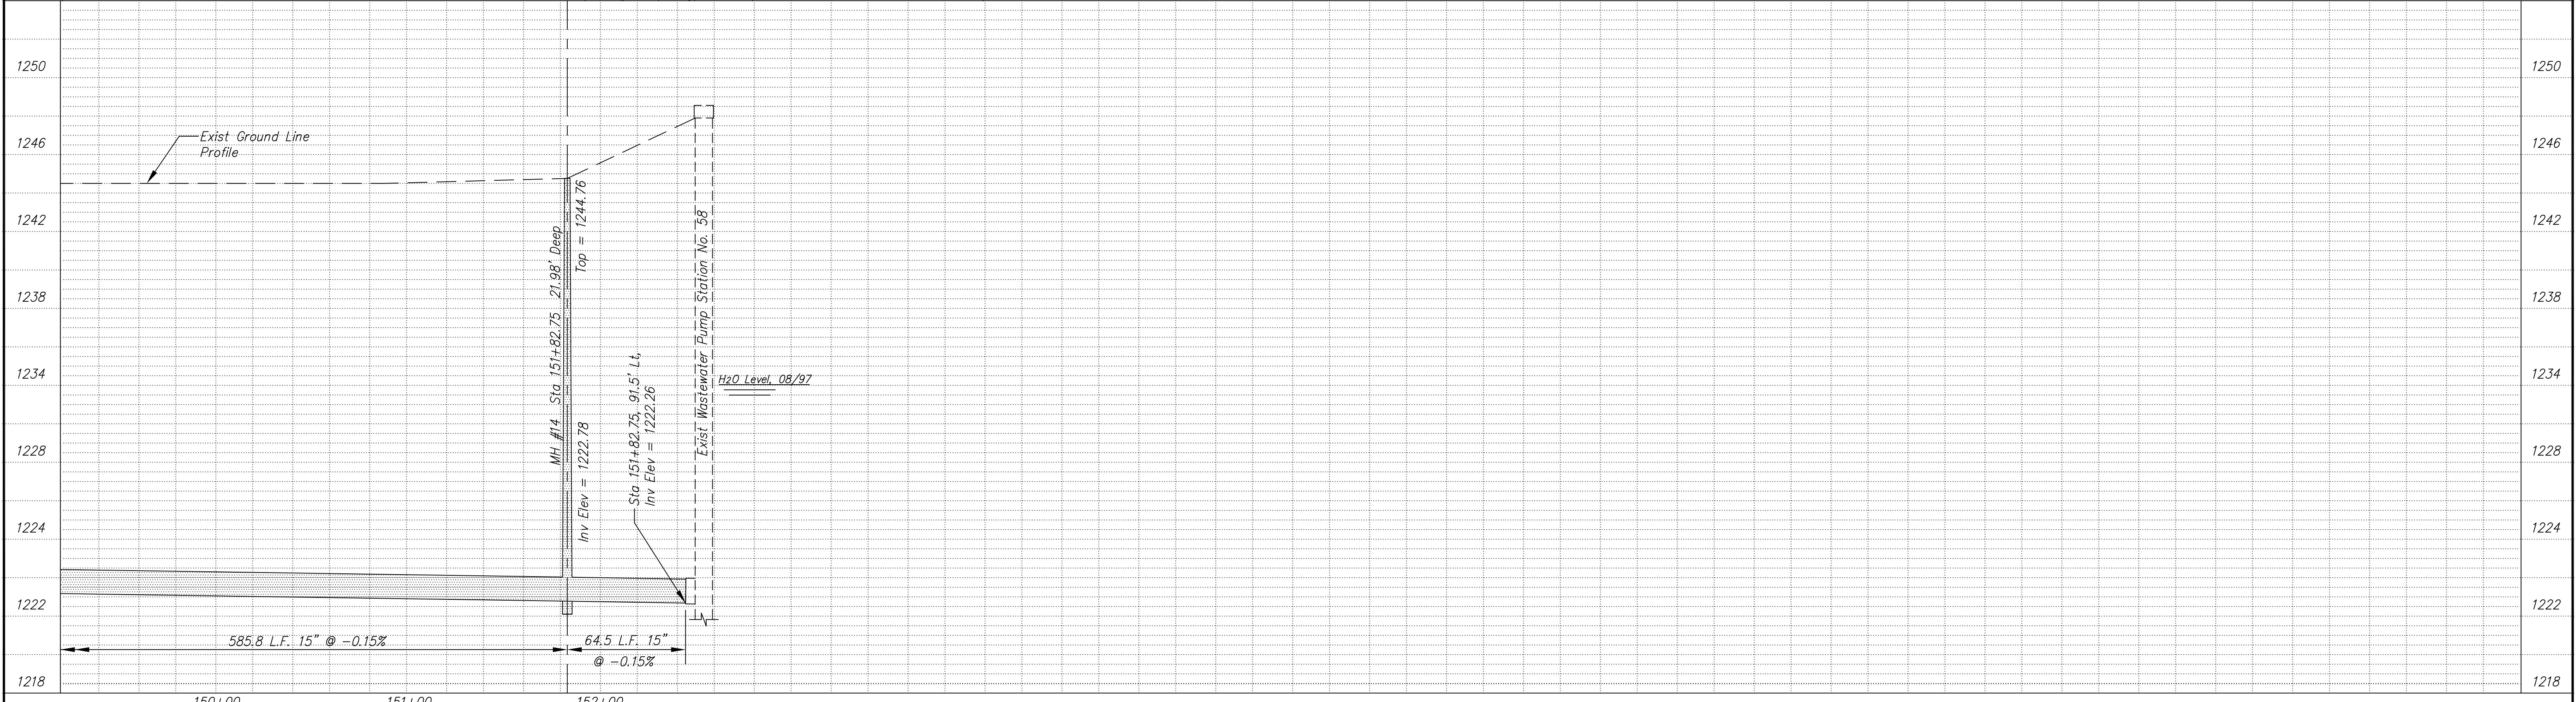


609

South Ninth St.
Utility Improvements
Aug. 1999

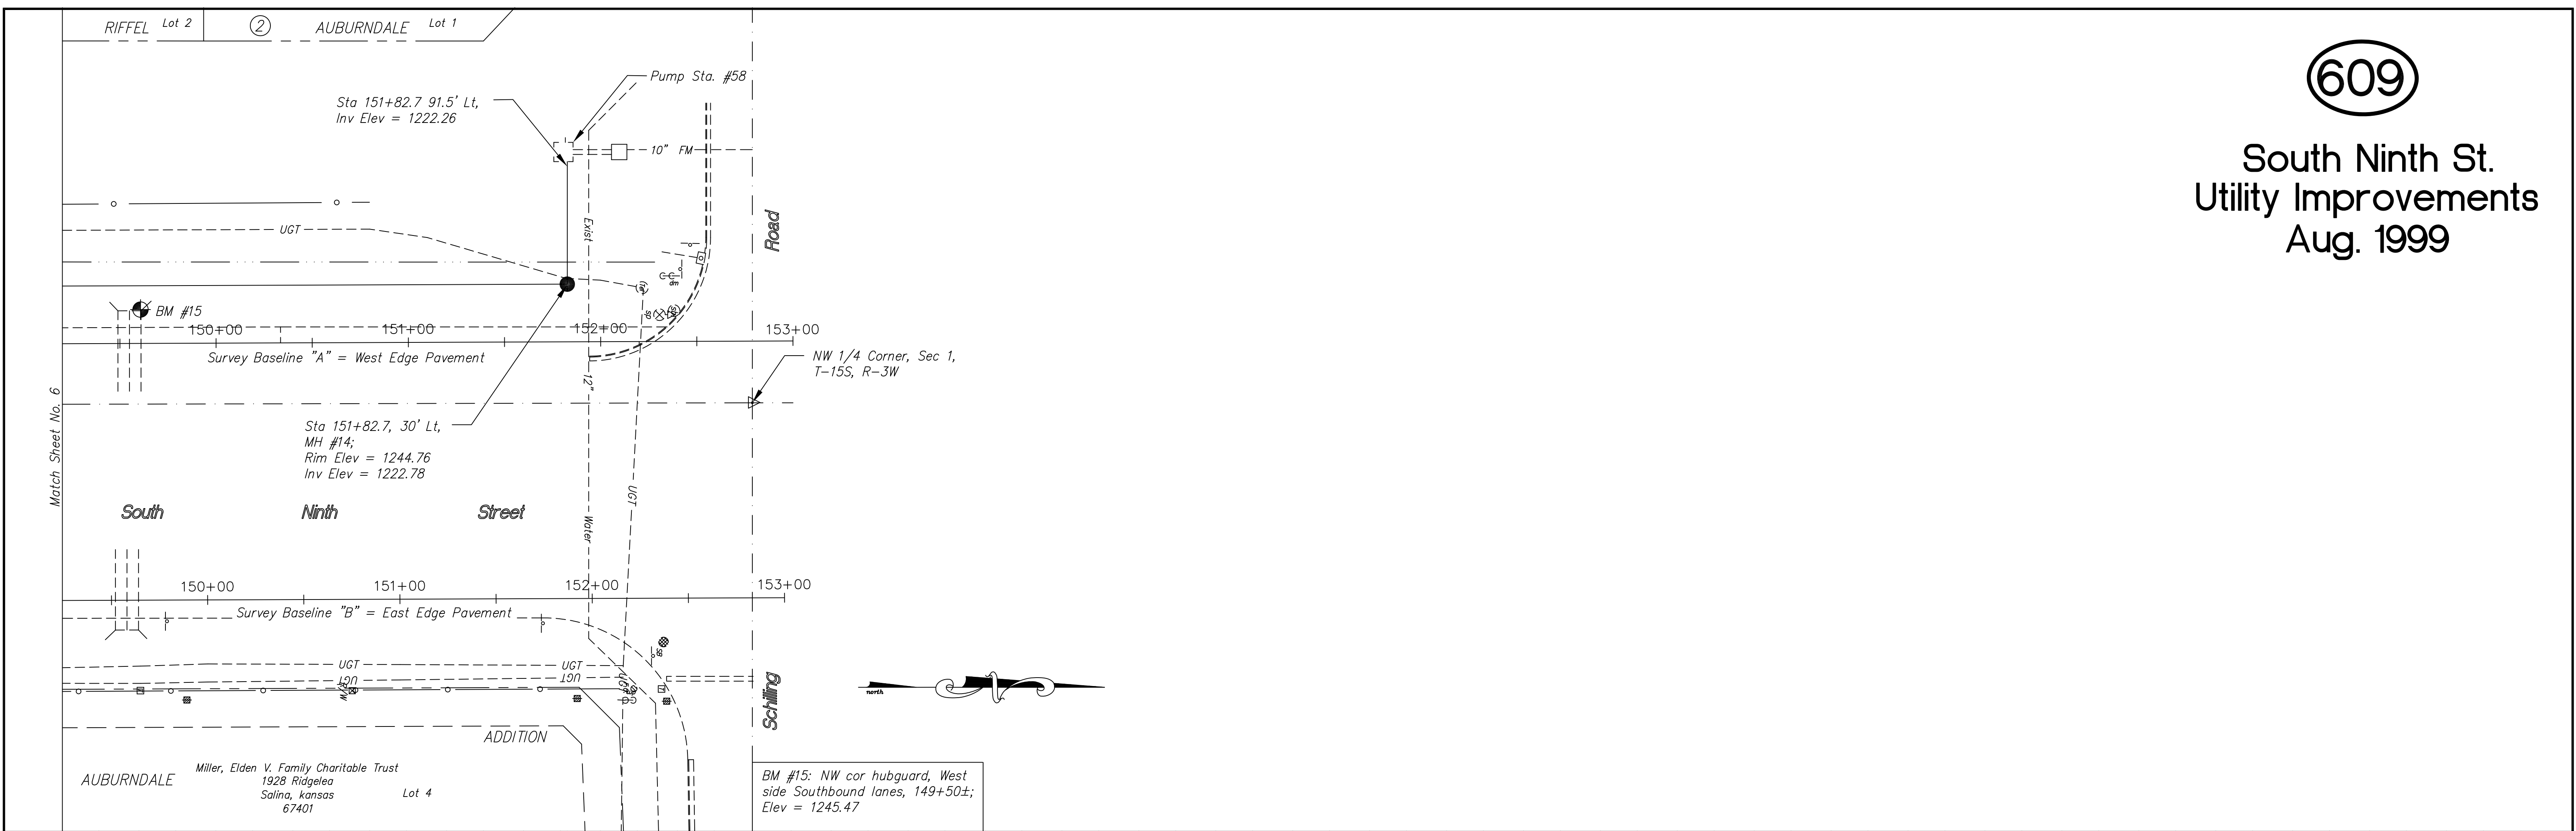

PROJECT TITLE: Sanitary Sewer As-Built Drawing						CONSTRUCTED BY: Stevens Contractors, Inc		SCALE: Plan: 1" = 40' Profile: 1" = 40' Vert, 1" = 4'		DESIGN: KWD		CHECKED: DK		CITY OF SALINA ENGINEERING DEPARTMENT 300 WEST ASH SALINA, KANSAS 67401 (913)826-7290		DATE: Aug 99		PROJ. NO.: 98-1134	
NO.		REVISIONS		DATE		BY		NO.		REVISIONS		DATE		BY		FILENAME: 609r13.dwg		SHEET: OF	