
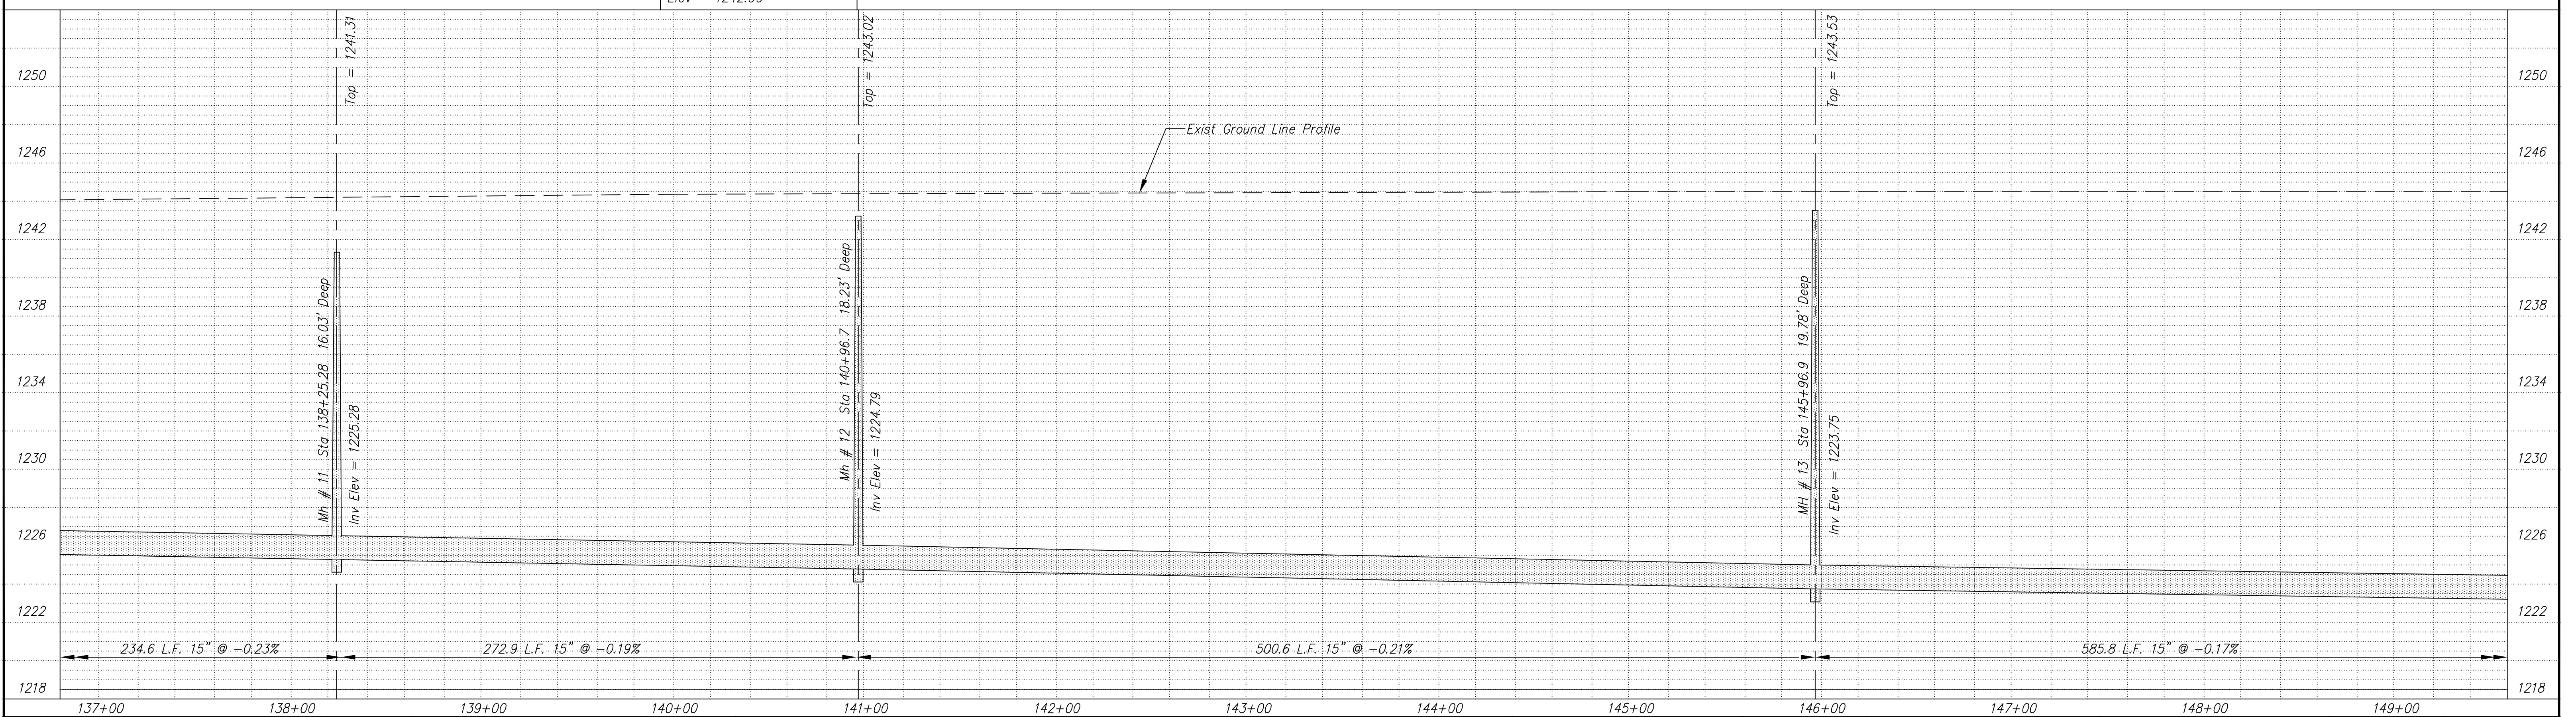


610

South Ninth St. Utility Improvements Aug. 1999

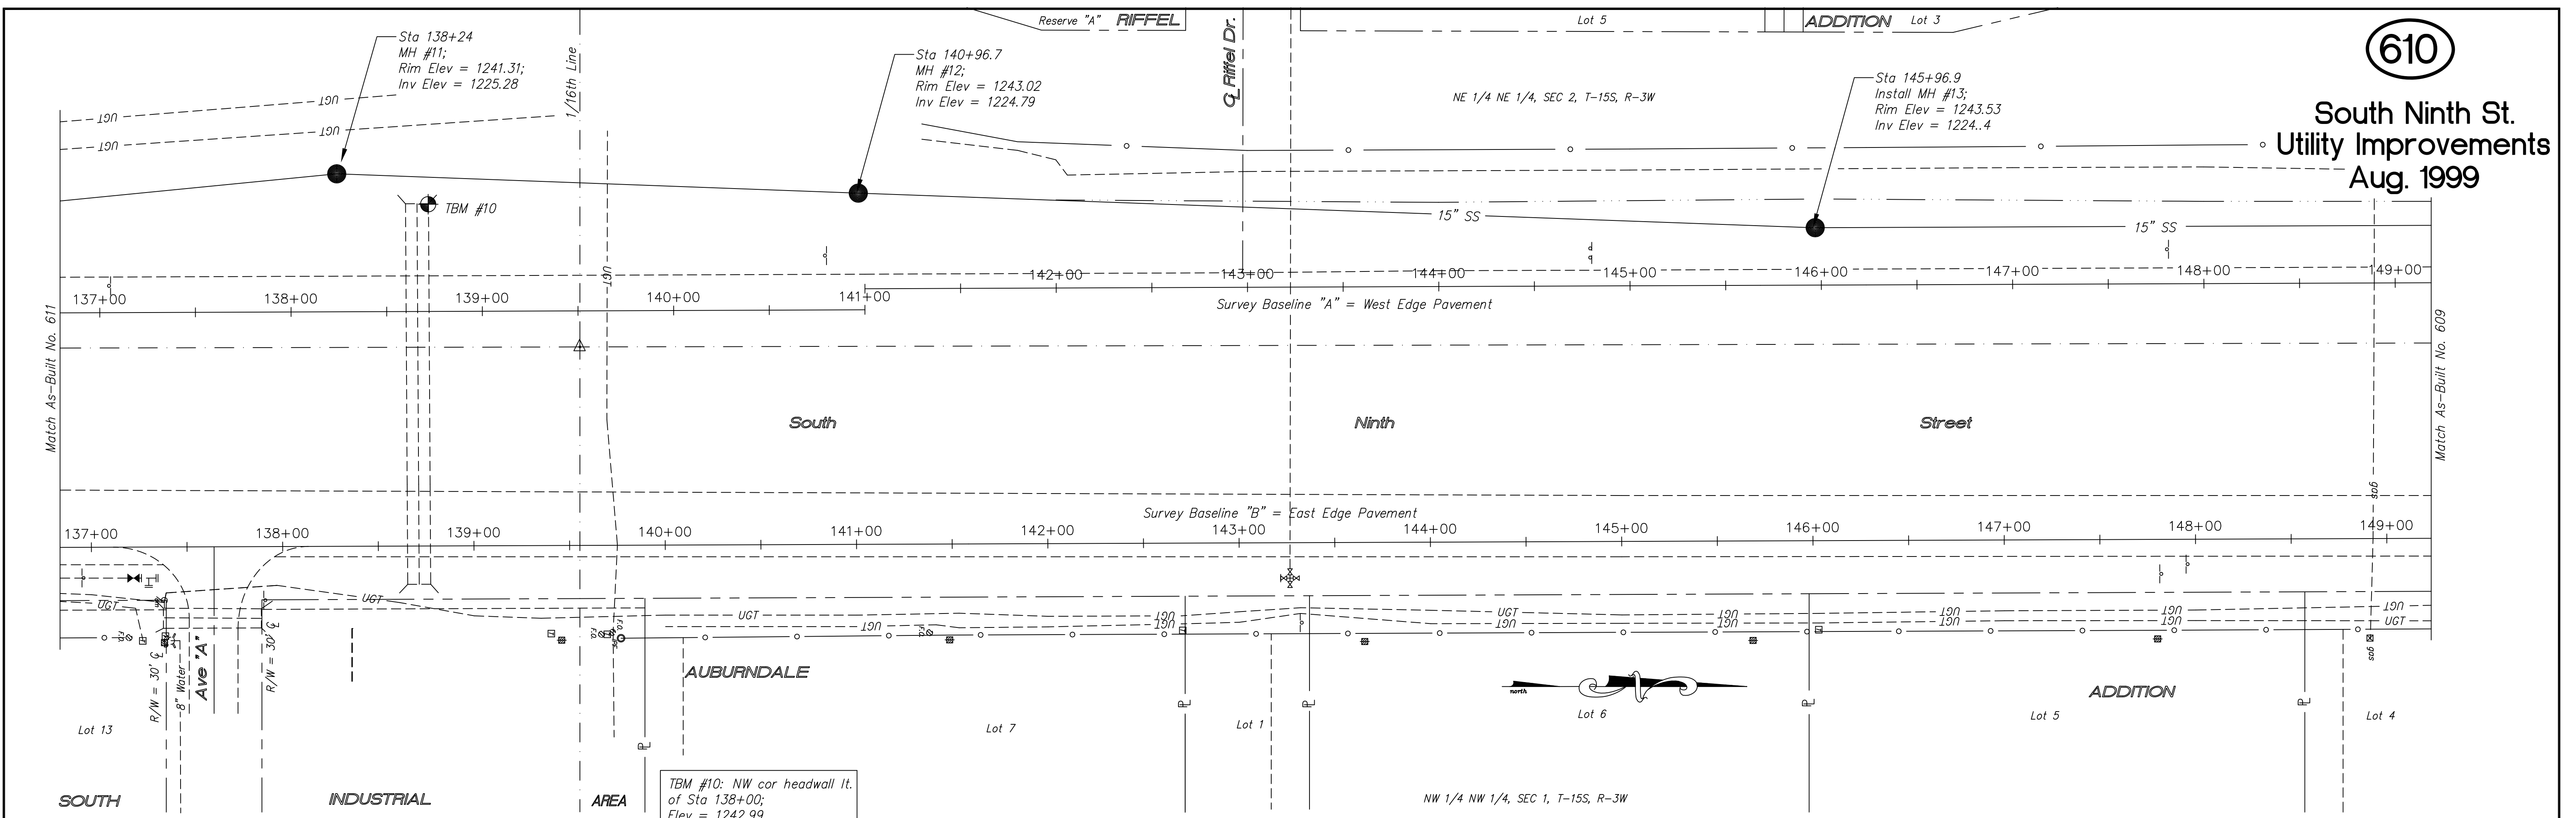

NO.	REVISIONS	DATE	BY

PROJECT TITLE: **Sanitary Sewer As-Built Drawing**

CONSTRUCTED BY: **STEVENS CONTRACTORS**

SCALE: PLAN: 1" = 40'
PROFILE: 1" = 40'
Vert. 1" = 4'

DESIGN: **KWD**
DRAWN: **KWD**

CHECKED:
APPROVED:

CITY OF SALINA
ENGINEERING DEPARTMENT
300 WEST ASH SALINA, KANSAS 67401
(913)828-7290

DATE: **Aug 99**
FILENAME: **610r13.dwg**
PROJ. NO.: **98-1134**
SHEET: **OF**