


BM No. 282: "+ " cut at  $\angle$  Markley Rd and  $\angle$  Cloud St  
Elev = 1329.83

NOTE: All Sanitary Sewer mains are 8" unless noted otherwise. Sanitary Sewer services are 4" unless noted otherwise.

NOTE: Distance from back of curb to property line is based on the street being built in the center of the right-of-way.

NOTE: All Streets are 33' back to back of curb Right-of-Ways are 60' unless noted otherwise.

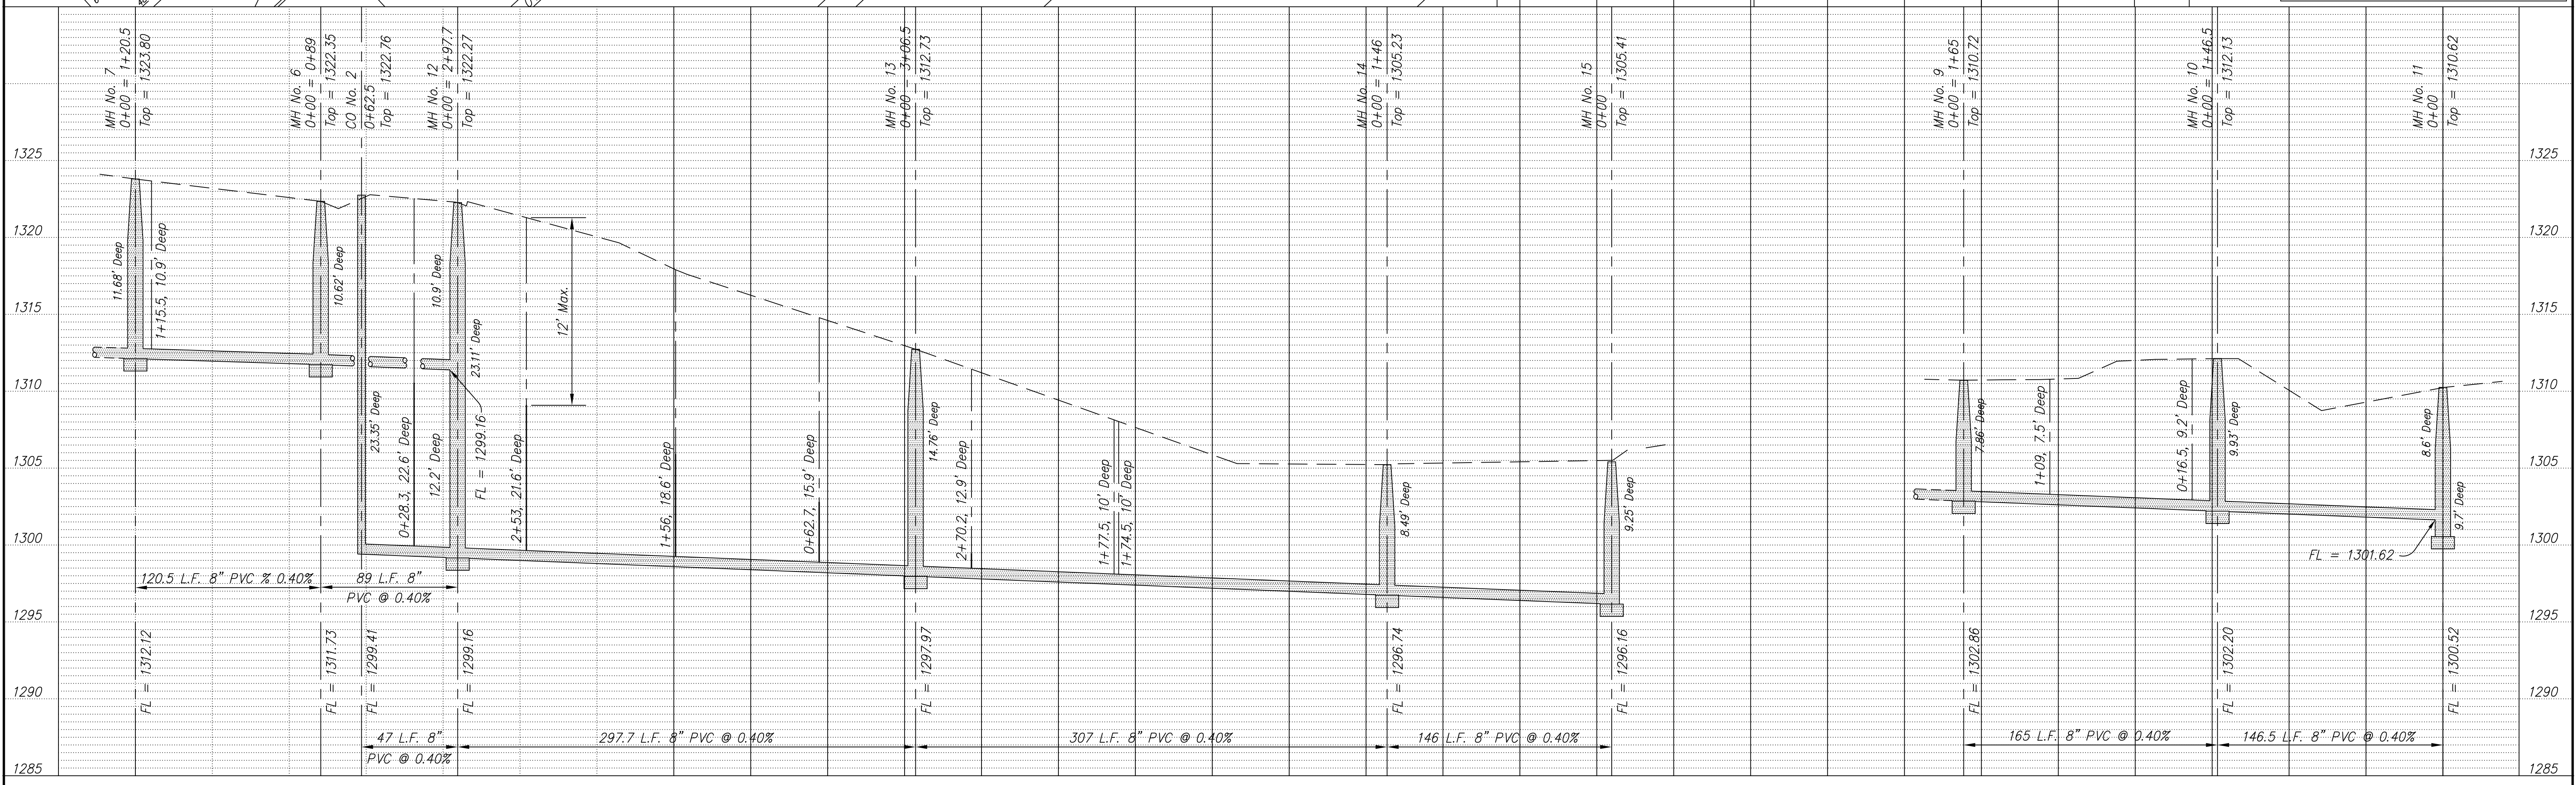

NO.	REVISIONS	DATE	BY

PROJECT TITLE:  
**Sanitary Sewer As-Built Drawing**

CONSTRUCTED BY:  
Stevens Contractors

SCALE:  
Plan: 1" = 50'  
Profile: Horiz. 1" = 50'  
Vert. 1" = 5'

DESIGN:  
DRAWN: KWD

CHECKED:  
APPROVED:

**CITY OF SALINA**  
ENGINEERING DEPARTMENT  
300 WEST ASH SALINA, KANSAS 67401  
(913)826-7290

DATE:  
Feb 2001

PROJ. NO.:  
Built Private  
SHEET: OF: