
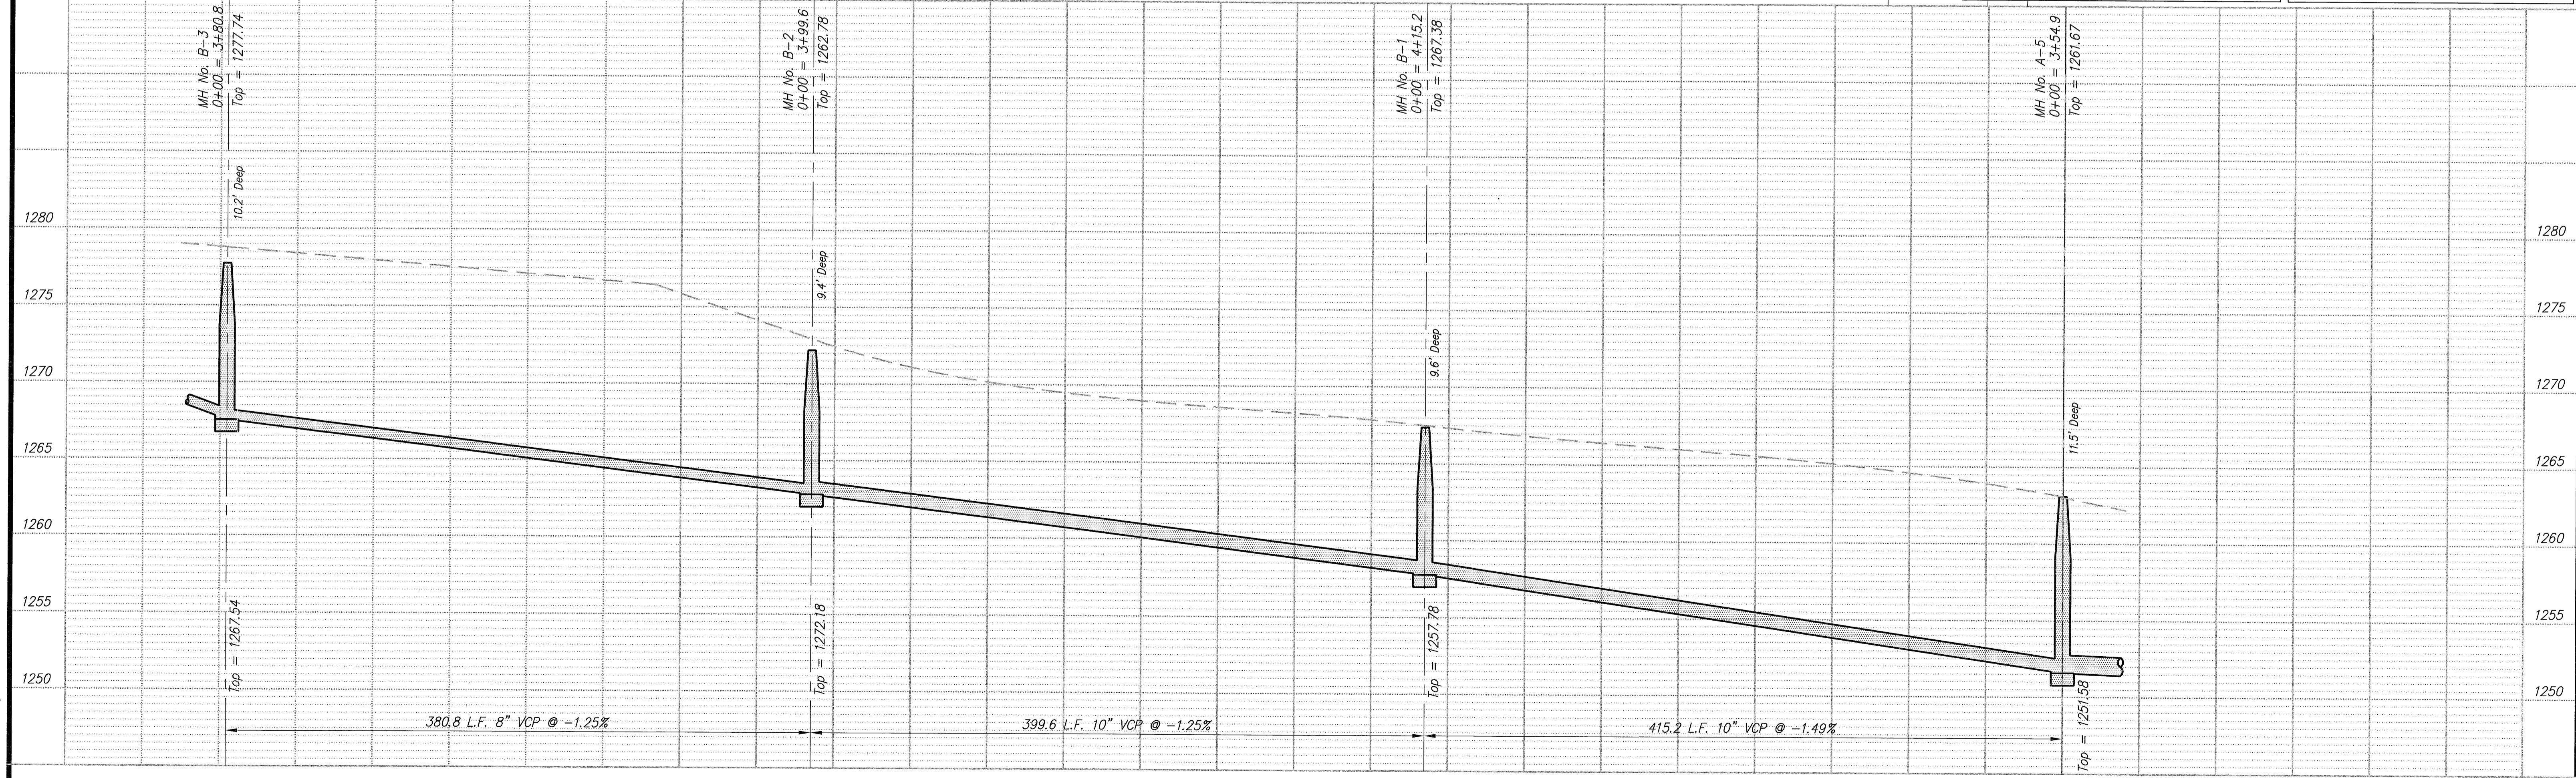


628

Airport Industrial Center Subdivision
April 2001

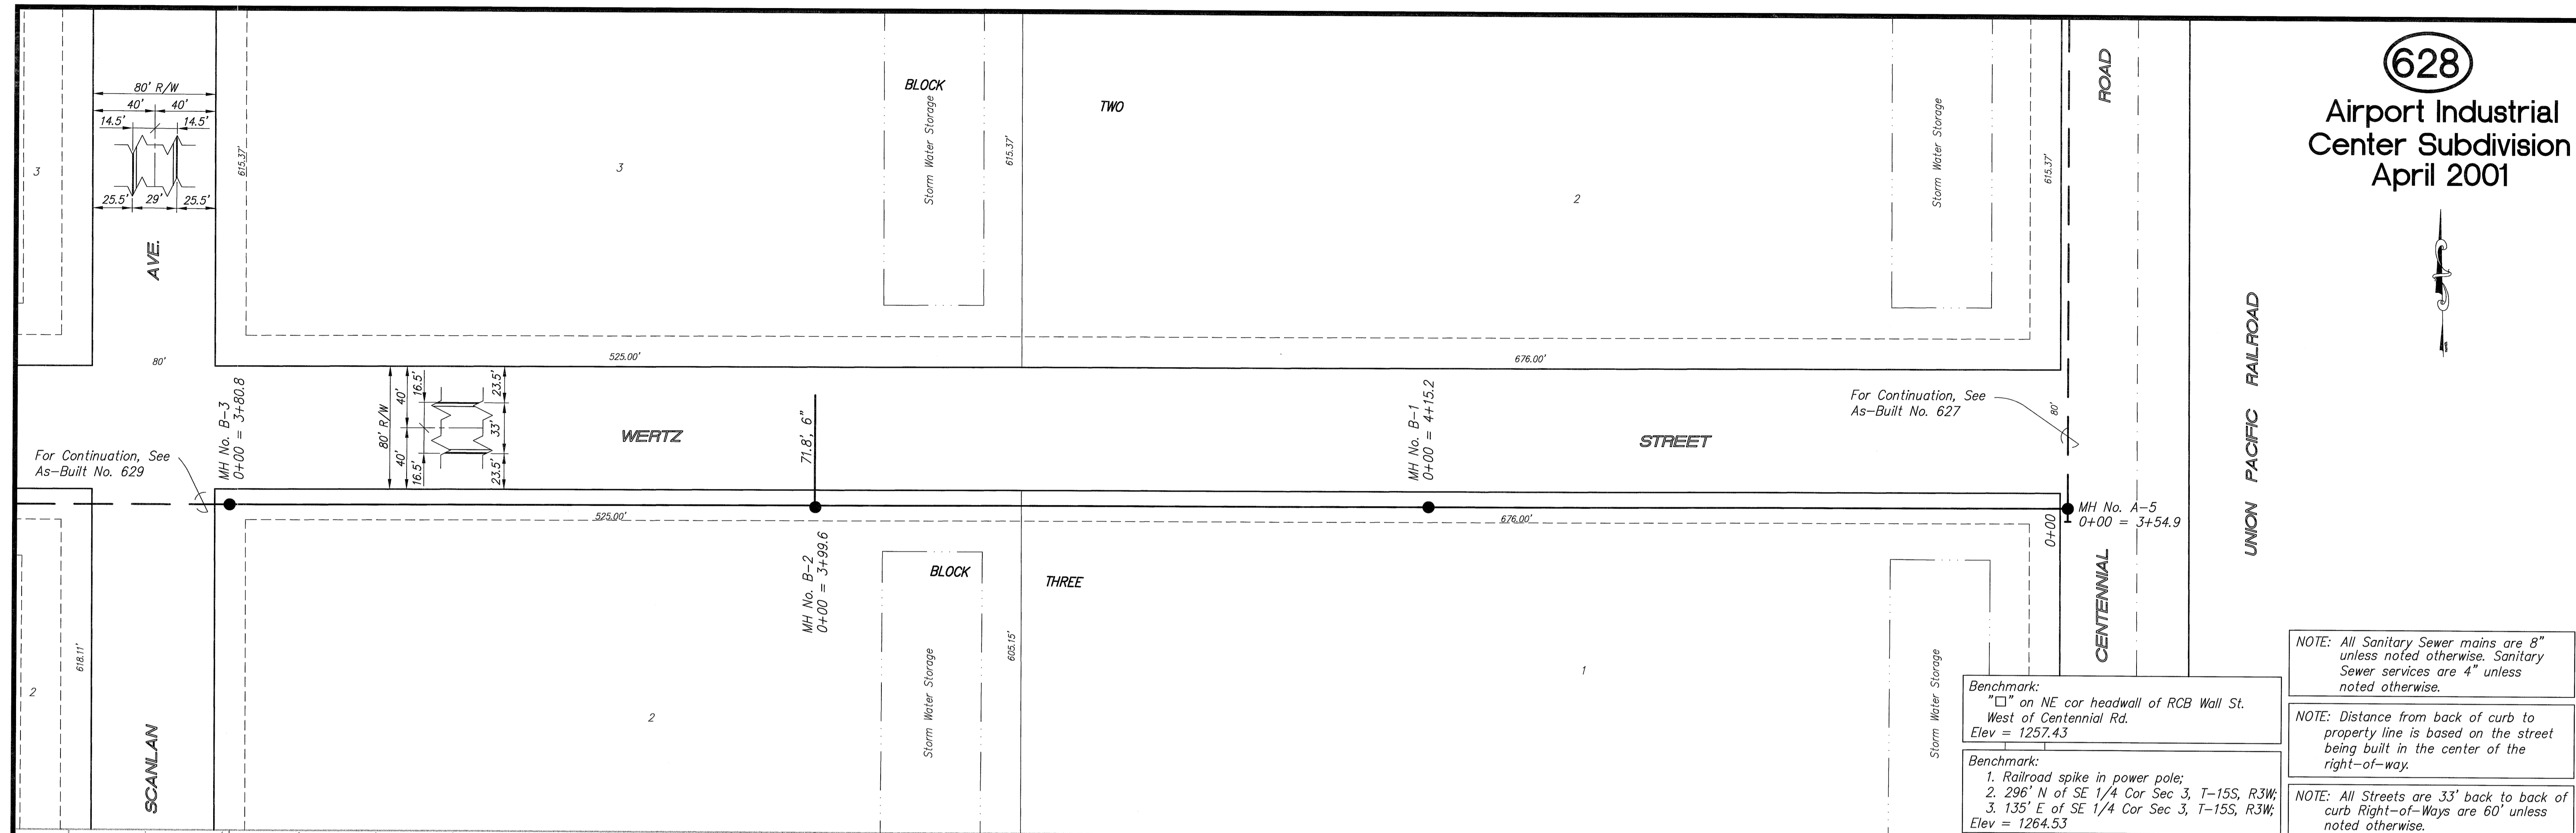

PP243615B.DWG Created: 12 Aug 99

NO.	REVISIONS	DATE	BY

PROJECT TITLE:
Sanitary Sewer As-Built Drawing

CONSTRUCTED BY:
Stevens Contractors

SCALE:
Plan: 1" = 50'
Profile: Horiz. 1" = 50'
Vert. 1" = 5'

DESIGN:
DRAWN: KWD

CITY OF SALINA
ENGINEERING DEPARTMENT
300 WEST ASH SALINA, KANSAS 67401
PH: 785.309.5725 FAX: 785.309.5713

DATE: Sept 2001
FILENAME: 628.dwg
PROJ. NO.: 00-1256
SHEET: OF: