


SCALE
 PLAN: 1" = 50'
 Horiz & Vert
 PROFILE:
 Horiz 1" = 50'
 Vert 1" = 5'

BM No. 93: "M" in Mueller on fire hydrant at NW corner of Sequoia and Huntington Elev = 1233.97

NOTE: All Sanitary Sewer mains are 8" unless noted otherwise. Sanitary Sewer services are 4" unless noted otherwise.

NOTE: Distance from back of curb to property line is based on the street being built in the center of the right-of-way.

NOTE: All Streets are 33' back to back of curb Right-of-Ways are 60' unless noted otherwise.

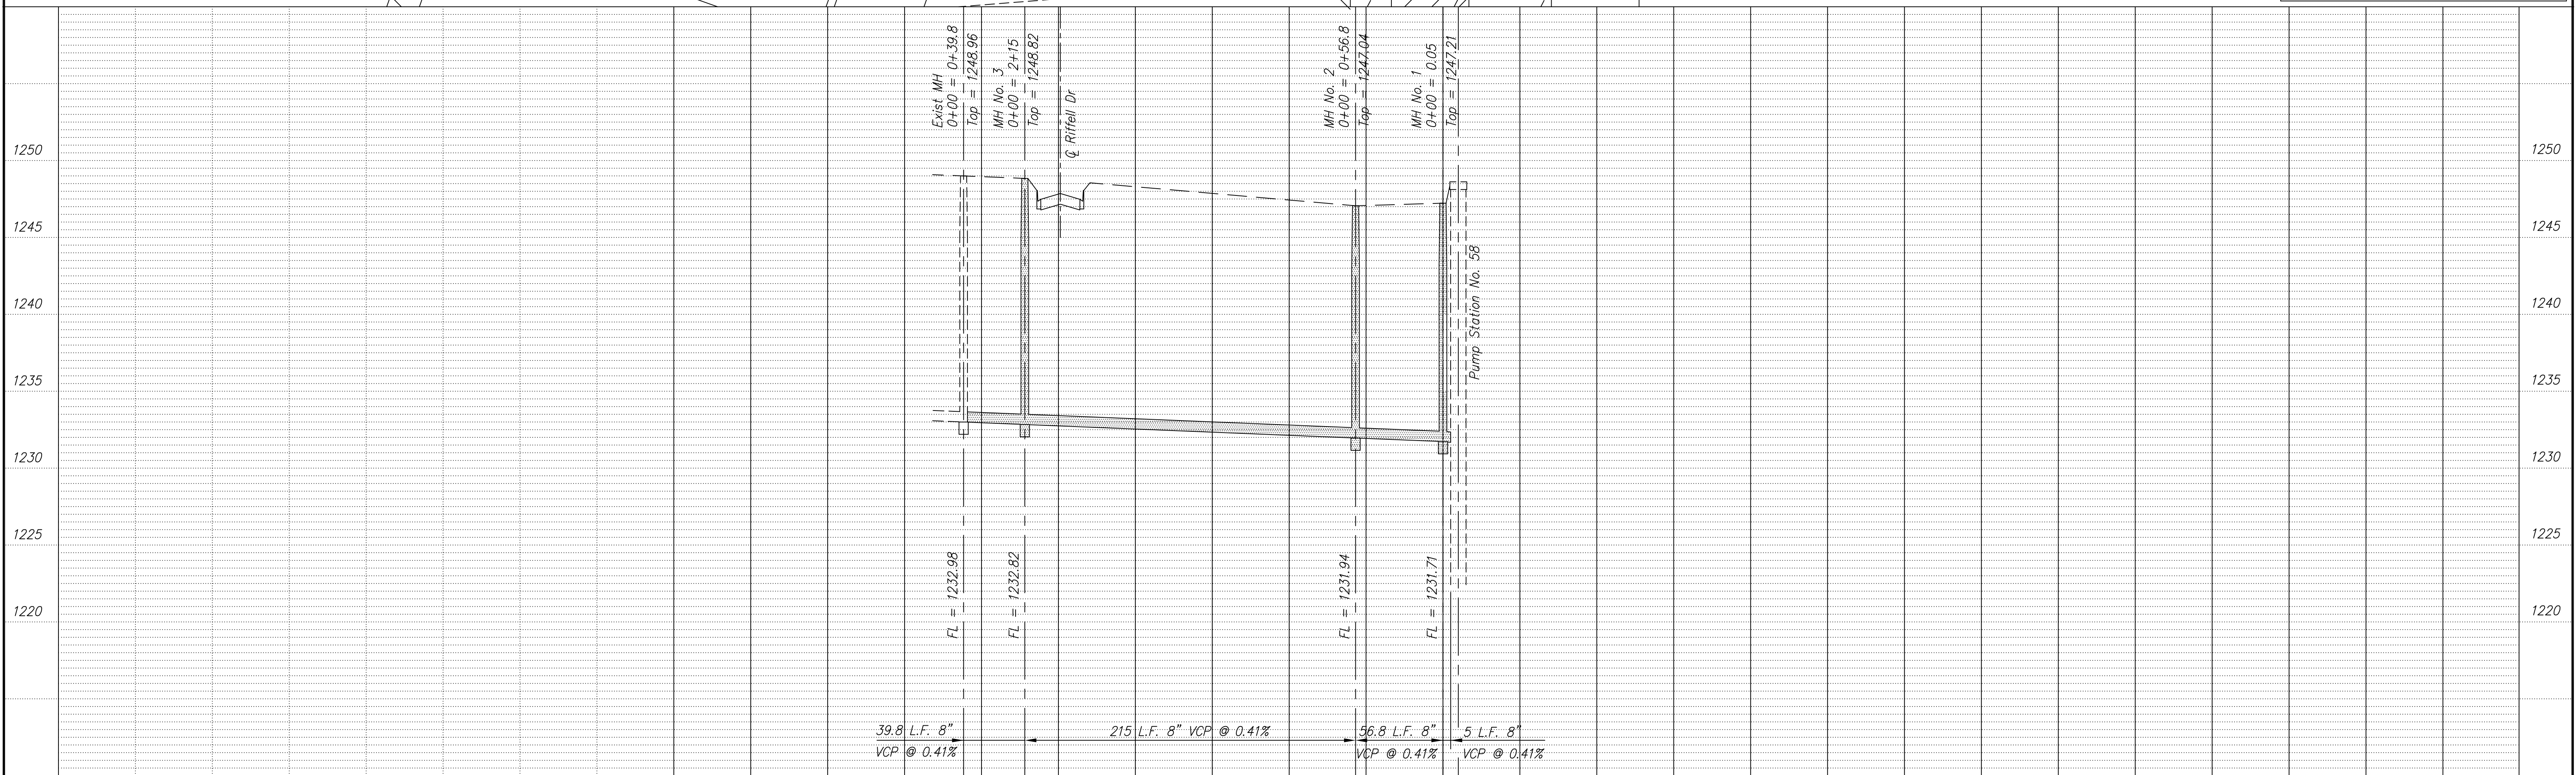

NO.	REVISIONS	DATE	BY

PROJECT TITLE
Sanitary Sewer As-Built Drawing

CONTRACTOR: Stevens Contractors
 DESIGN:
 CHECKED:
 SCALE: As Shown
 DRAWN:
 APPROVED:

CITY OF SALINA
 ENGINEERING DEPARTMENT
 300 WEST ASH SALINA, KANSAS 67401
 PH: 785.309.5725 FAX: 785.309.5713

DATE: Nov 2001
 PROJ. NO: 00-1256
 FILENAME: 630.dwg
 SHEET: OF: