
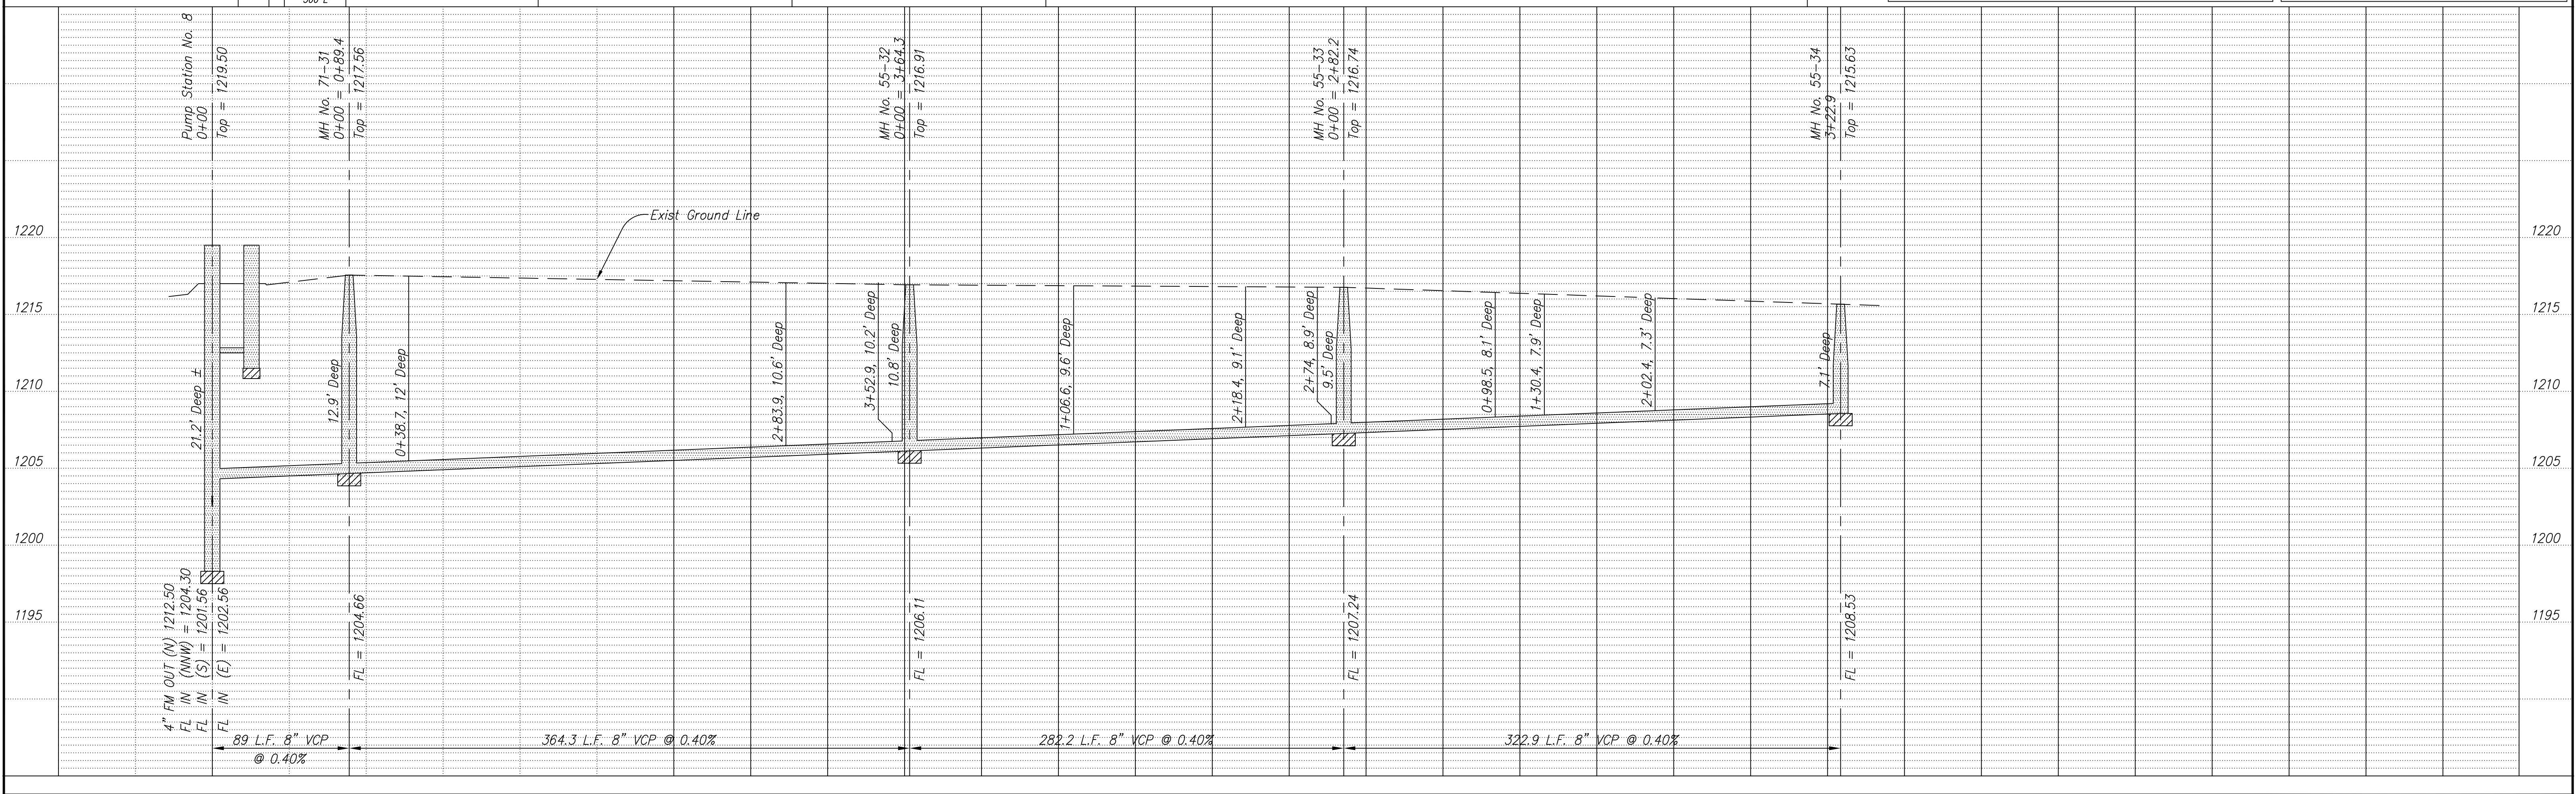


634

Fifth and Stimmel
(Fifth Street North of Stimmel Road)
Oct 2002

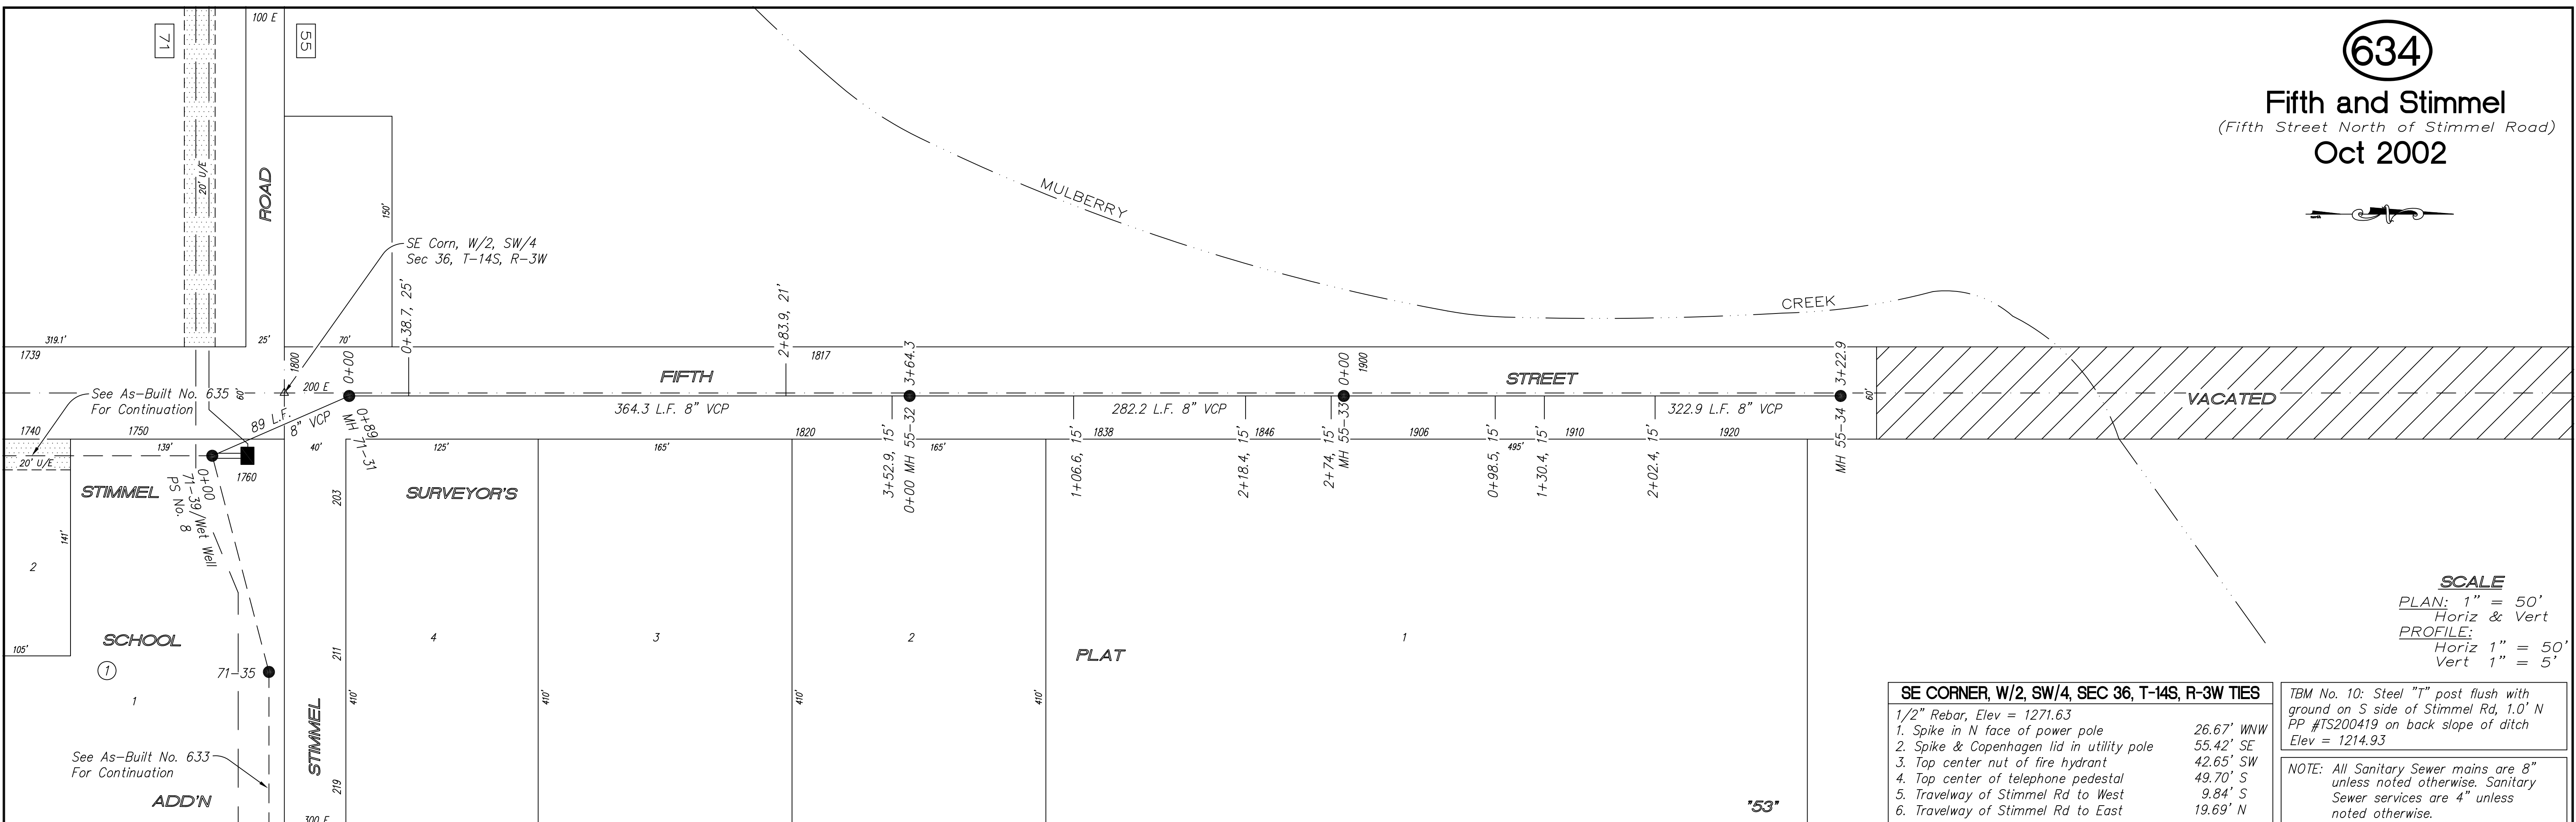

PROJECT TITLE						CONTRACTOR		DESIGN		CHECKED		CITY OF SALINA		DATE		PROJ. NO.	
Sanitary Sewer As-Built Drawing						Smoky Hill, Inc		Wilson & Co.				ENGINEERING DEPARTMENT		April 2002		00-1265	
NO. REVISIONS DATE BY						SCALE		DRAWN		APPROVED		300 WEST ASH SALINA, KANSAS 67401		FILENAME		SHEET	
						As Shown						PH: 785.309.5725 FAX: 785.309.5713		634.dwg		634	