


639-FM

North Ohio Wastewater Imp.

(Stimmel Road East of Fifth Street at North Ohio Street)

Oct 2002

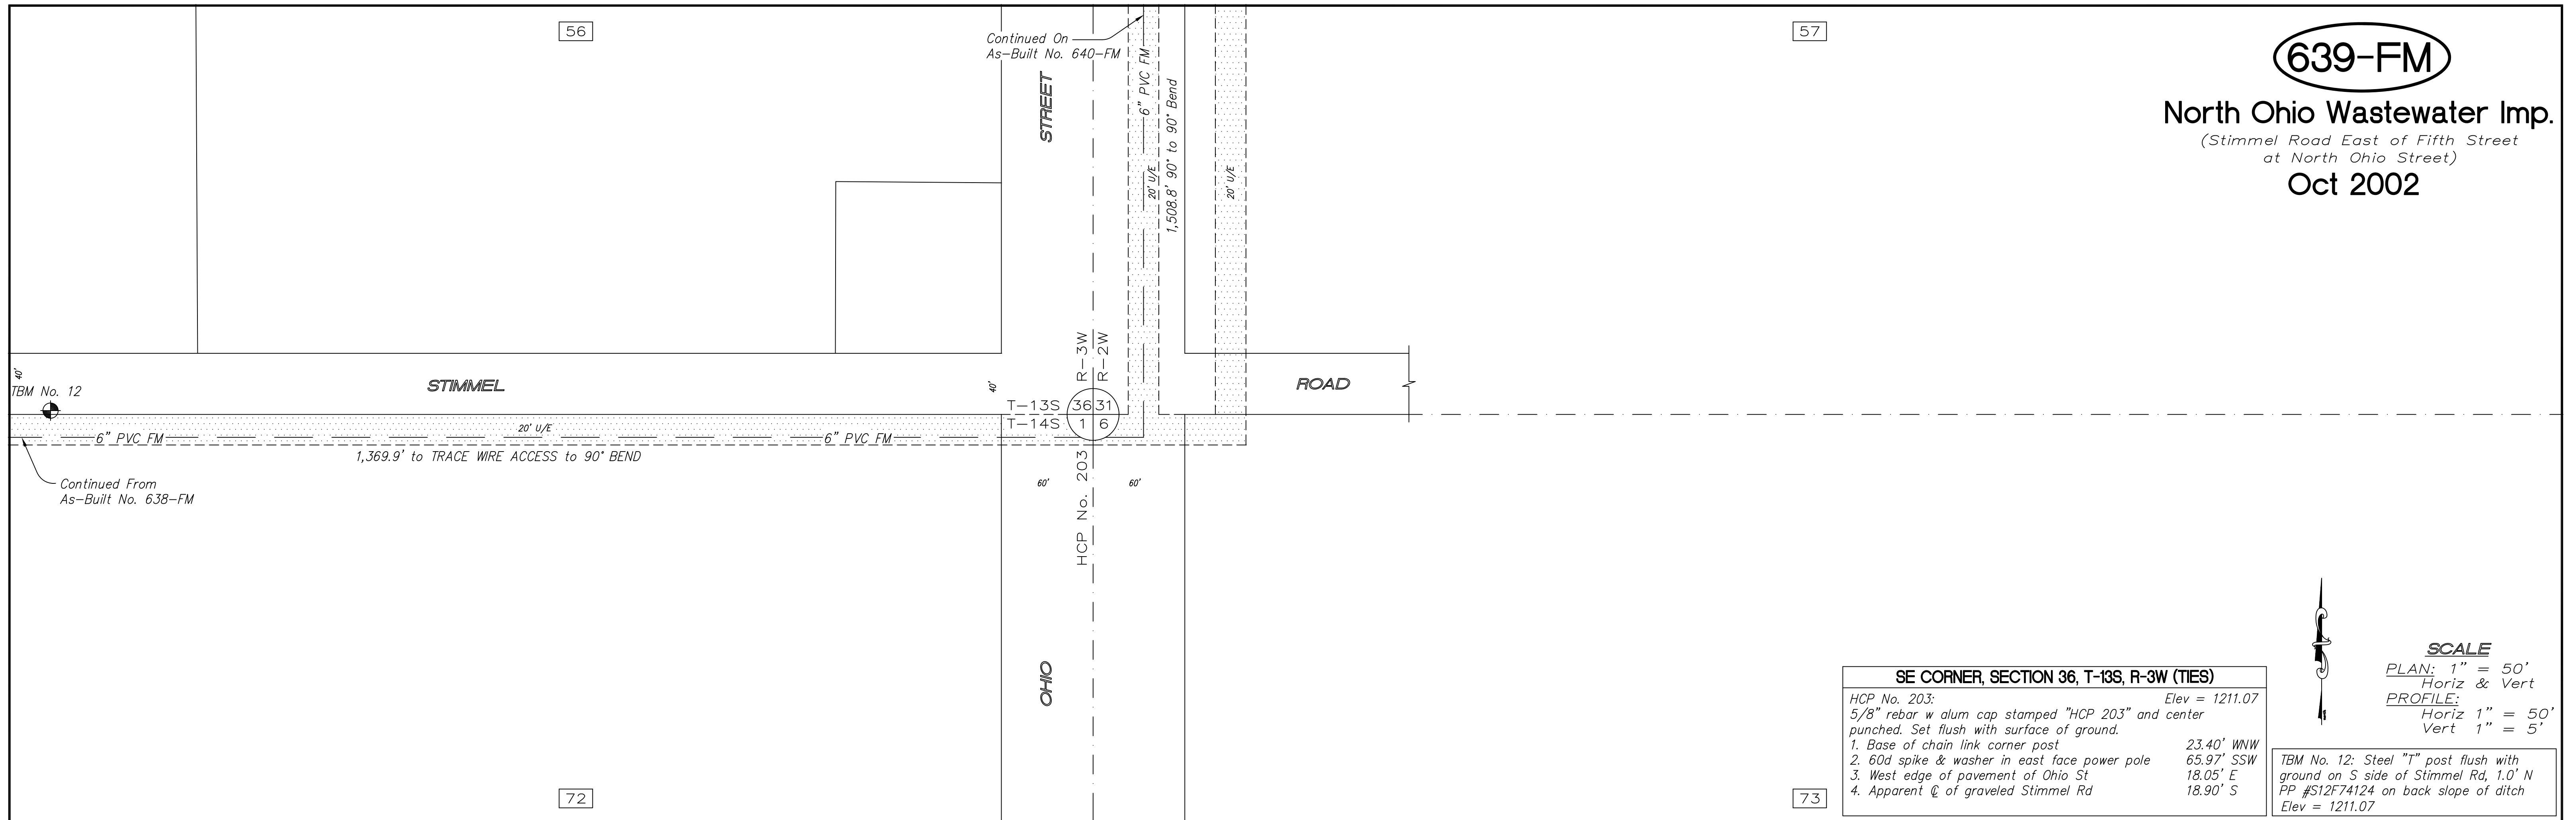

[Empty grid area for notes or calculations]									
---------------------------------------------	--	--	--	--	--	--	--	--	--

PROJECT TITLE					CONTRACTOR		DESIGN		CHECKED		CITY OF SALINA		DATE		PROJ. NO.						
Sanitary Sewer As-Built Drawing					Smoky Hill, Inc		Wilson & Co.				ENGINEERING DEPARTMENT		April 2002		00-1264						
					SCALE		DRAWN		APPROVED				FILENAME		SHEET		OF				
NO.		REVISIONS		DATE		BY		NO.		REVISIONS		DATE		BY		638-fm.dwg		638		OF	