



641

North Ohio Wastewater Imp.
(North Ohio Street)
Oct 2002

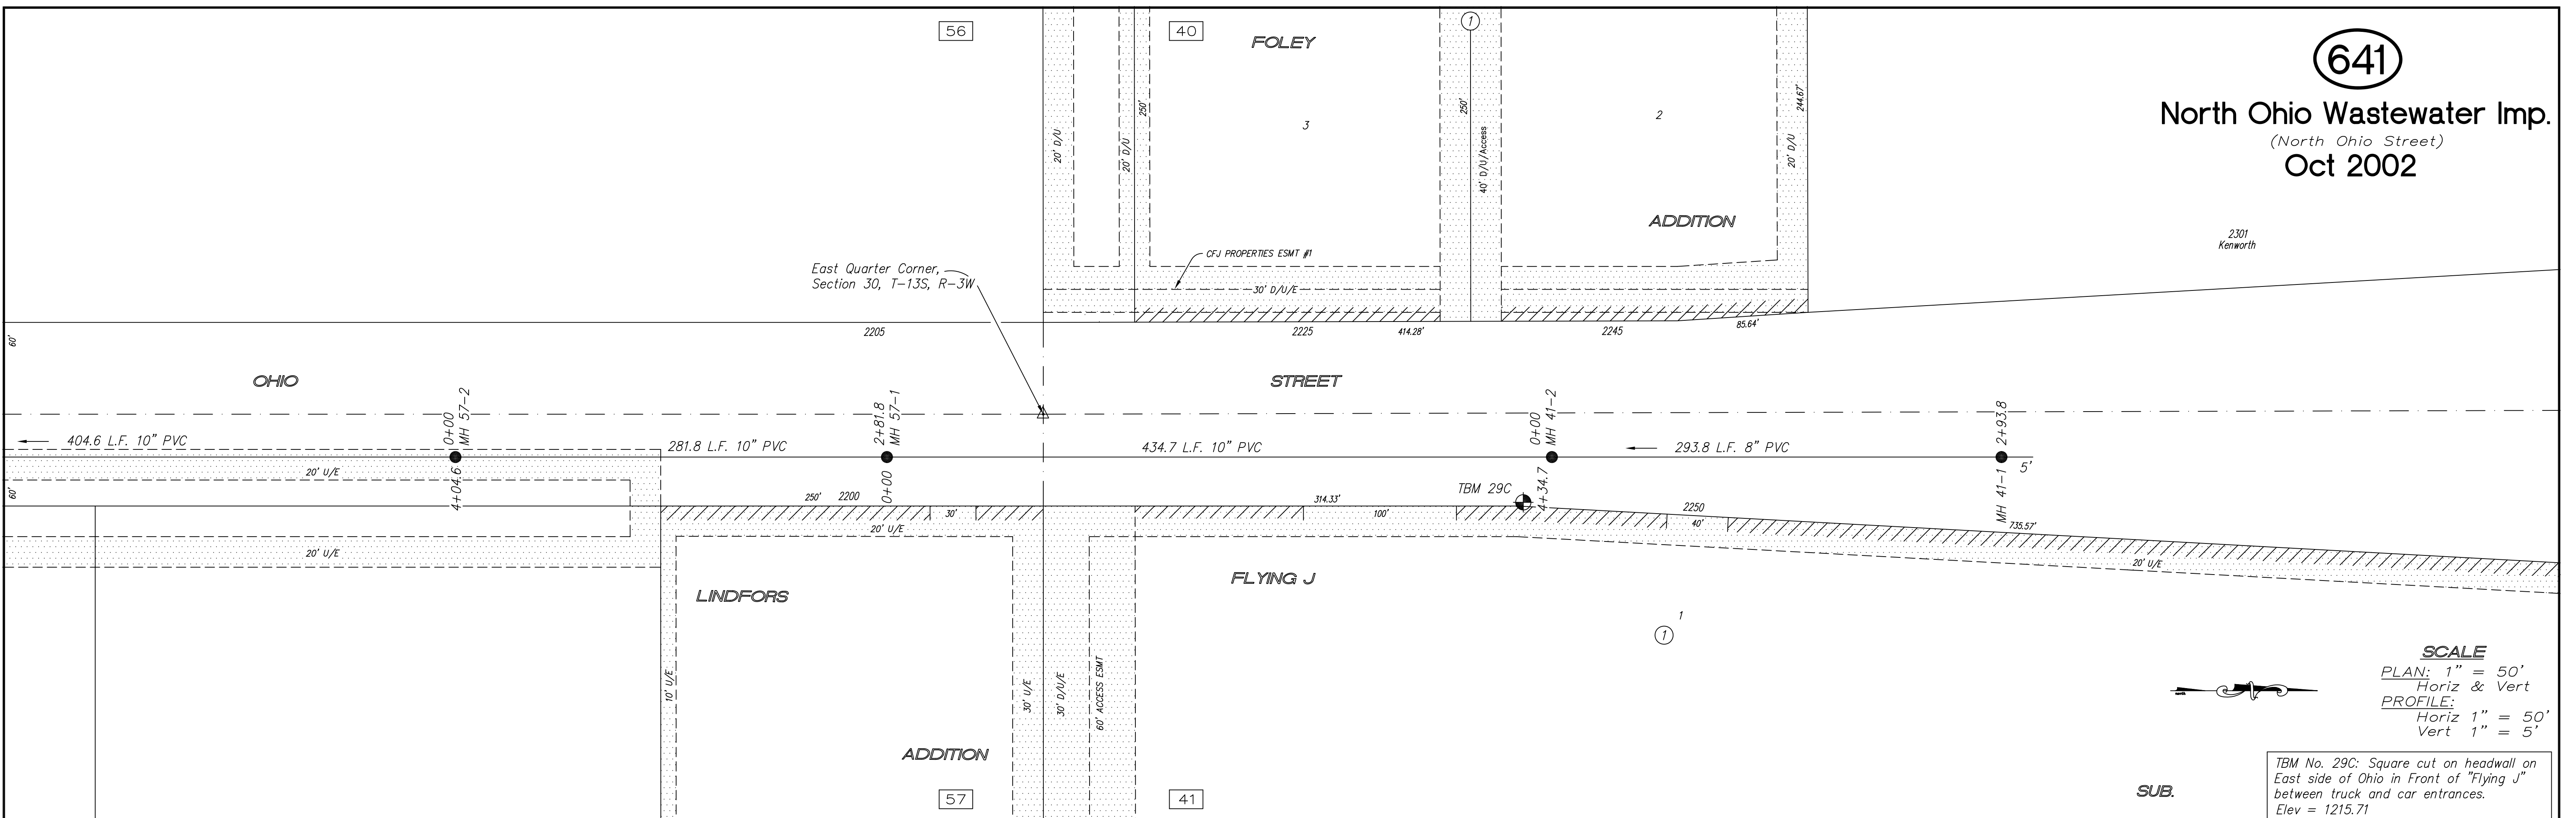

SCALE
 PLAN: 1" = 50'
 Horiz & Vert
 PROFILE: 1" = 50'
 Vert 1" = 5'

TBM No. 29C: Square cut on headwall on East side of Ohio in front of "Flying J" between truck and car entrances. Elev = 1215.71

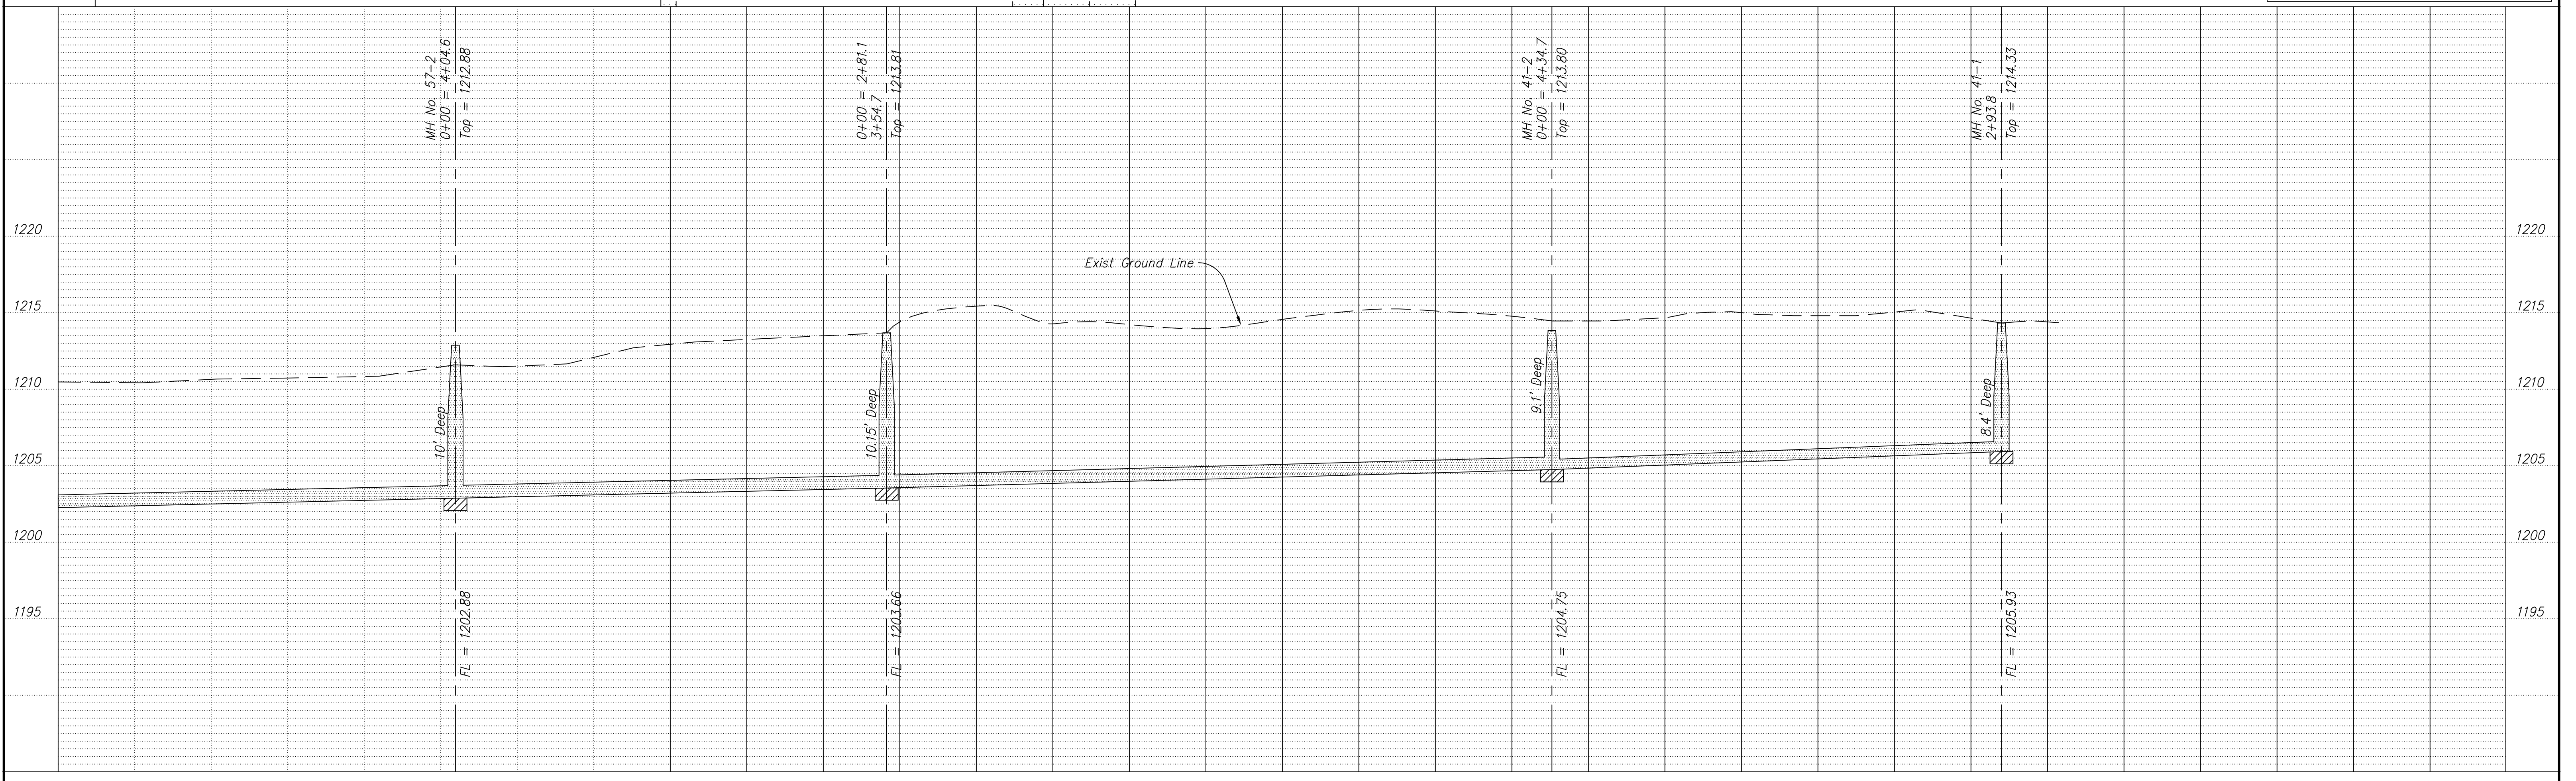

NO.	REVISIONS	DATE	BY

PROJECT TITLE
Sanitary Sewer As-Built Drawing

CONTRACTOR
Smoky Hill Inc

DESIGN
Wilson & Co.

CHECKED

SCALE
As Shown

DRAWN

APPROVED

CITY OF SALINA
 ENGINEERING DEPARTMENT
 300 WEST ASH SALINA, KANSAS 67401
 PH: 785.309.5725 FAX: 785.309.5713

DATE
Nov 2001

PROJ. NO.
00-1264

FILENAME
641.dwg

SHEET
641

OF