


642-FM

North Ohio Wastewater Imp.
(Stimmel Road East of Fifth Street)
Oct 2002

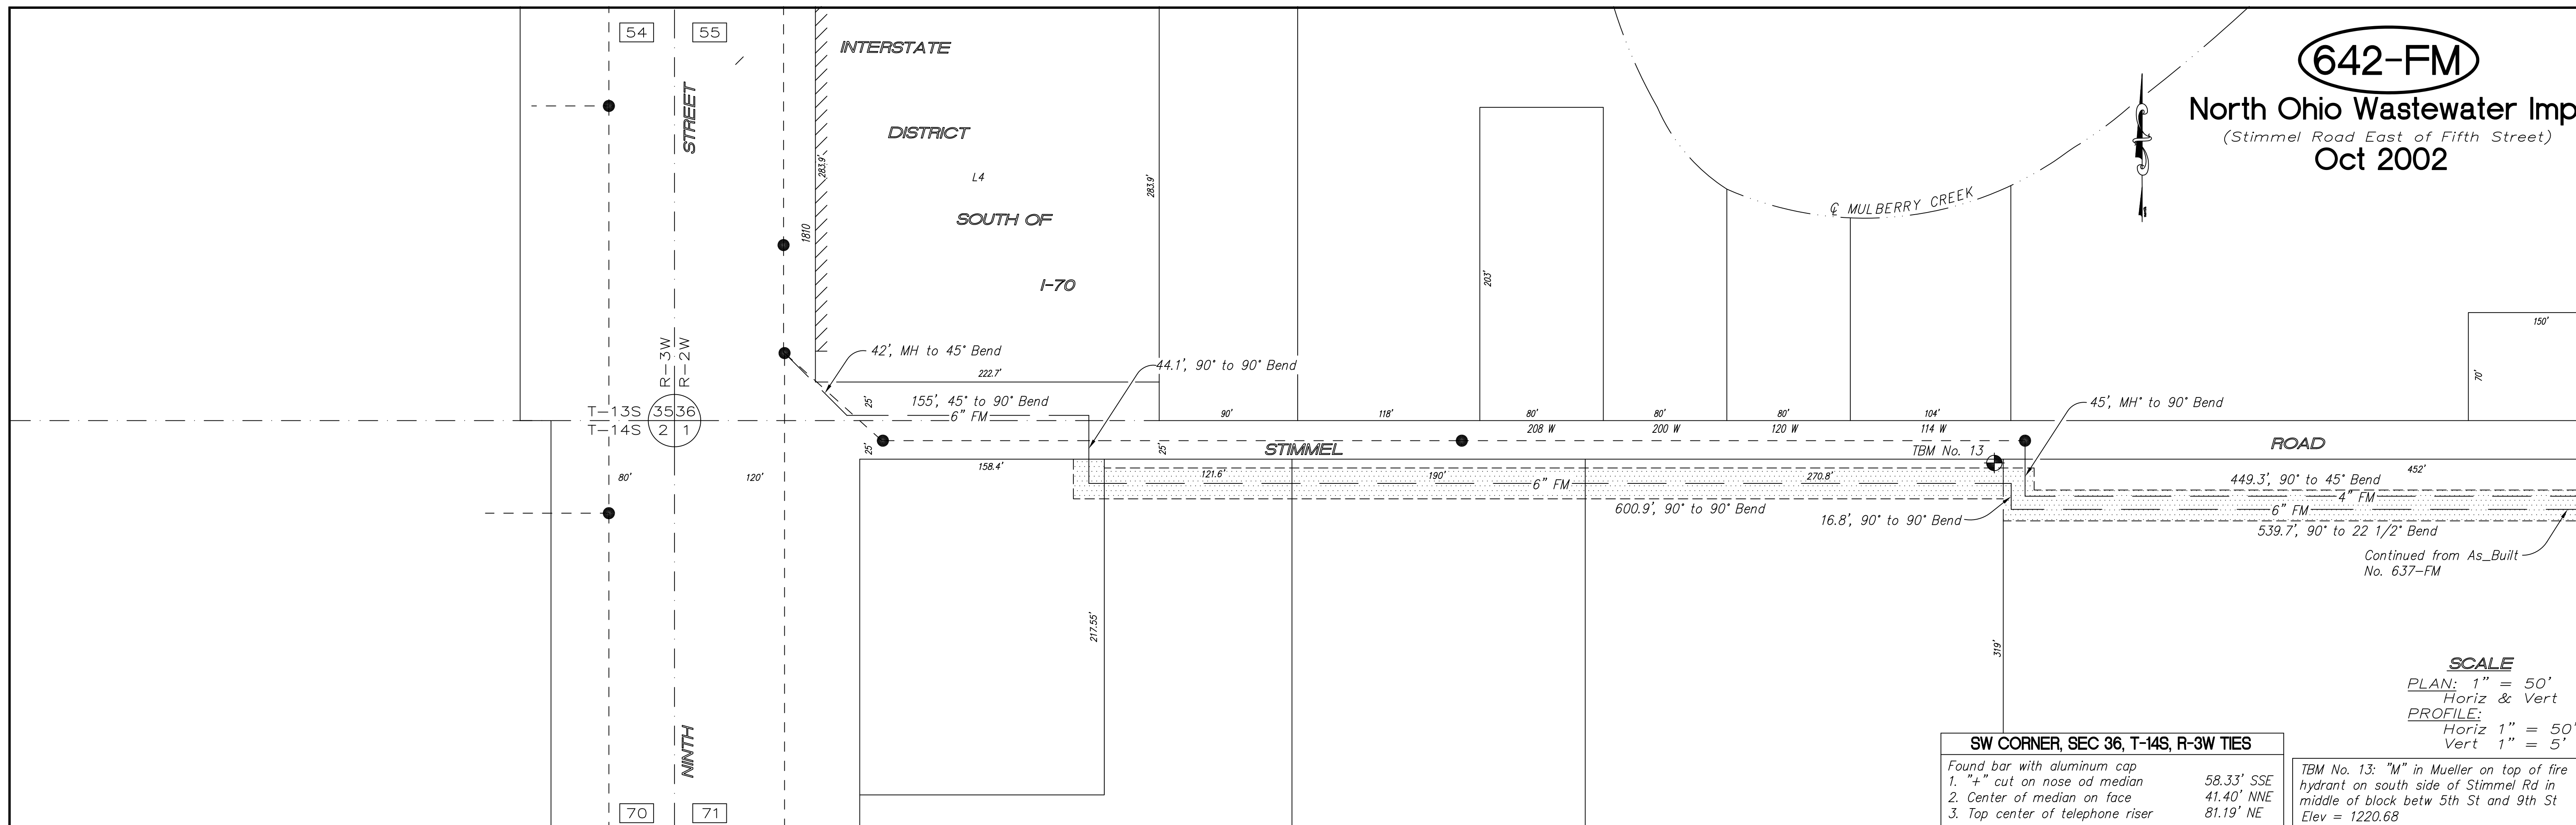

SCALE
 PLAN: 1" = 50'
 Horiz & Vert
 PROFILE:
 Horiz 1" = 50'
 Vert 1" = 5'

SW CORNER, SEC 36, T-14S, R-3W TIES
 Found bar with aluminum cap
 1. "+" cut on nose of median 58.33' SSE
 2. Center of median on face 41.40' NNE
 3. Top center of telephone riser 81.19' NE

TBM No. 13: "M" in Mueller on top of fire hydrant on south side of Stimmel Rd in middle of block betw 5th St and 9th St Elev = 1220.68

[Empty grid area for notes or calculations]									
---	--	--	--	--	--	--	--	--	--