
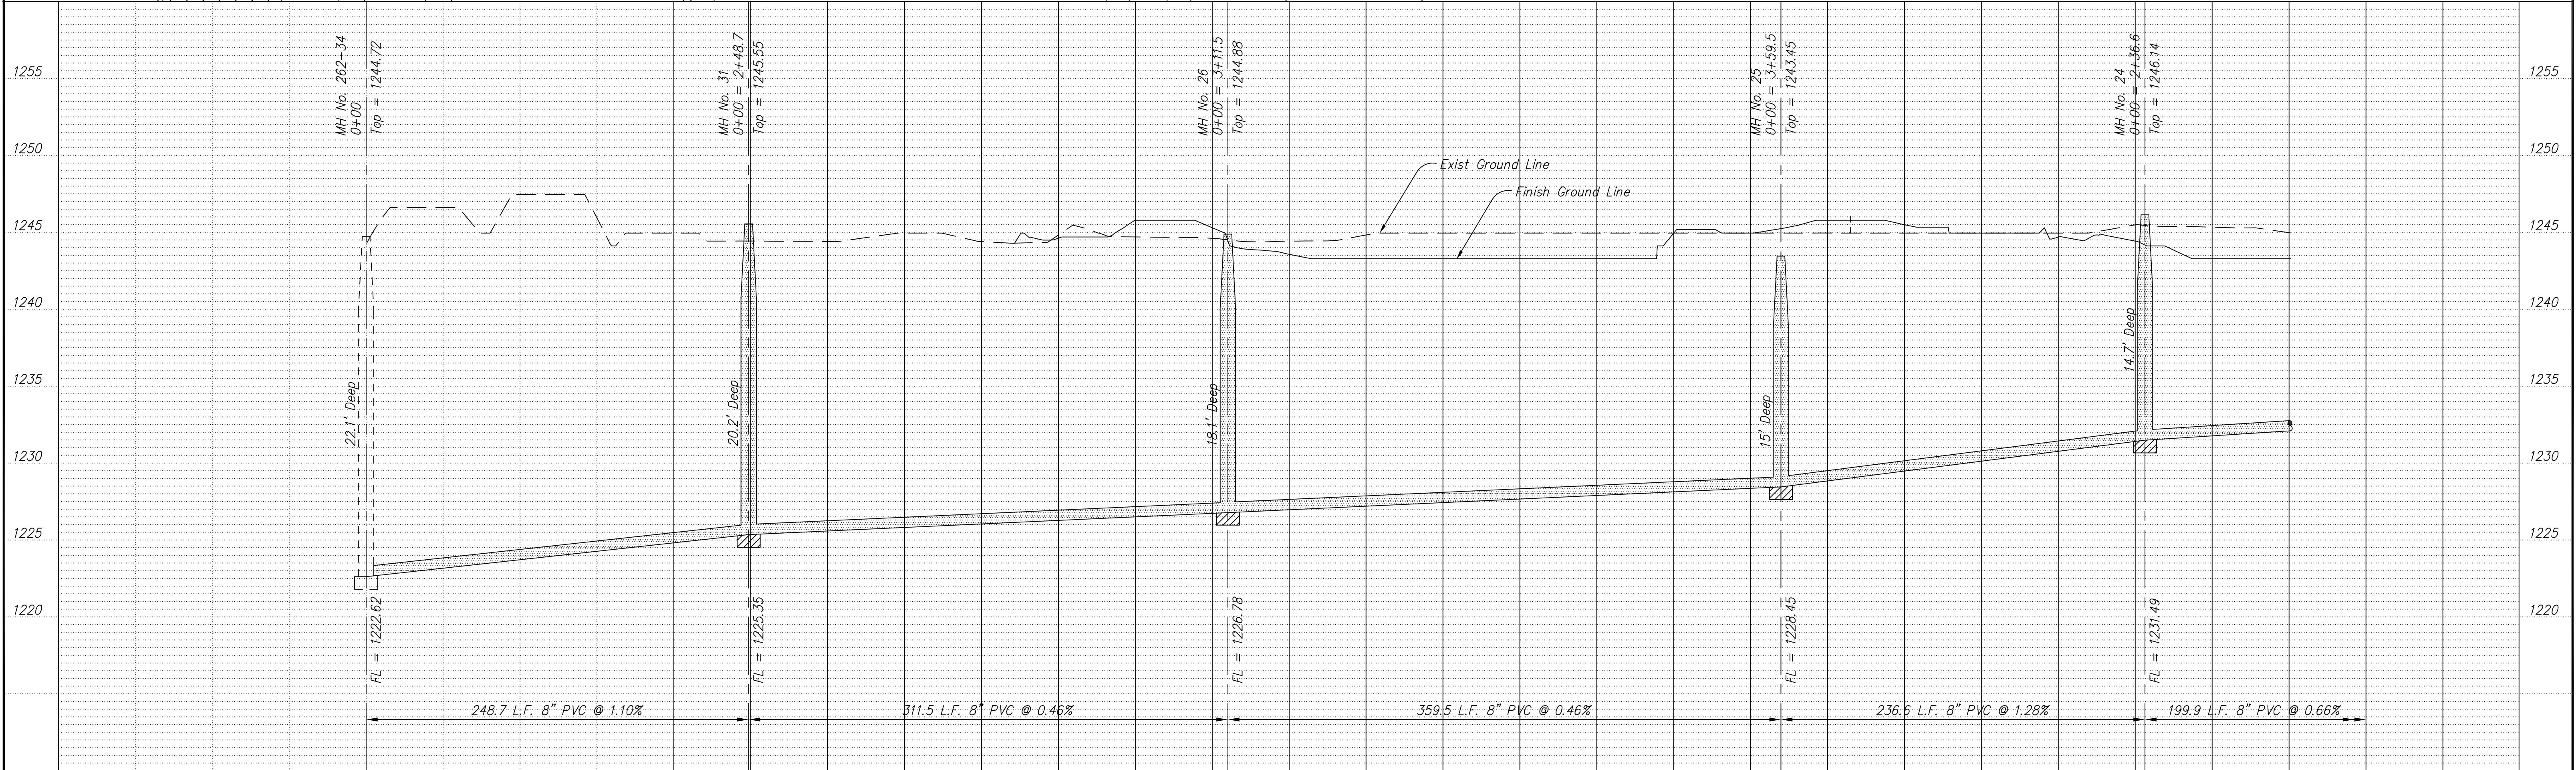


643

AUBURDALE ADDITION
(LOWE'S HOME IMPROVEMENT WAREHOUSE)
Feb 2002

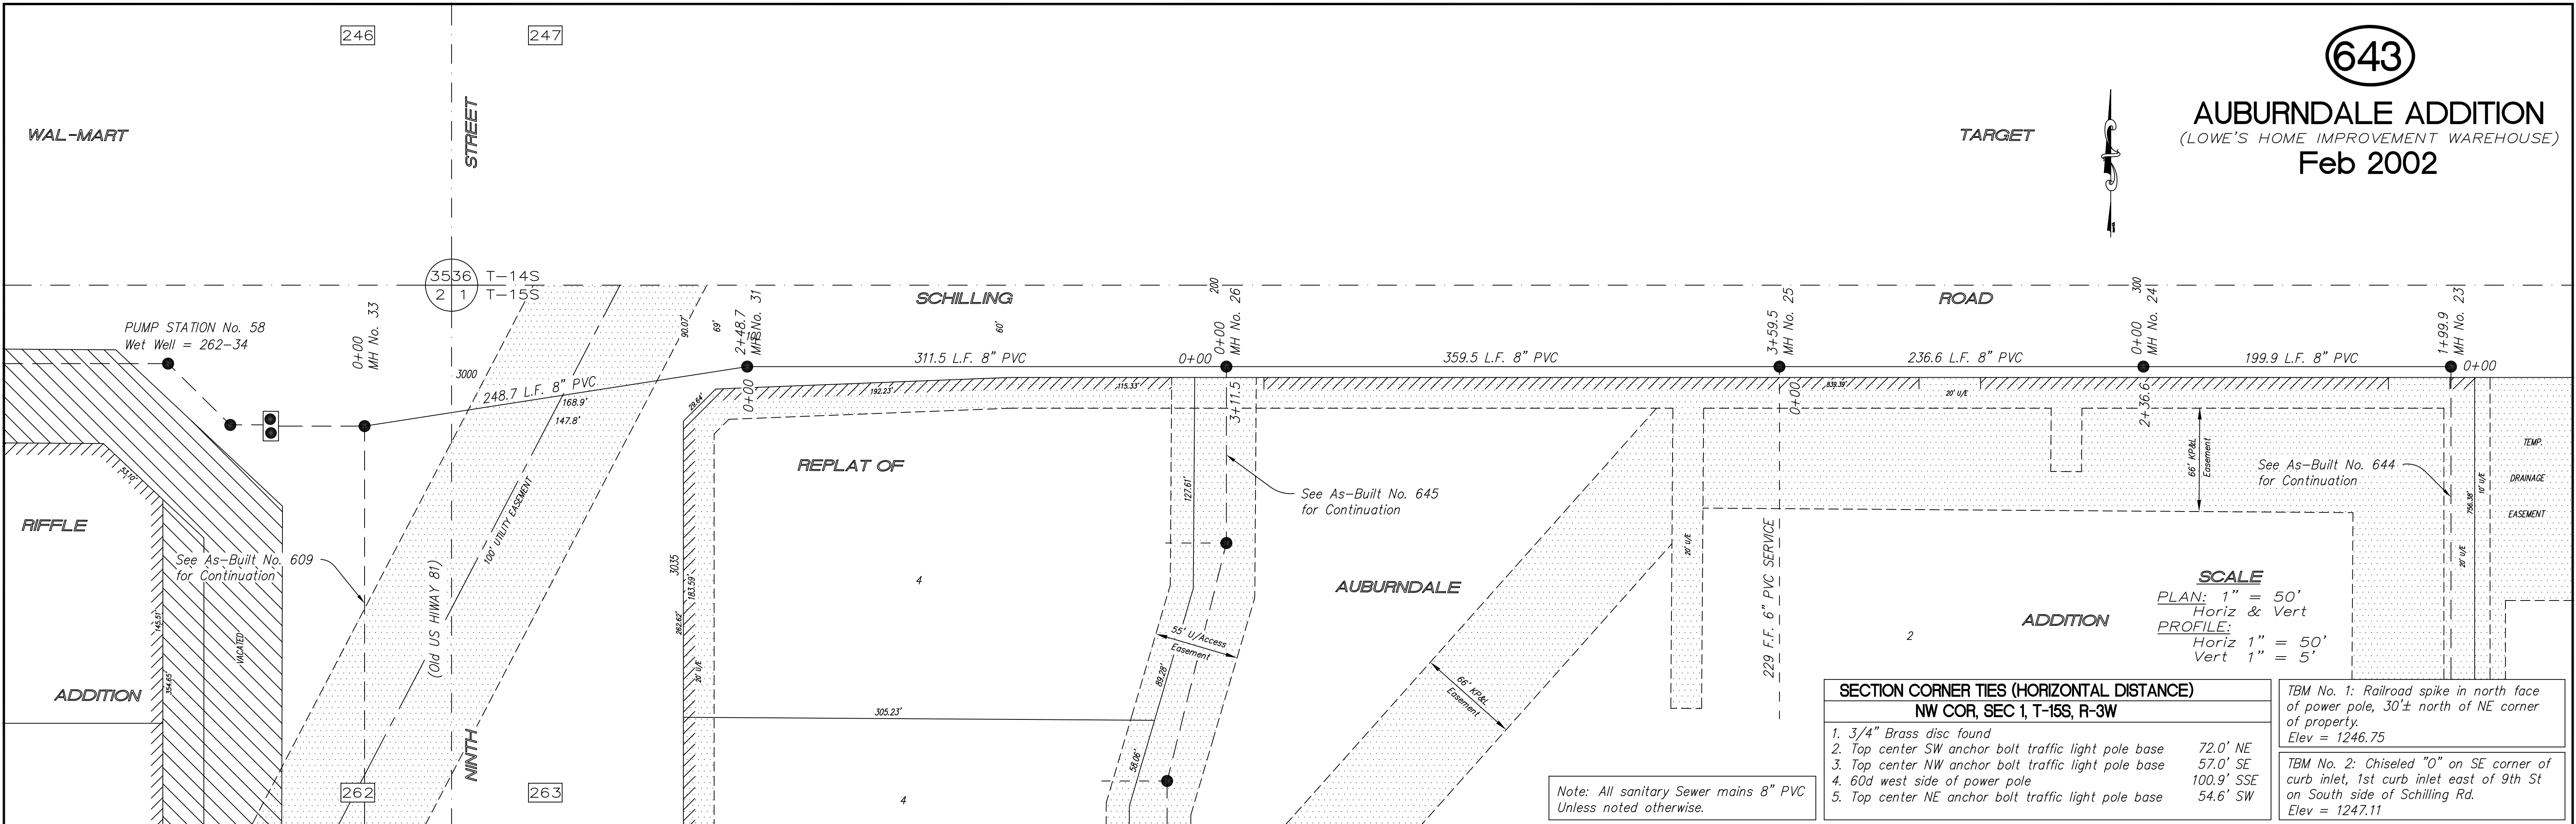

NO.	REVISIONS	DATE	BY

PROJECT TITLE
Sanitary Sewer As-Built Drawing

CONTRACTOR Stevens Contractors	DESIGN Ozark Eng.	CHECKED	CITY OF SALINA ENGINEERING DEPARTMENT 300 WEST ASH SALINA, KANSAS 67401 PH: 785.309.5725 FAX: 785.309.5713	DATE Dec 2002	PROJ. NO.
SCALE As Shown	DRAWN	APPROVED		FILENAME 643.dwg	SHEET 643