

651

EASTVIEW ESTATES ADD. PHASE 5 Aug 2003

GOLDEN EAGLE ESTATES ADDITION

SCALE

PLAN: 1" = 50' Horiz & Vert PROFILE: Horiz 1" = 50' Vert 1" = 5'

City BM No. 93: "M" in MUELLER, top fire hydrant, NW corner Sequoia & Huntington. Elev = 1233.97

NOTE: All Sanitary Sewer mains are 8" unless noted otherwise. NOTE: Distance from back of curb to property line is based on the street being built in the center of the right-of-way.

NOTE: All Streets are 33' back to back of curb. Right-of-Ways are 60' unless noted otherwise.

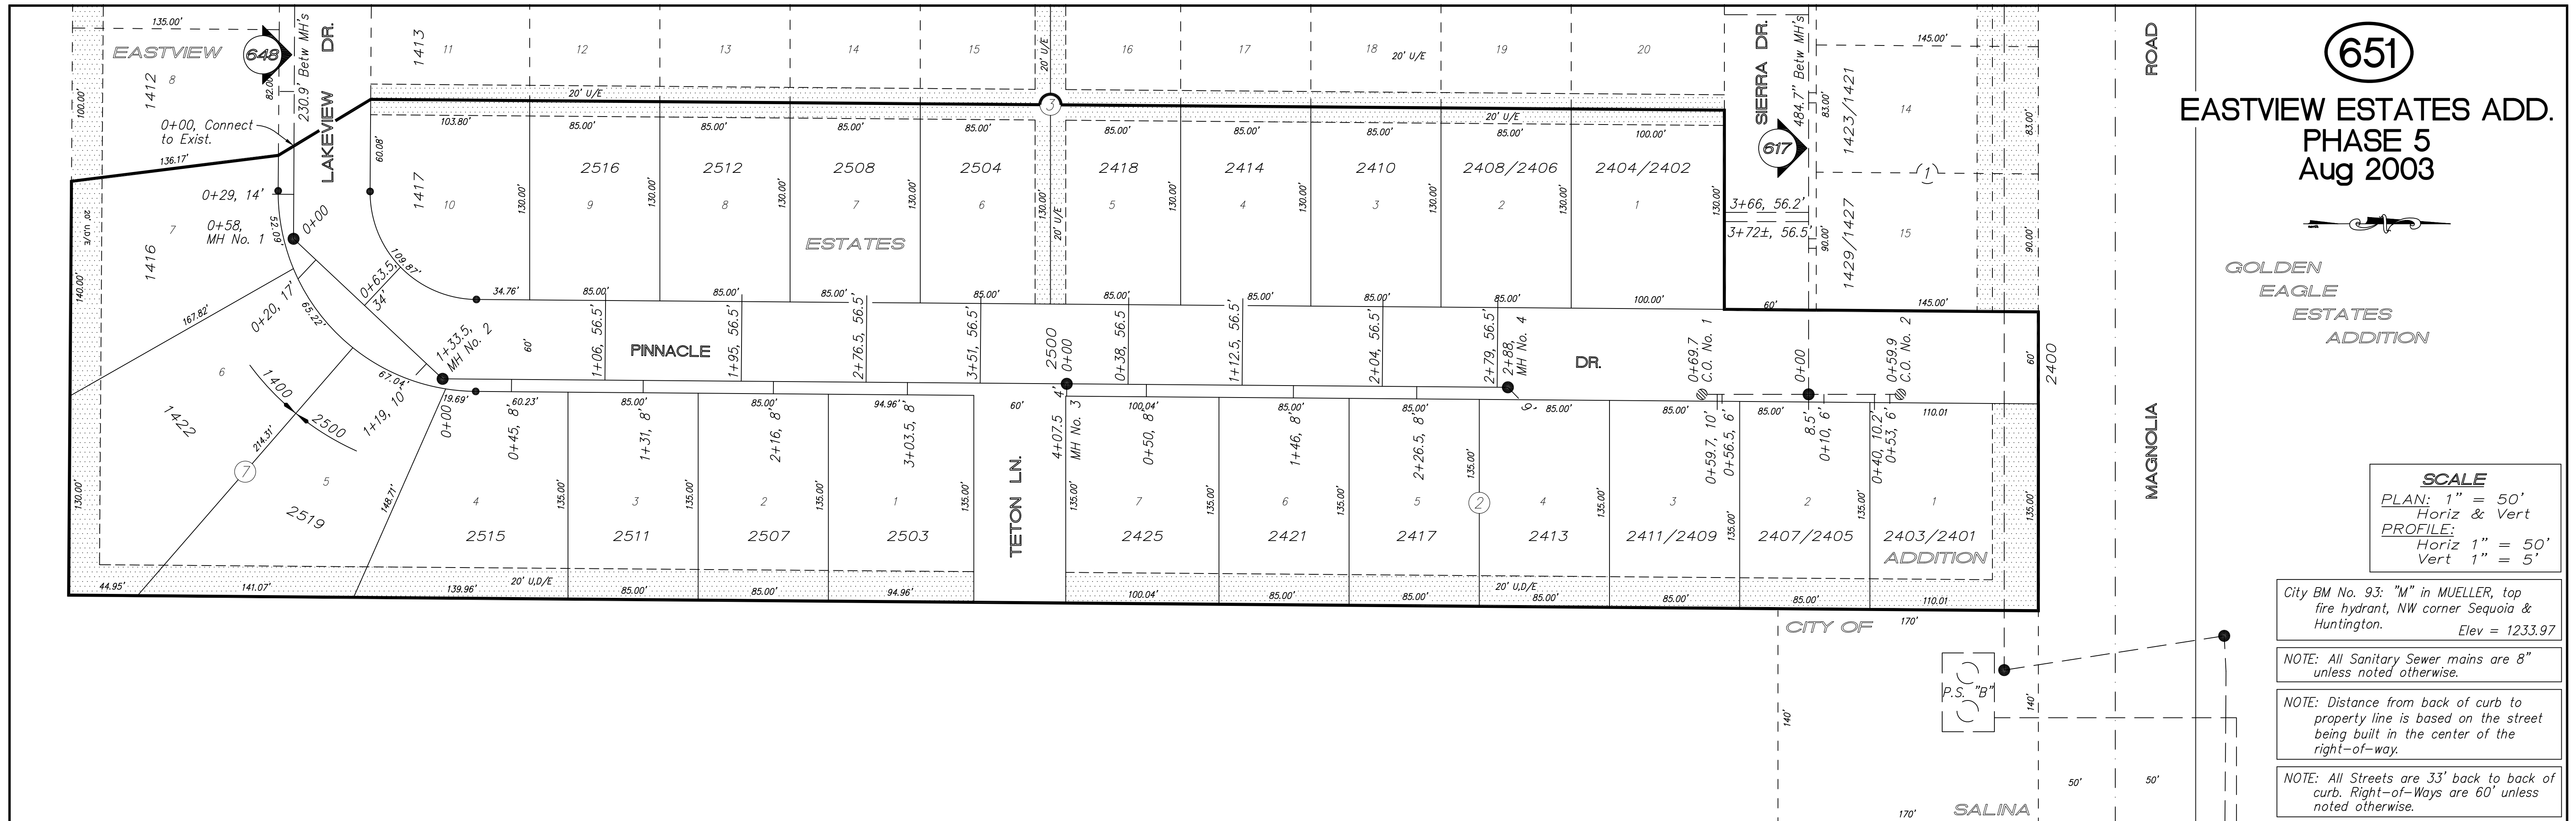


Table with columns for NO., REVISIONS, DATE, BY.

PROJECT TITLE: Sanitary Sewer As-Built Drawing

CONTRACTOR: STEVENS CONT, INC SCALE: As Shown

CITY OF SALINA ENGINEERING DEPARTMENT DATE: Oct 2003 PROJ. NO.: Private SHEET: OF: FILENAME: 651.dwg