
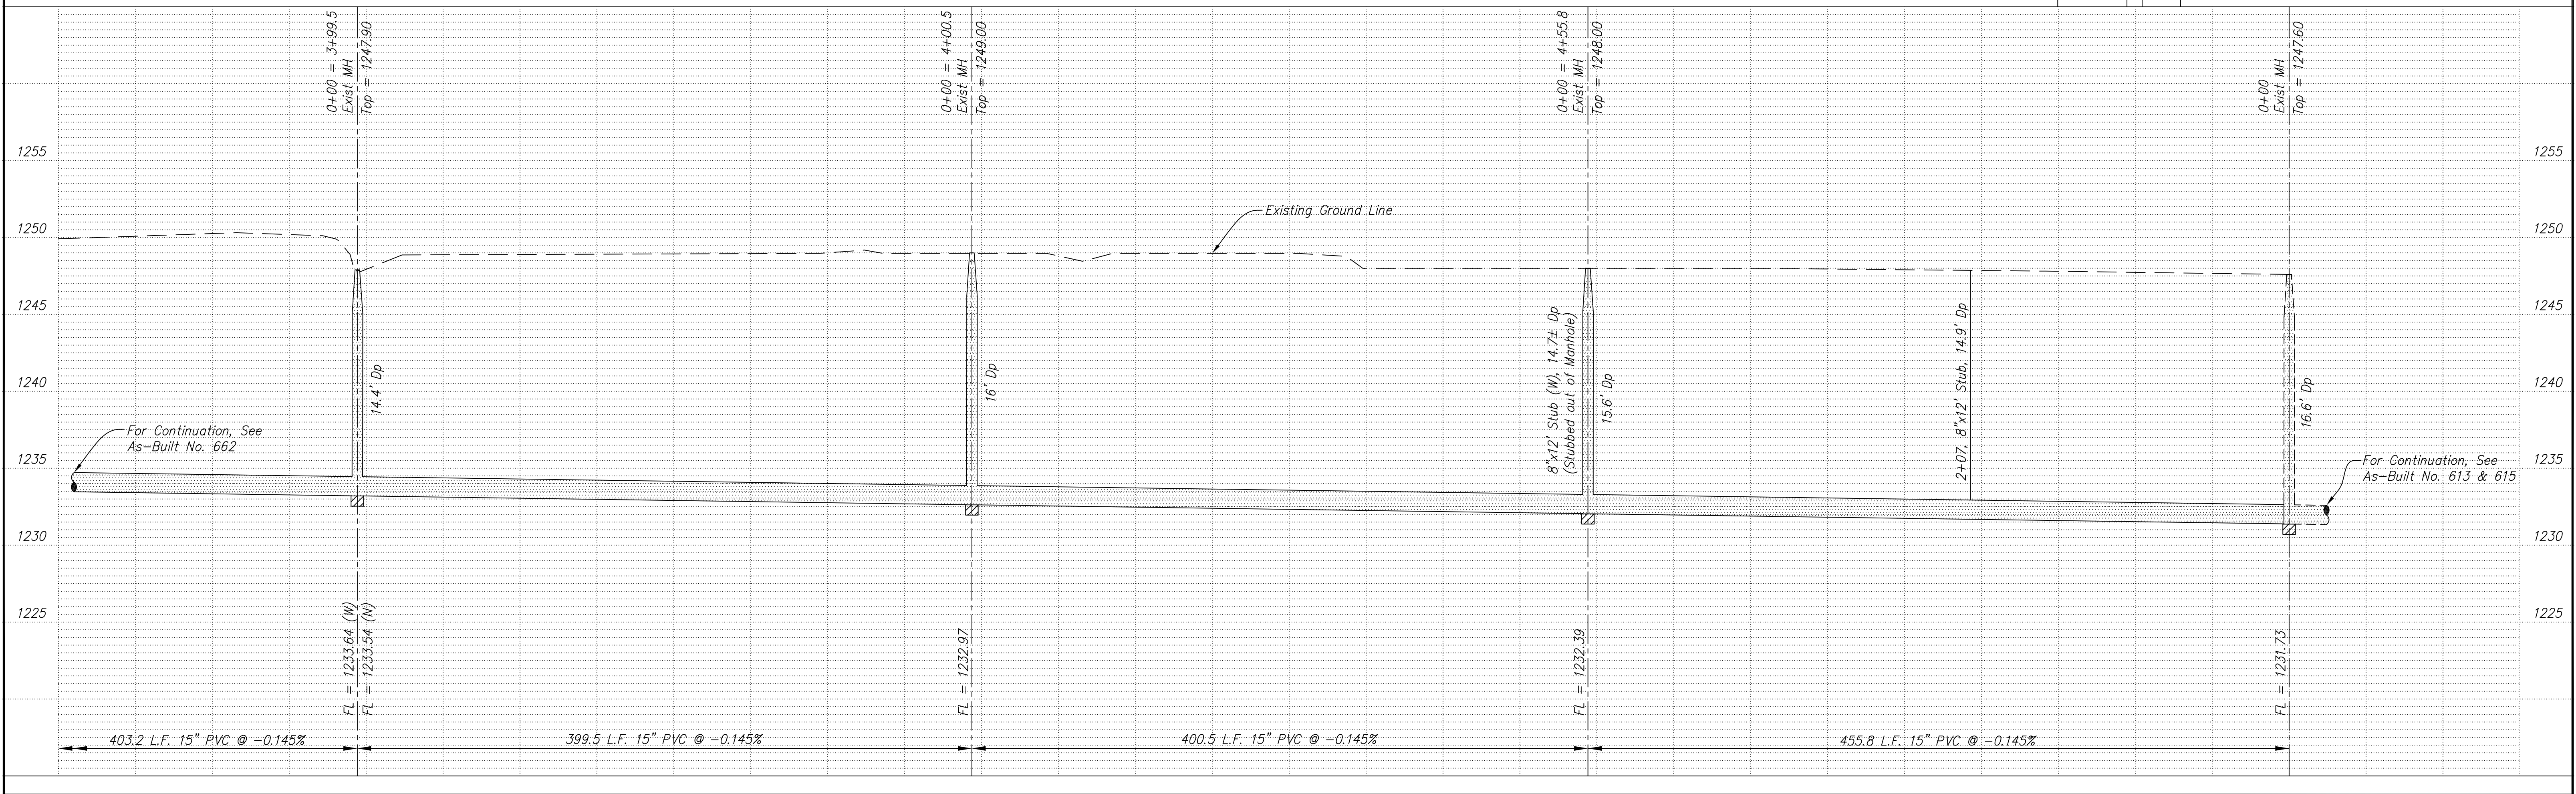


661
YOST ADDITION
 June 2003

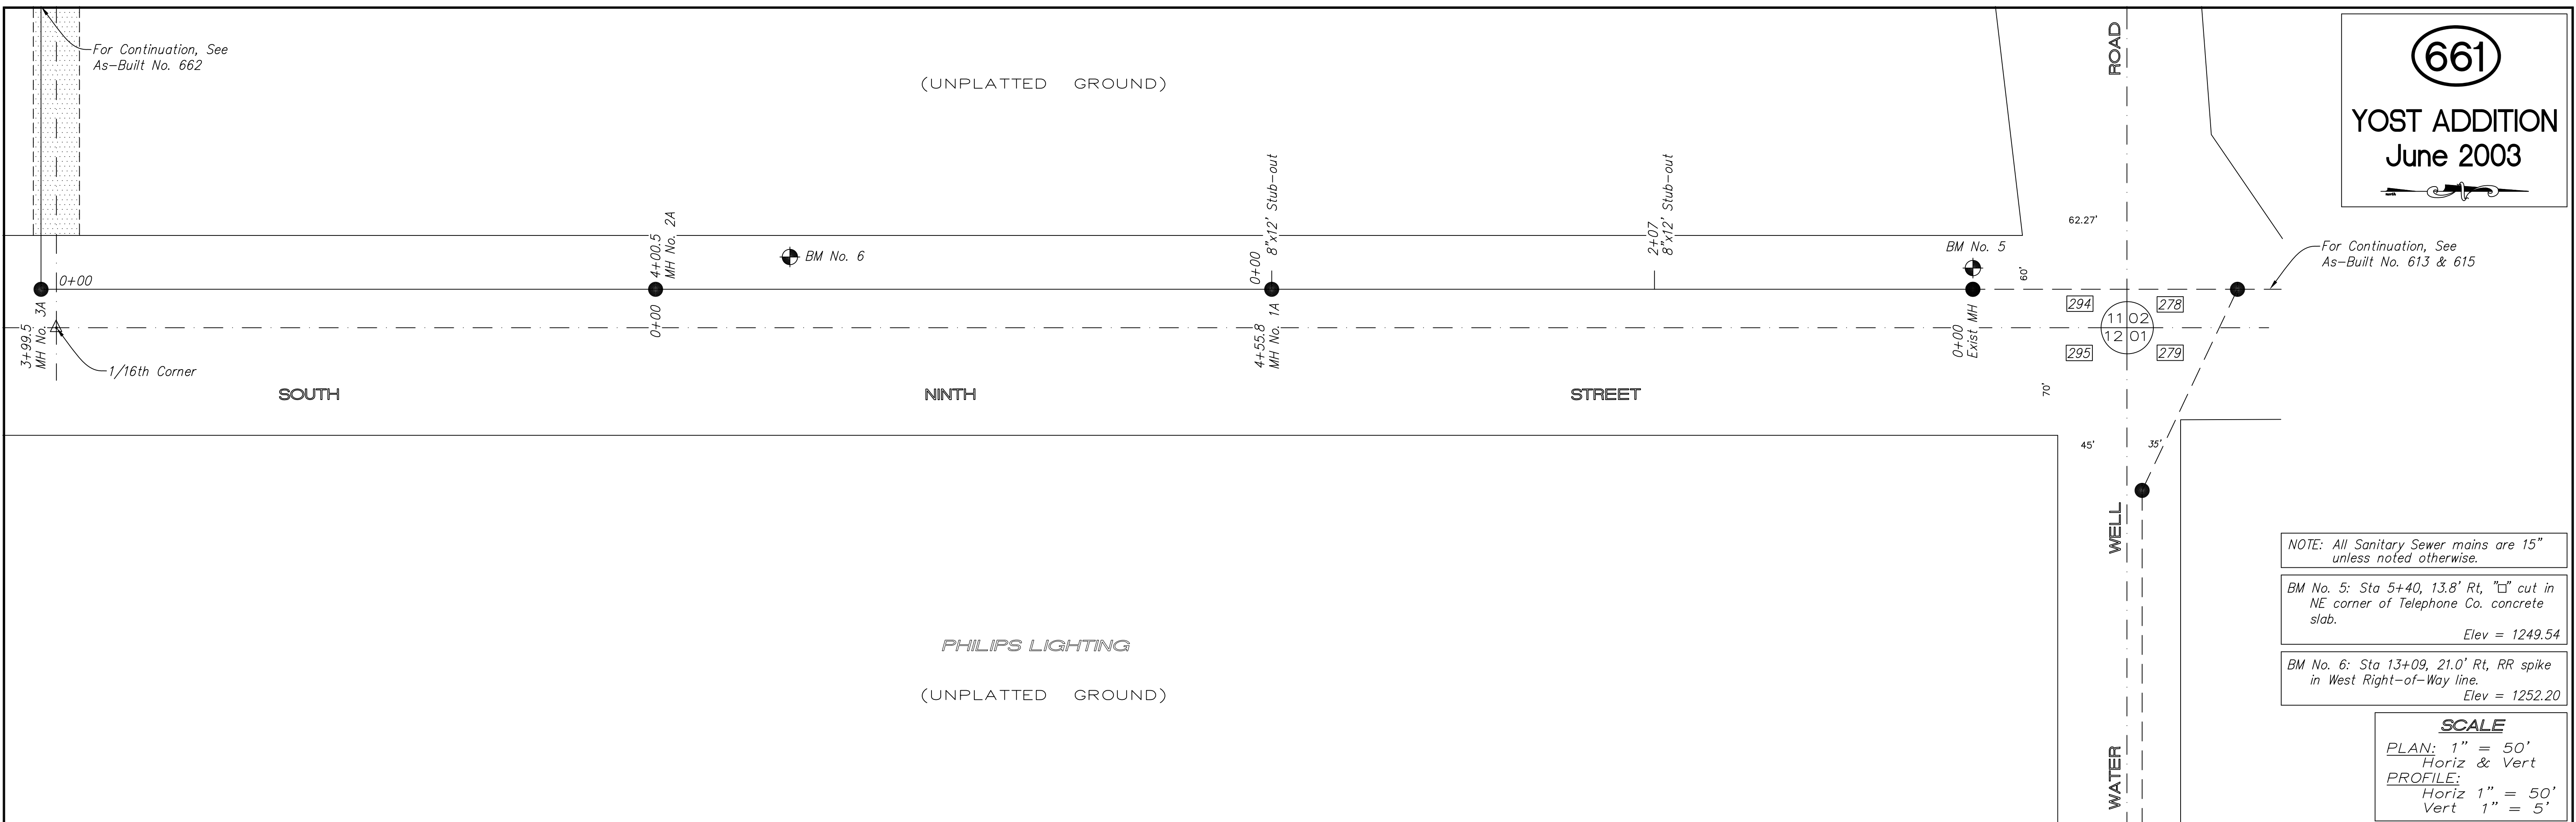

PROJECT TITLE						CONTRACTOR		DESIGN		CHECKED		CITY OF SALINA		DATE		PROJ. NO.	
Sanitary Sewer As-Built Drawing						Steven's Contractors						Dept. of Public Works		June 2005		03-1423	
						SCALE		DRAWN		APPROVED		Engineering Division		FILENAME		SHEET	
NO.		REVISIONS		DATE		BY		As Shown				300 WEST ASH SALINA, KANSAS 67401		661k.dwg			
												Ph: 785.309.5725 FAX: 785.309.5713					