


For Continuation, See
As-Built No. 662

NOTE: All Sanitary Sewer mains are 15" unless noted otherwise.

BM No. 1: 5/8" bar @ the Northwest of gas riser on the West line of Bland Subdivision.
Elev = 1245.19

BM No. 2: 60d nail in East side light pole 100'± East of the metal building at 332 East Schilling.
Elev = 1247.04

SCALE
 PLAN: 1" = 50'
 Horiz & Vert
 PROFILE: 1" = 50'
 Vert 1" = 5'

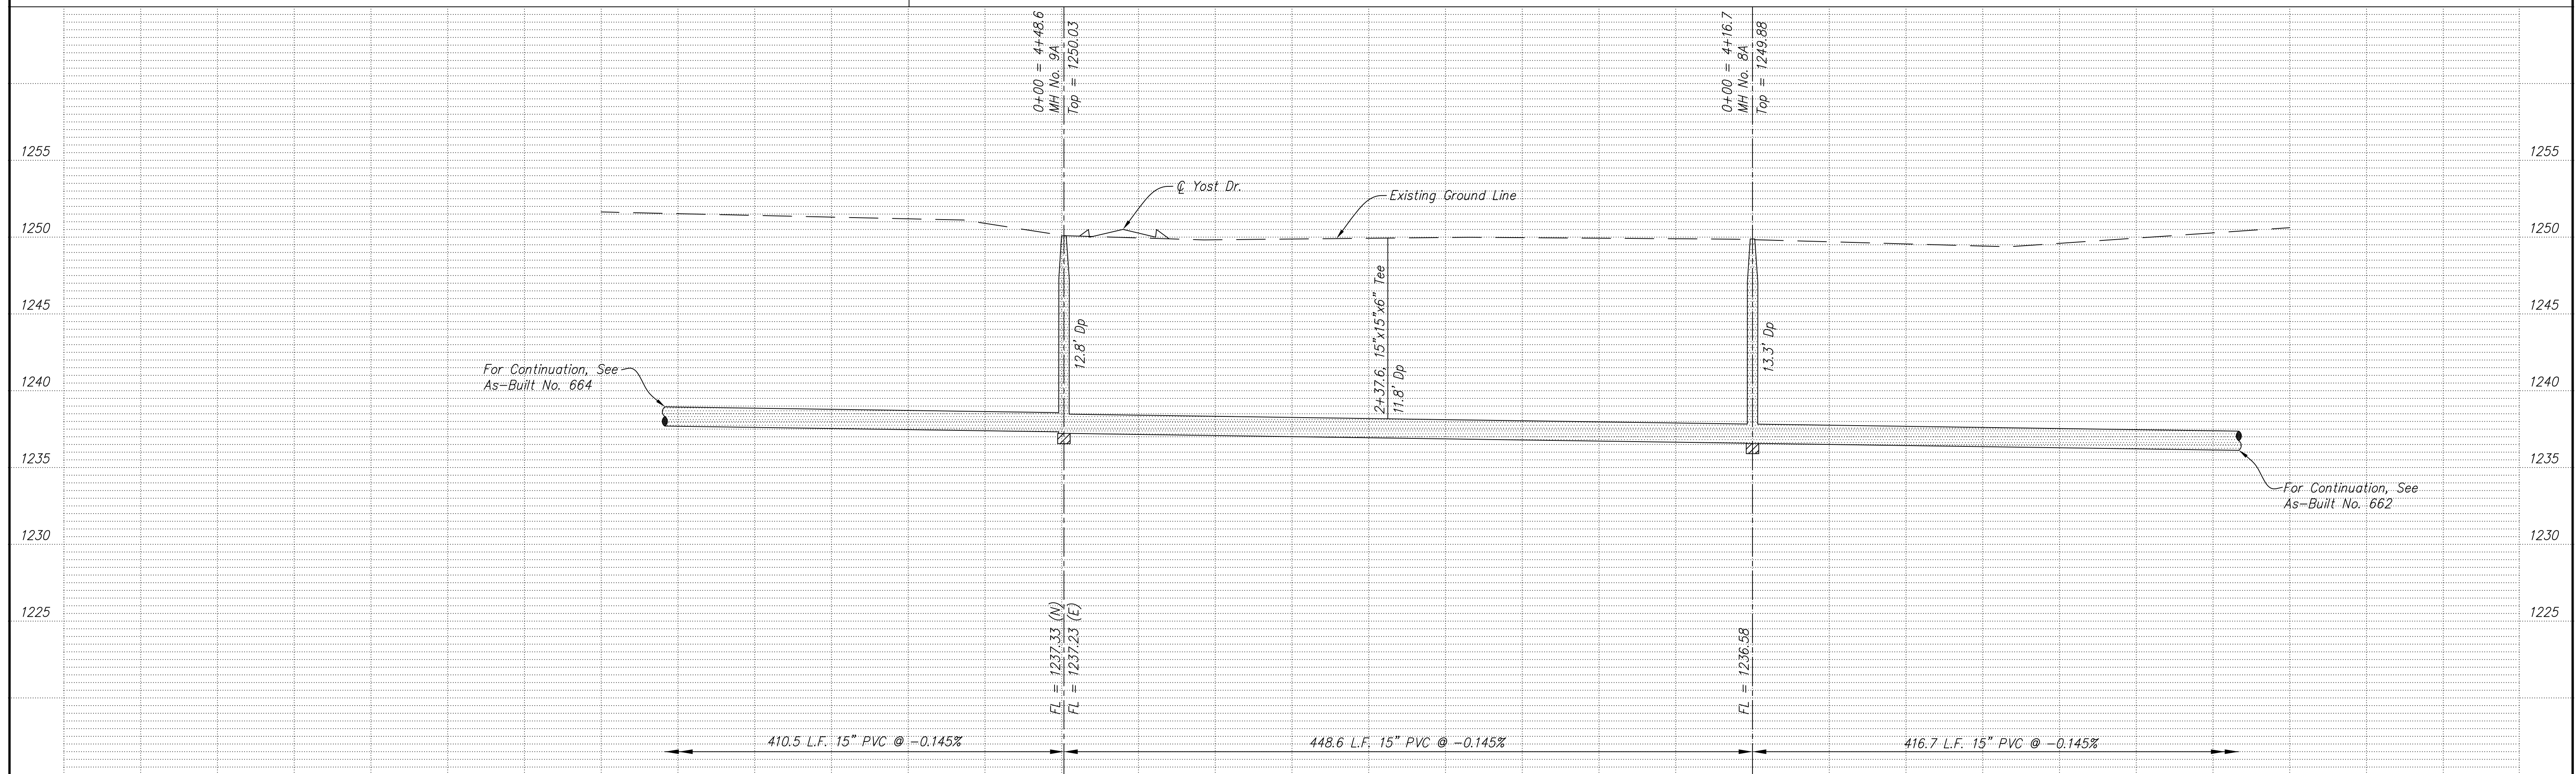

NO.	REVISIONS	DATE	BY

PROJECT TITLE:
Sanitary Sewer As-Built Drawing

CONTRACTOR: Steven's Contractors	DESIGN: 	CHECKED: 	CITY OF SALINA Dept. of Public Works Engineering Division	DATE: June 2005	PROJ. NO.:
SCALE: As Shown	DRAWN: 	APPROVED: 		FILENAME: 663k.dwg	03-1423