


**667**  
**RIVER TRAIL ADDITION**  
**PHASE 4**  
**JULY 2005**

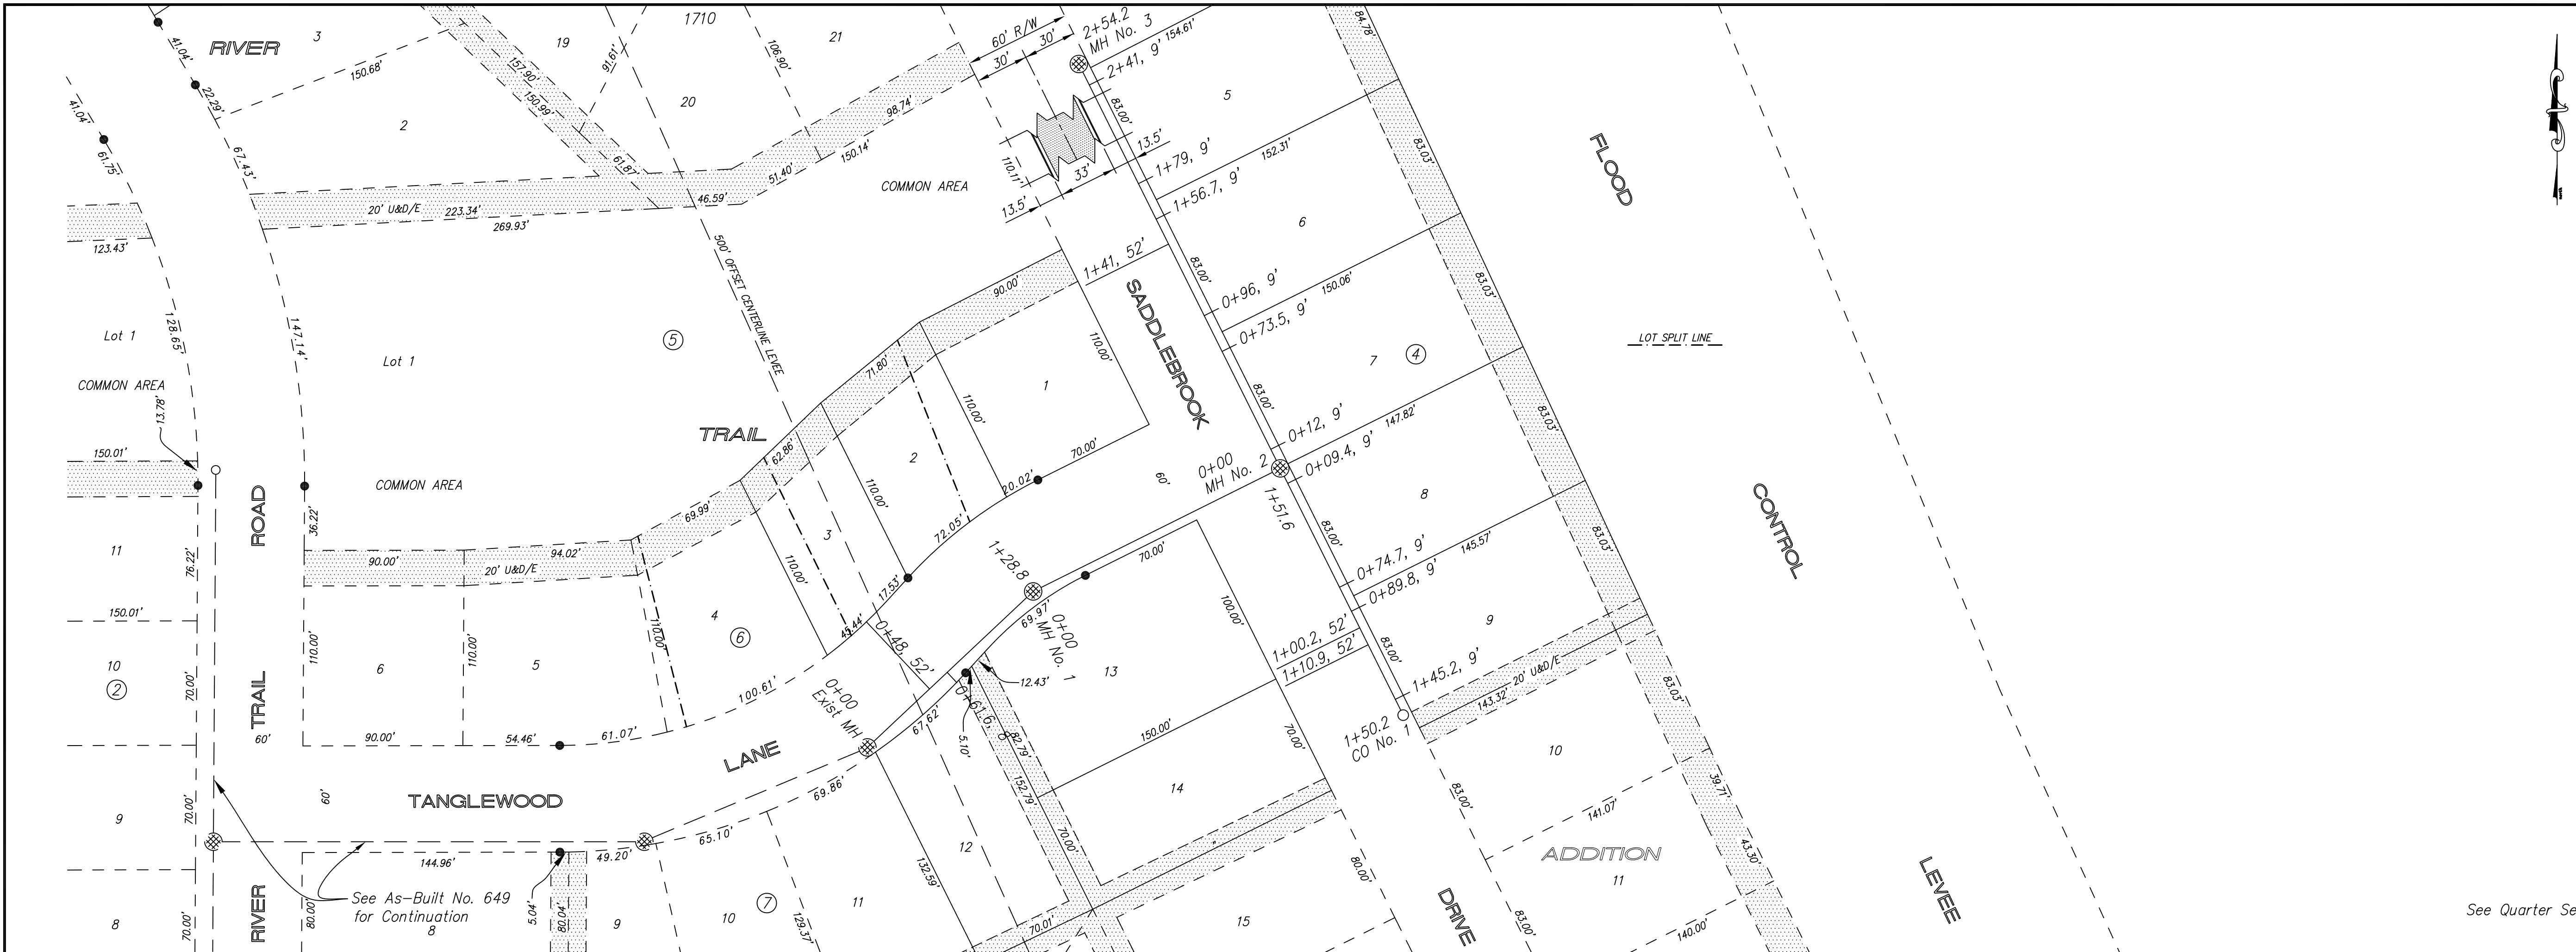

NOTE: Distance from back of curb to property line is based on the street being built in the center of the right-of-way.


NOTE: All Streets are 33' back to back of curb. Right-of-Ways are 60' unless noted otherwise.

NOTE: All Sanitary Sewer mains are 8" unless noted otherwise.

BM No. 1: Chiseled " " SE corner concrete Well Diversion Structure.  
 Approx Coordinates: N 11171.1024, E 9295.8102  
 Elev = 1245.67

**SCALE**  
 PLAN: 1" = 50'  
 Horiz & Vert  
 PROFILE: 1" = 50'  
 Horiz 1" = 50'  
 Vert 1" = 5'

See Quarter Section Map Book Page 218

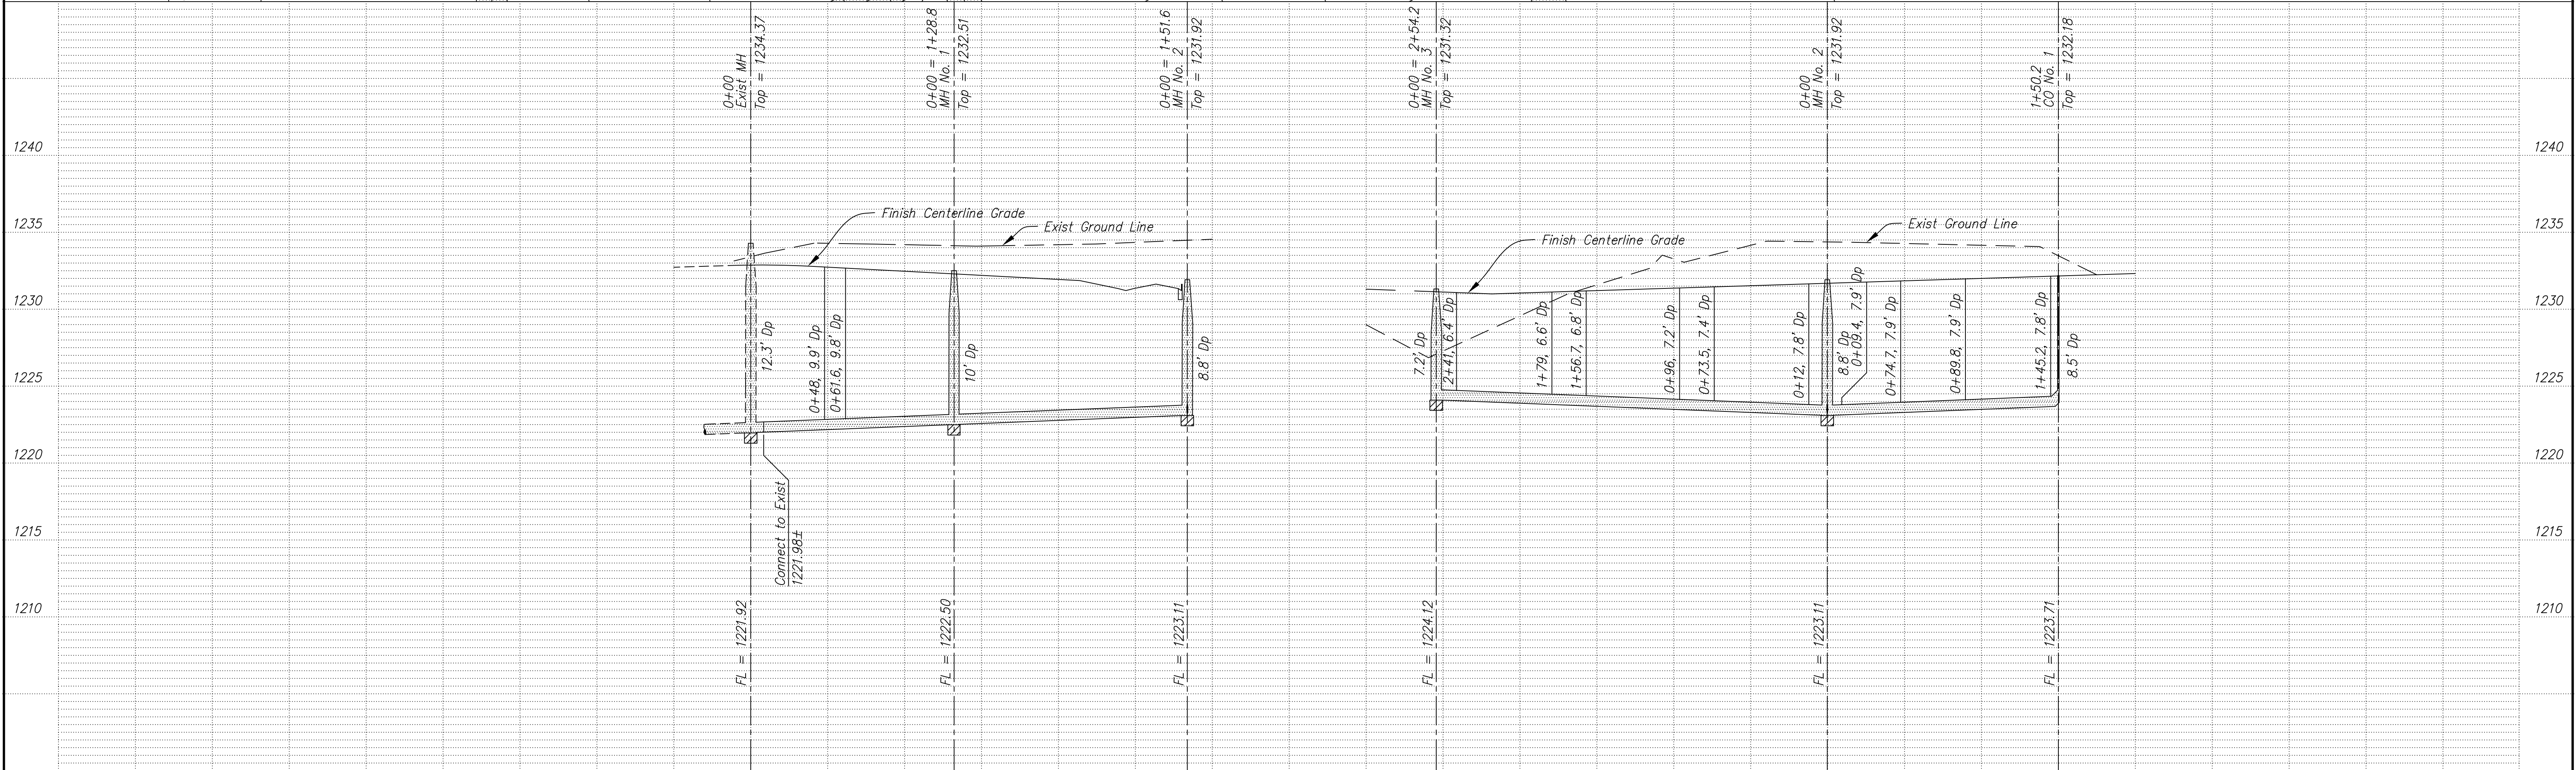

NO.	REVISIONS	DATE	BY

PROJECT TITLE:  
**Sanitary Sewer As-Built Drawing**

CONTRACTOR: Stevens Contractors	DESIGN:	CHECKED:	CITY OF SALINA Dept. of Public Works Engineering Division	DATE:	Dec 2005	PROJ. NO.:	Private
SCALE: As Shown	DRAWN:	APPROVED:		FILENAME:	667k.dwg	SHEET:	OF: