


SCALE
 PLAN: 1" = 50'
 Horiz & Vert
 PROFILE:
 Horiz 1" = 50'
 Vert 1" = 5'

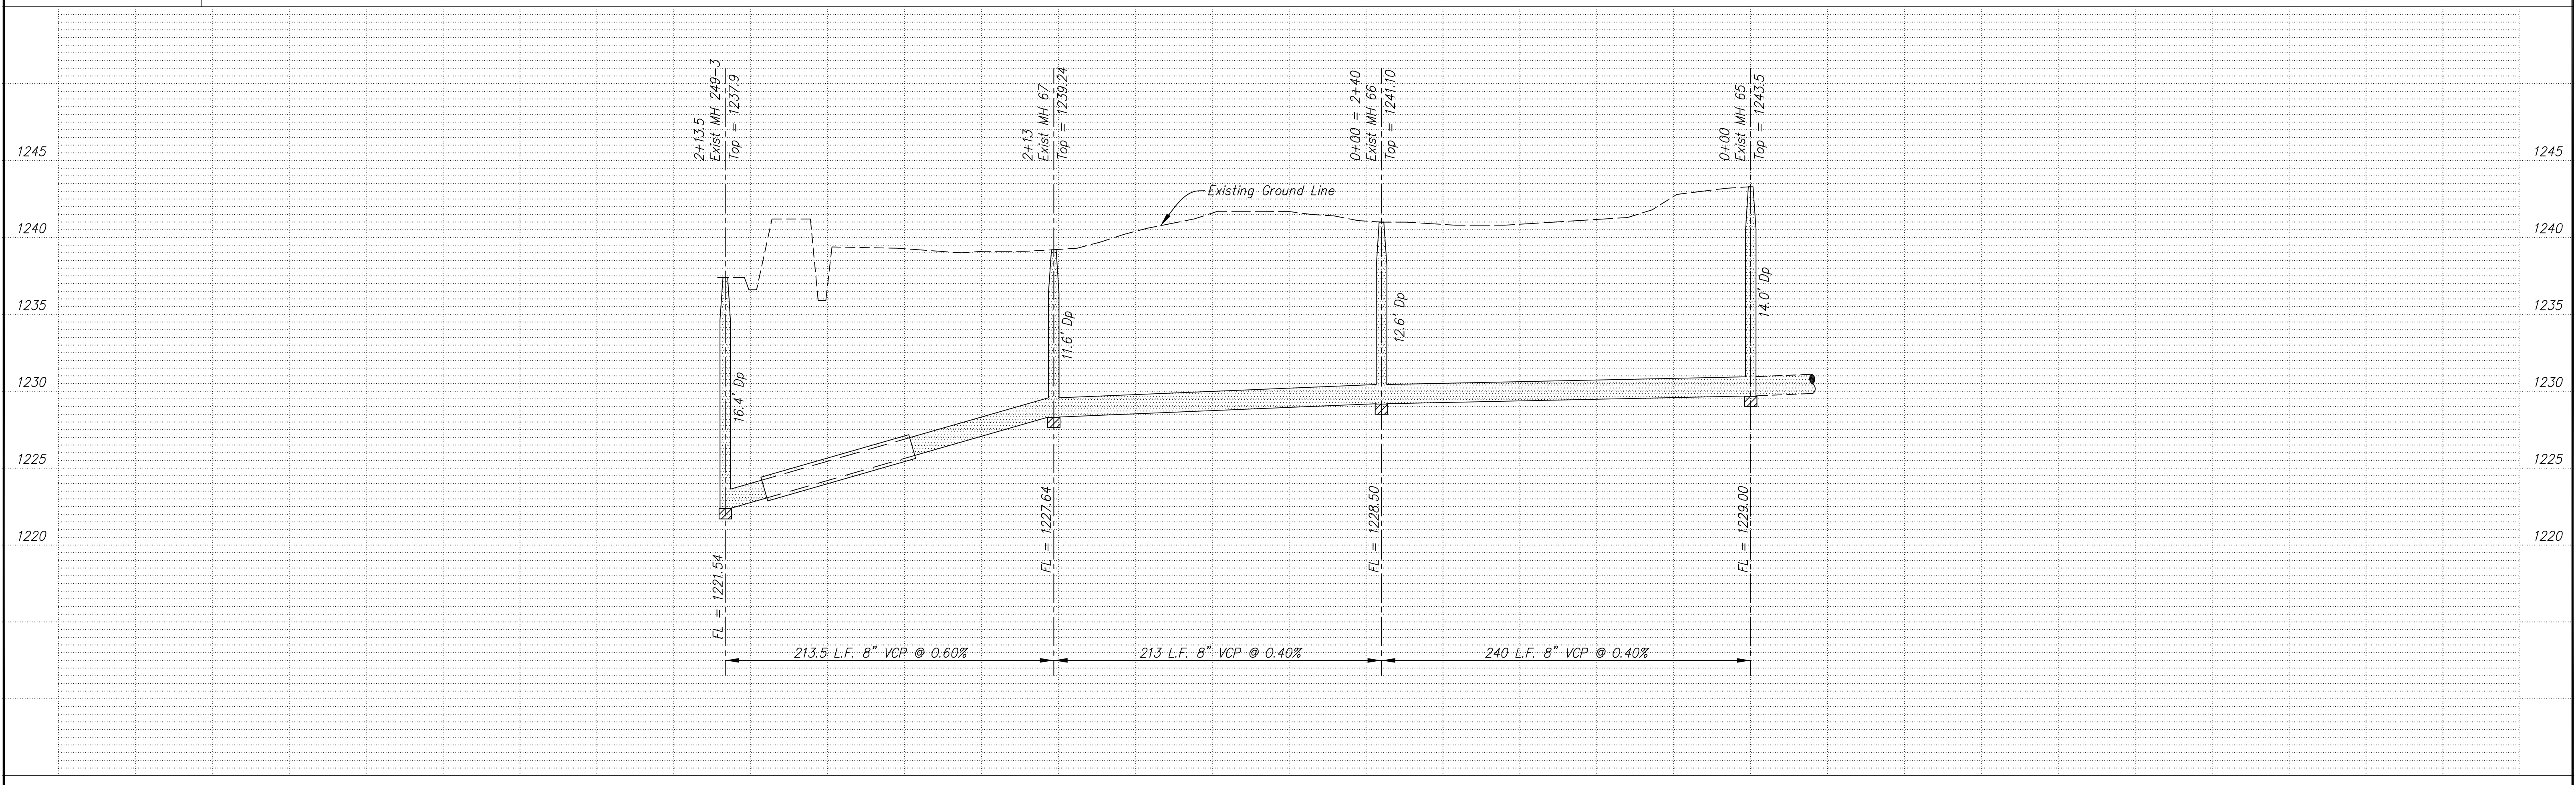

PROJECT TITLE						CONTRACTOR		DESIGN	CHECKED	CITY OF SALINA		DATE	PROJ. NO.
Sanitary Sewer As-Built Drawing						Steven's Contractors				Dept. of Public Works		Sept 2005	Private
						SCALE		DRAWN	APPROVED	Engineering Division		FILENAME	SHEET
						As Shown				300 WEST ASH SALINA, KANSAS 67401		668D.dwg	OF
										PH: 785.309.5725 FAX: 785.309.5713			