


700

GOLDEN EAGLE ESTATES ADDITION NO. 5 JANUARY 2009

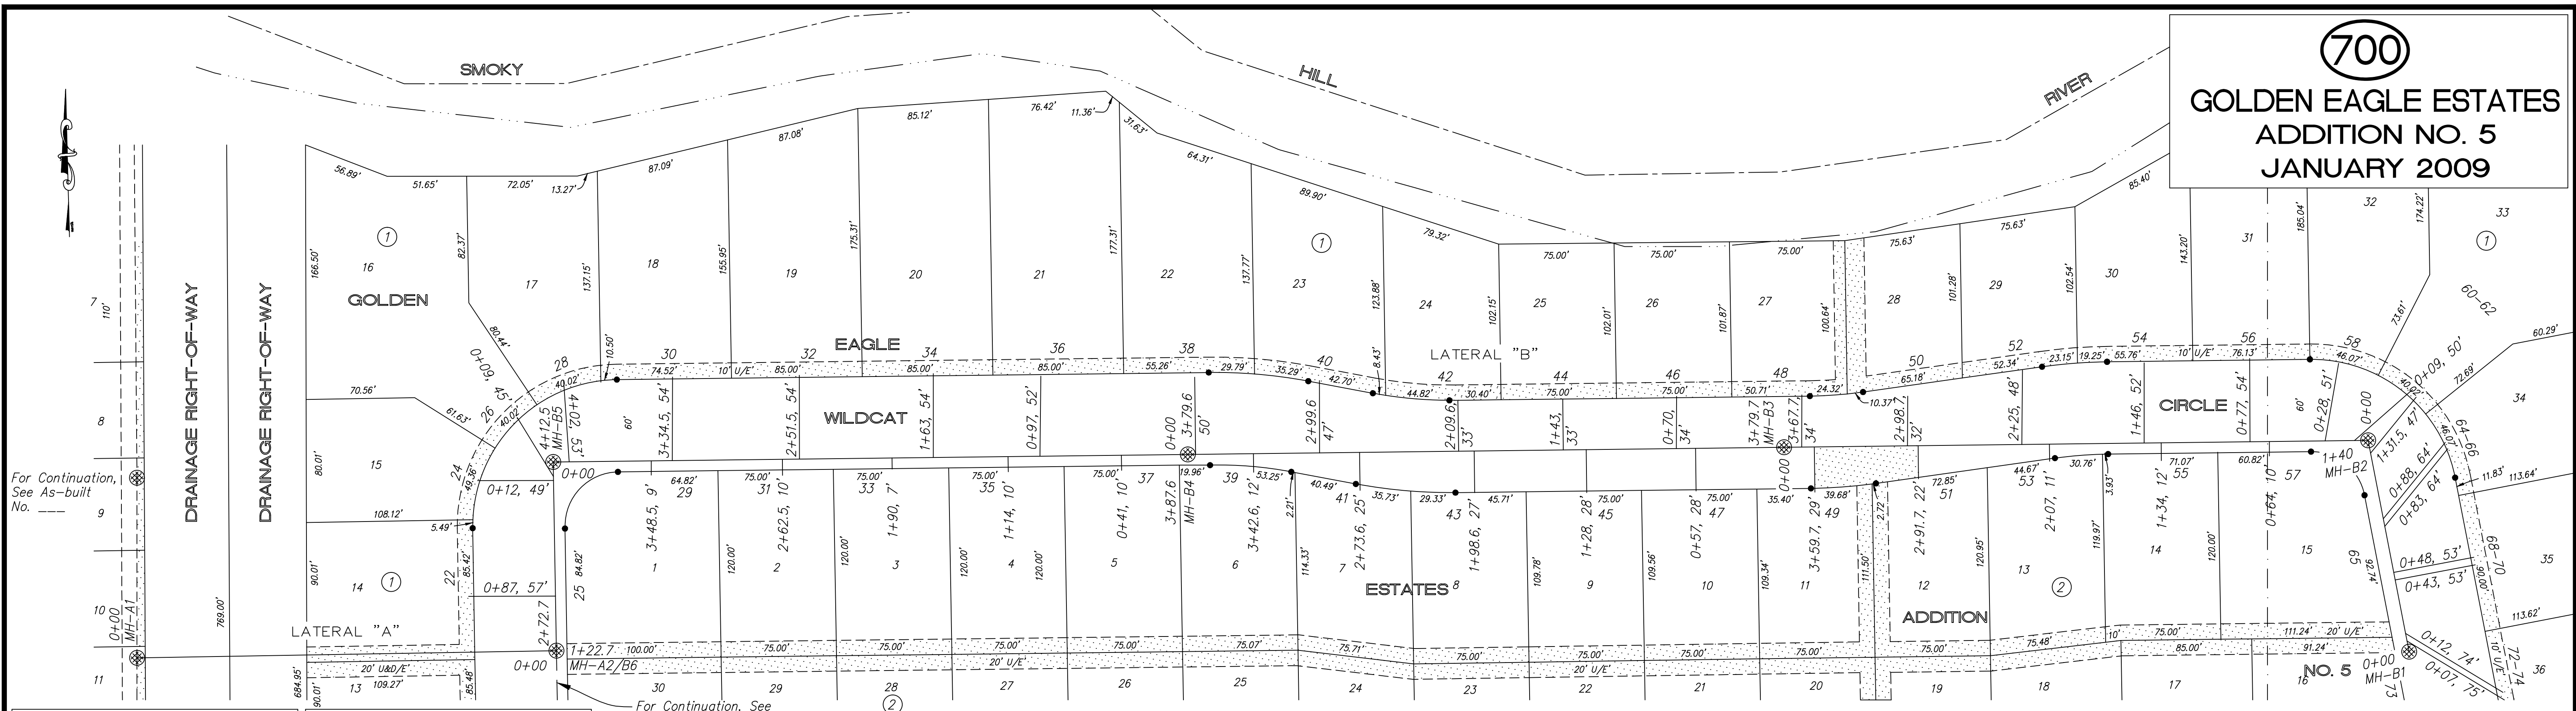

NOTE: Sanitary Sewer Service connection depths are from the Existing Ground Line at the time of construction.

NOTE: All Sanitary Sewer mains are 8" unless noted otherwise.

HORIZONTAL CONTROL: Chiseled square on the South End of Return at the Southwest Corner of Wayne Avenue & Southbound Huntington Road. Elev = 1229.45

NOTE: Distance from back of curb to property line is based on the street being built in the center of the right-of-way.

NOTE: All Streets are 33' back to back of curb. Right-of-Ways are 60' unless noted otherwise.

NOTE: Distance from back of curb to property line is based on the street being built in the center of the right-of-way.

HORIZONTAL CONTROL: Chiseled square on the South End of Return at the Southwest Corner of Wayne Avenue & Southbound Huntington Road. Elev = 1229.45

NOTE: Distance from back of curb to property line is based on the street being built in the center of the right-of-way.

SCALE PLAN: 1" = 50' Horiz & Vert PROFILE: 1" = 50' Horiz 1" = 5' Vert

See Quarter Section Map Book Page 201 202

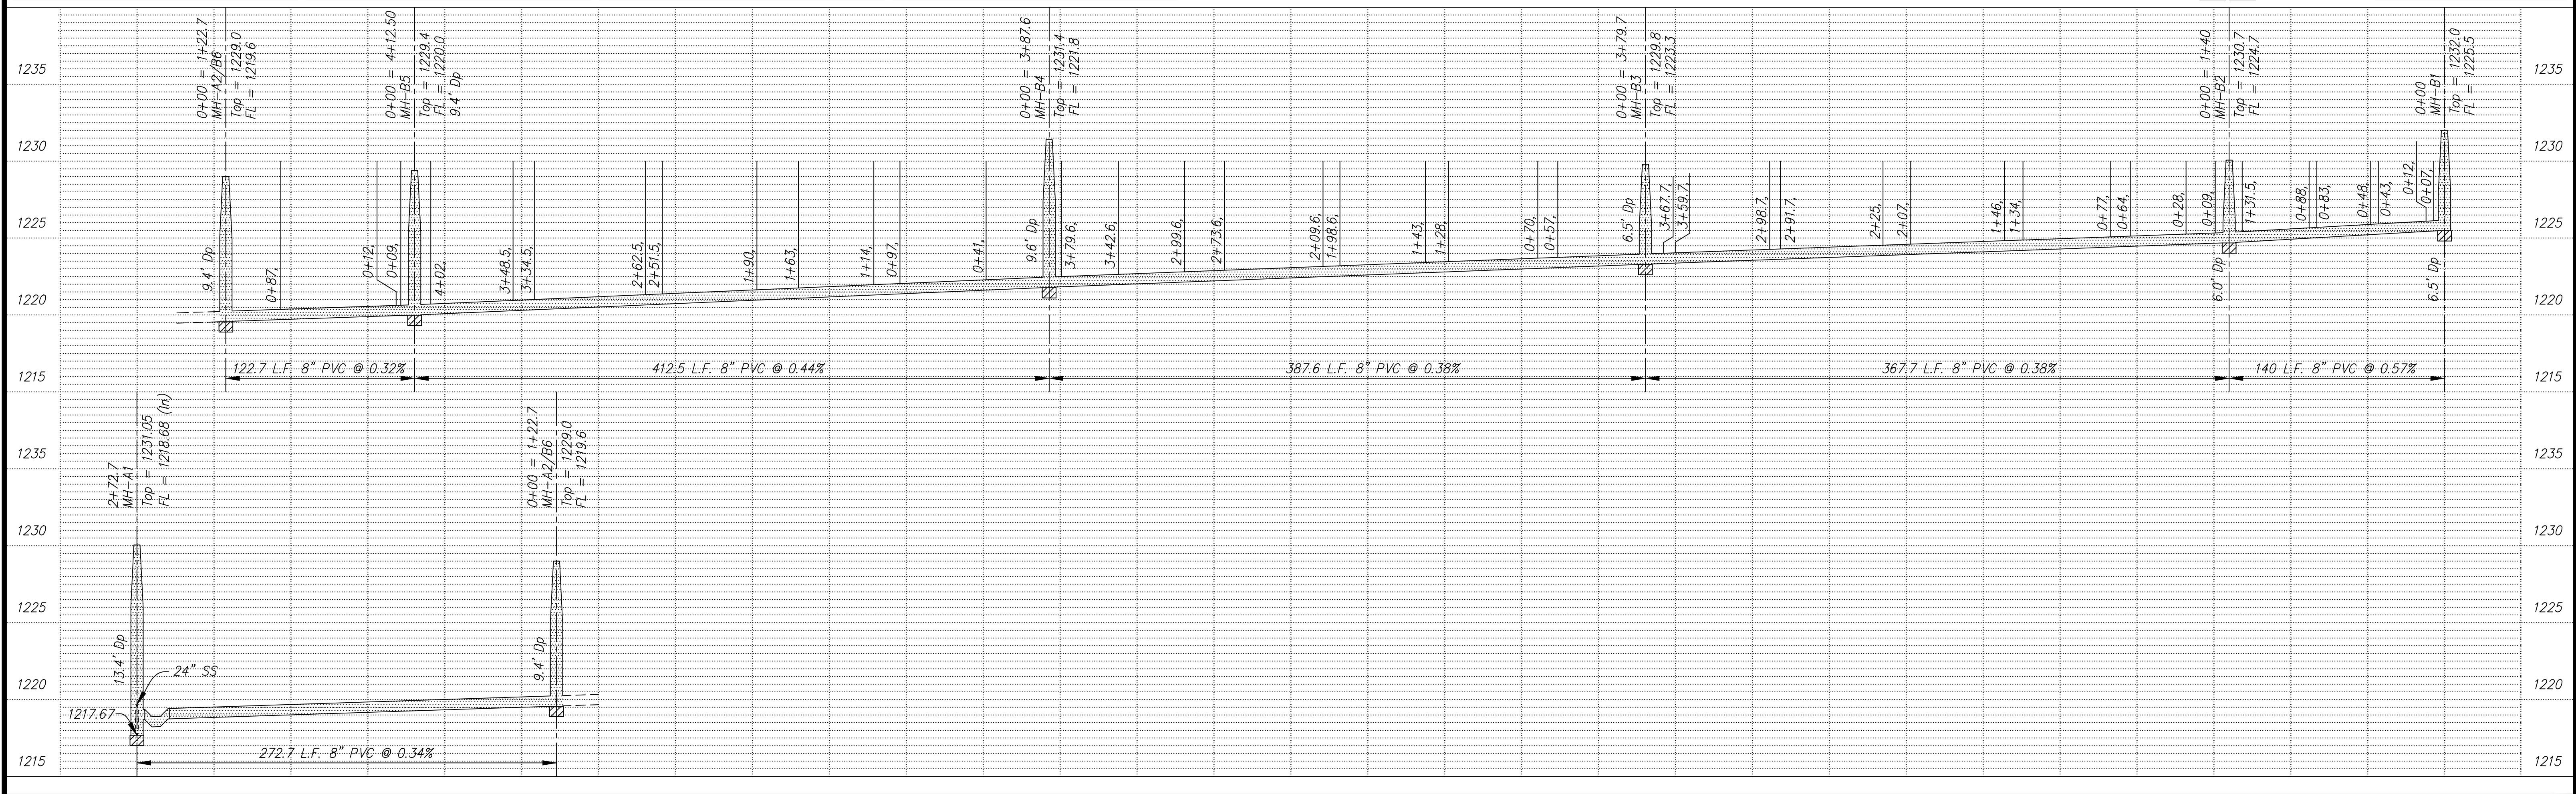


Table with columns for NO., REVISIONS, DATE, BY.

PROJECT TITLE: Sanitary Sewer As-Built Drawing

Table with columns for CONTRACTOR, DESIGN, CHECKED, APPROVED, CITY OF SALINA, DATE, PROJ. NO., SHEET, OF.