


705


MEADOW POINTE ADDITION
JANUARY - 2009

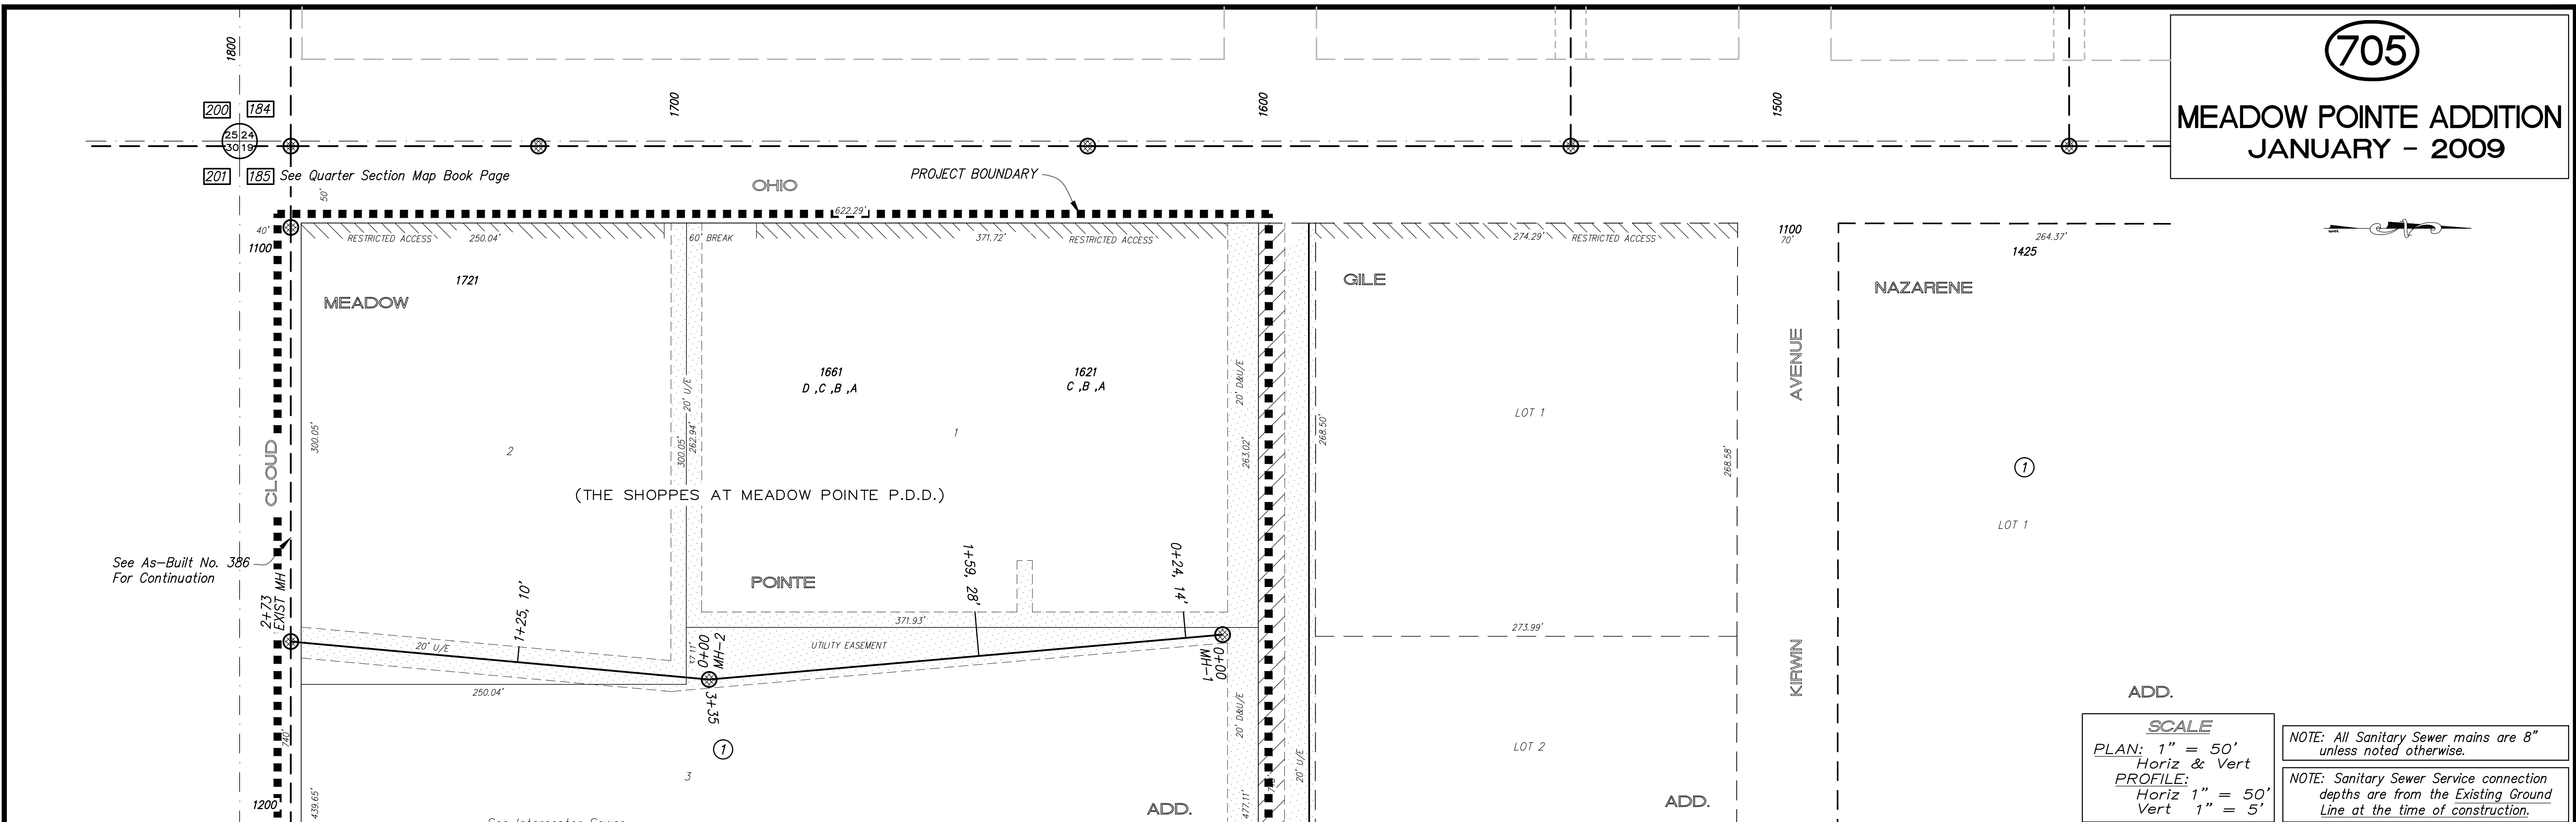

SCALE
 PLAN: 1" = 50'
 Horiz & Vert
 PROFILE: Horiz 1" = 50'
 Vert 1" = 5'

NOTE: All Sanitary Sewer mains are 8" unless noted otherwise.

NOTE: Sanitary Sewer Service connection depths are from the Existing Ground Line at the time of construction.

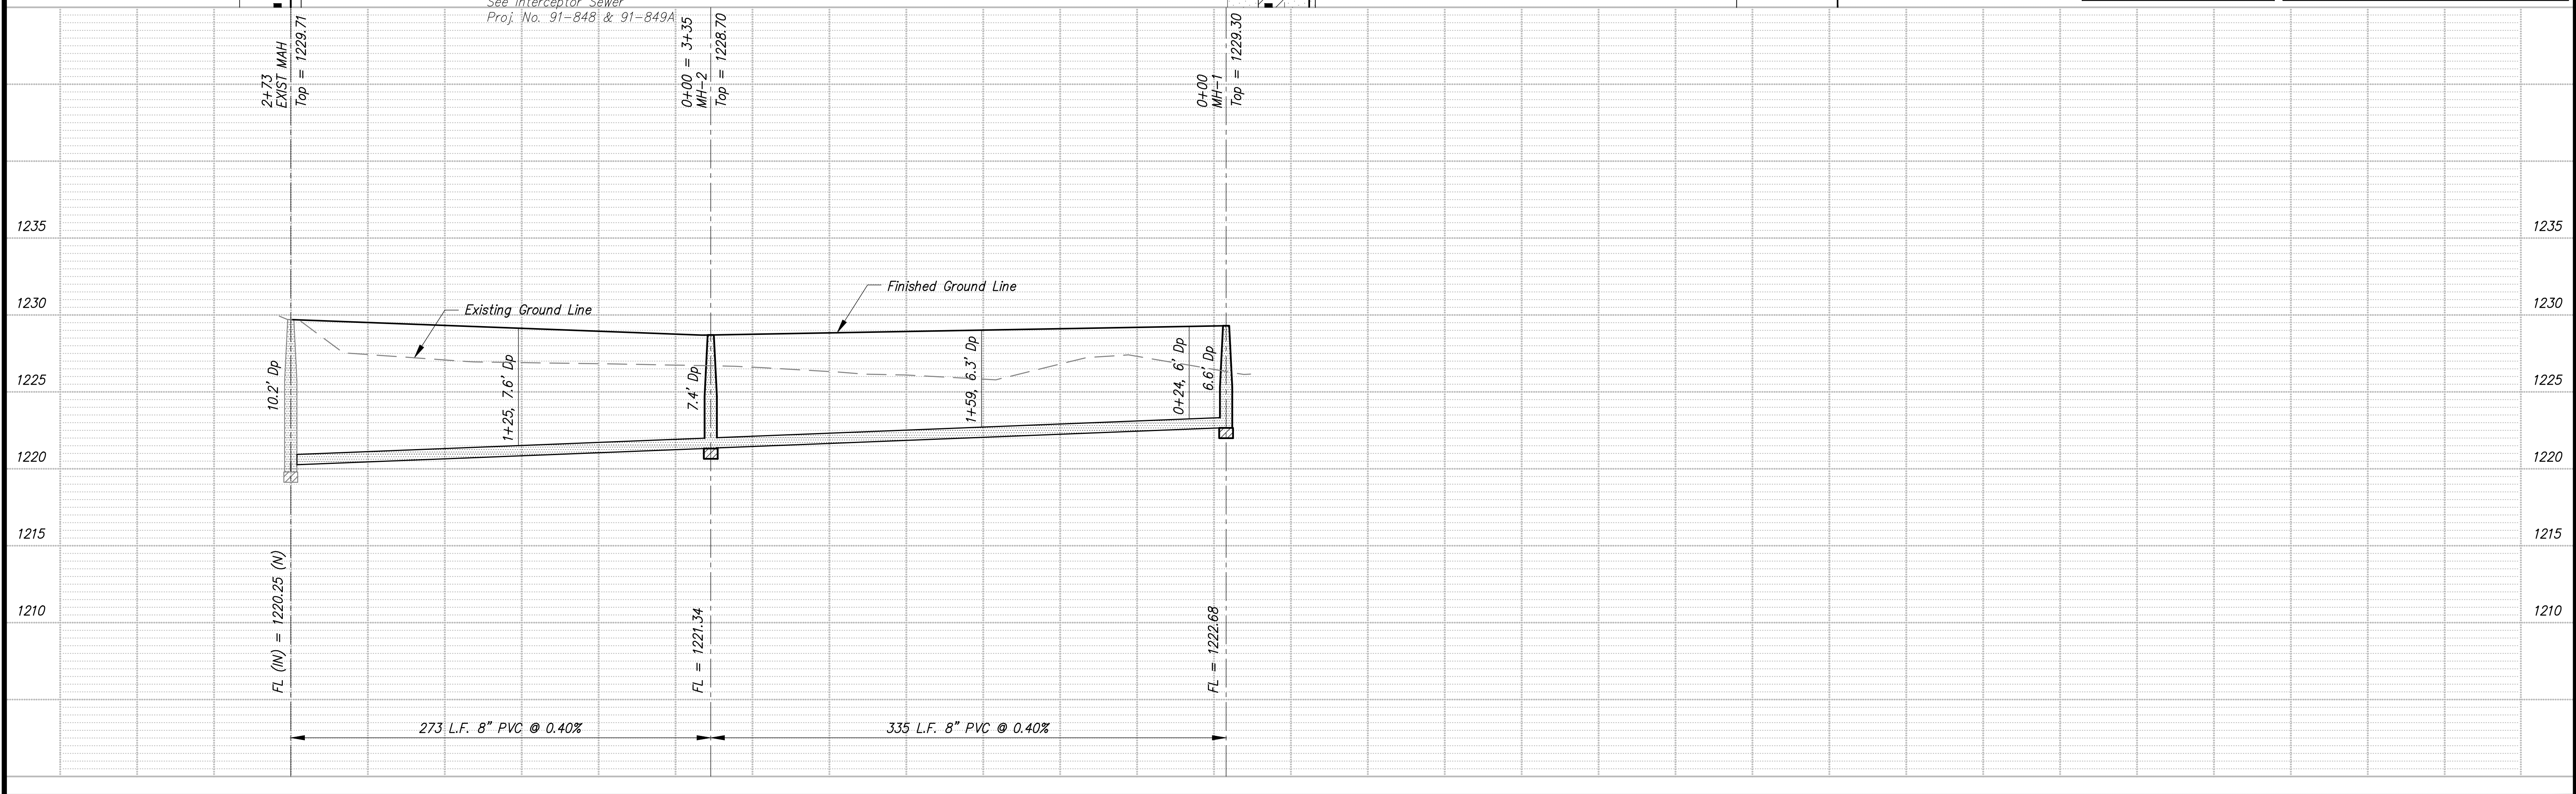

PROJECT TITLE: Sanitary Sewer As-Built Drawing						CONTRACTOR: Steven's	DESIGN:	CHECKED:	CITY OF SALINA Dept. of Public Works Engineering Division		DATE: August 2009	PROJ. NO.: PRIVATE
NO. REVISIONS DATE BY						SCALE: As Shown	DRAWN:	APPROVED:	300 WEST ASH SALINA, KANSAS 67401 PH: 785.309.5725 FAX: 785.309.5713		FILENAME: 705asb.dwg	SHEET: OF: