




785-520-7106

**Notes**  
 Δ Sanitary Sewer Lines crossing less than 2 feet below water lines shall be SDR 26 PVC pipe as specified. Joints in the sewer pipe shall be located as far as practical from the intersected main.  
 ΔΔ Where sanitary sewer line are less than 2 feet above water lines the sewer shall be encased in concrete with a minimum of 6-inch thickness for a 10 foot distance on each side of crossing.

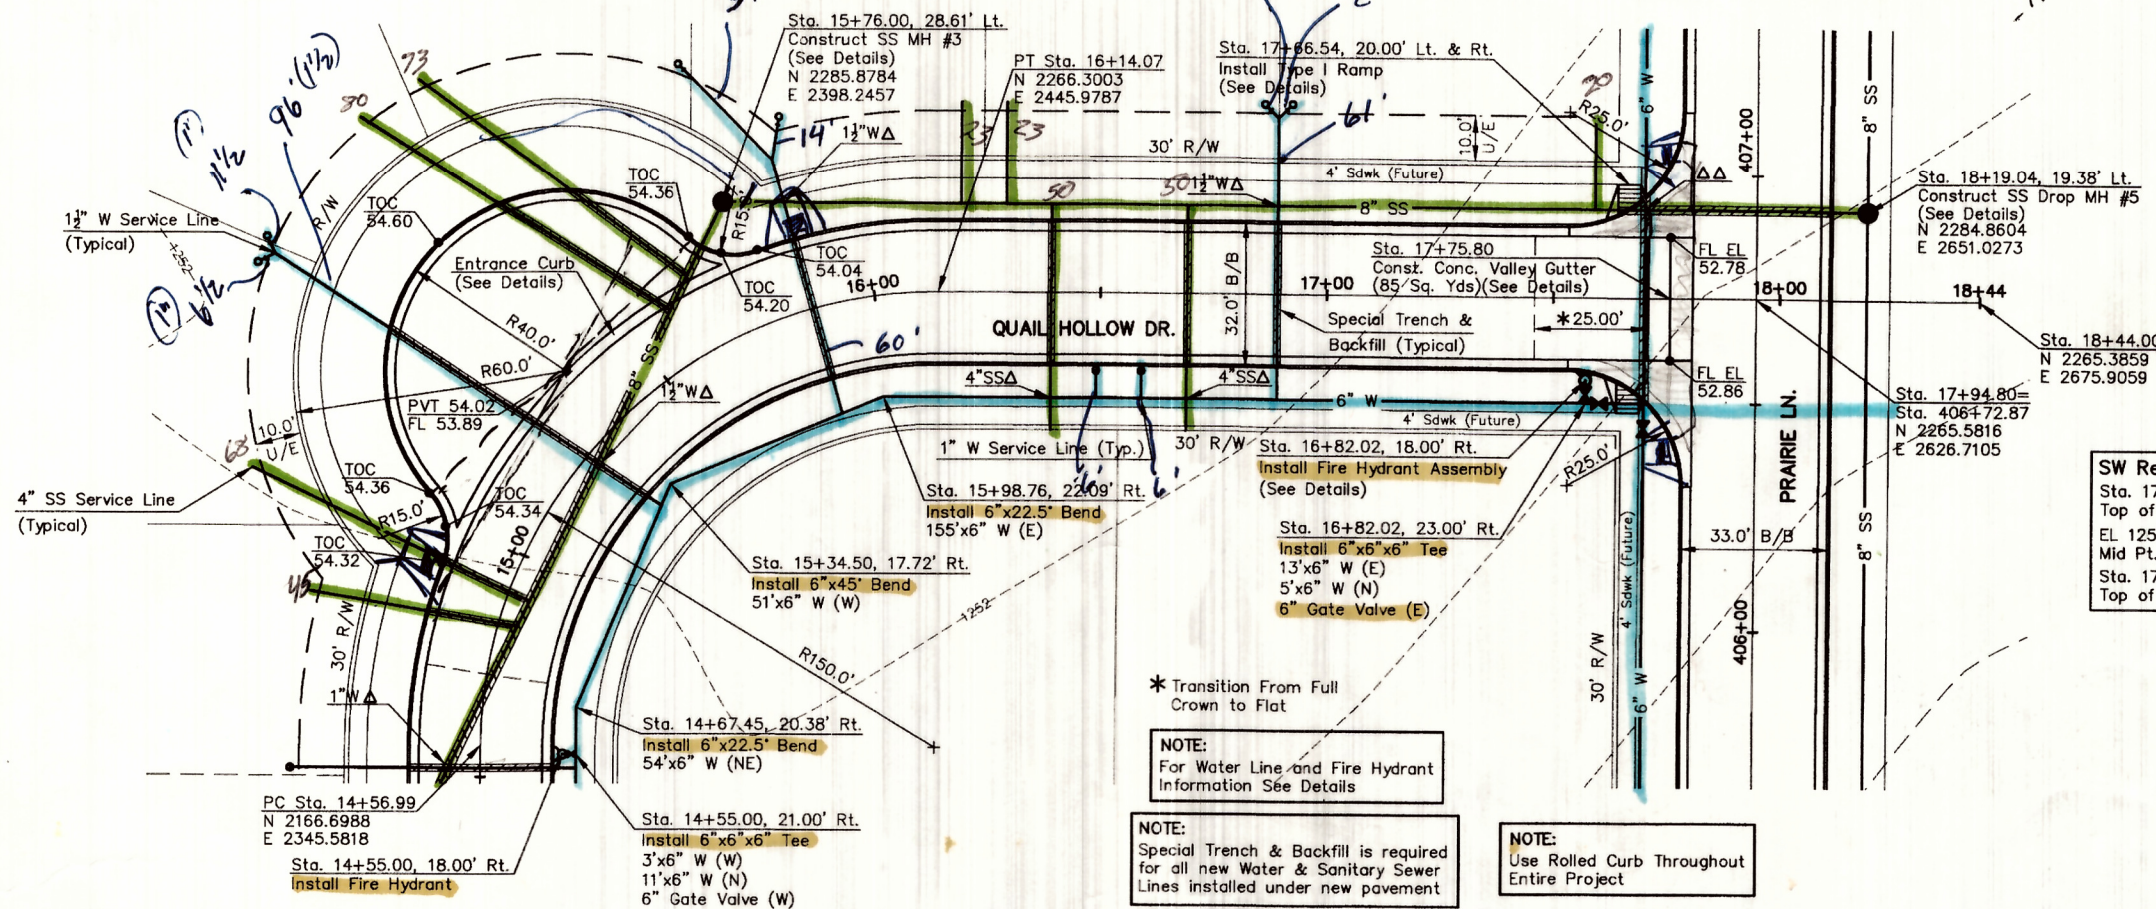

**NW Return**  
 Sta. 17+48.30 EL 1253.34  
 Top of Curb @ Return  
 EL 1253.18 Top of Curb  
 Mid Pt. Return  
 Sta. 17+78.30 EL 1253.00  
 Top of Curb @ Return

**SW Return**  
 Sta. 17+53.30 EL 1253.27  
 Top of Curb @ Return  
 EL 1253.22 Top of Curb  
 Mid Pt. Return  
 Sta. 17+78.30 EL 1253.34  
 Top of Curb @ Return


\* Transition From Full Crown to Flat  
**NOTE:**  
 For Water Line and Fire Hydrant Information See Details

**NOTE:**  
 Special Trench & Backfill is required for all new Water & Sanitary Sewer Lines installed under new pavement


**NOTE:**  
 Use Rolled Curb Throughout Entire Project

SCALE:  
 PLAN: 1" = 20'  
 PROFILE: HORIZONTAL: 1" = 20'  
 VERTICAL: 1" = 4'

Project: 09-07  
 Description: Welsh Private  
 Title:  
 Path: F: 2009\09-07\Private Project\Welsh Private Master  
 File Name: Hollow Cir.  
 Last Revision:  
 Project: 09-07  
 Description: Welsh Private  
 Title:  
 Path: F: 2009\09-07\Private Project\Welsh Private Master  
 File Name: Hollow Cir.  
 Last Revision:

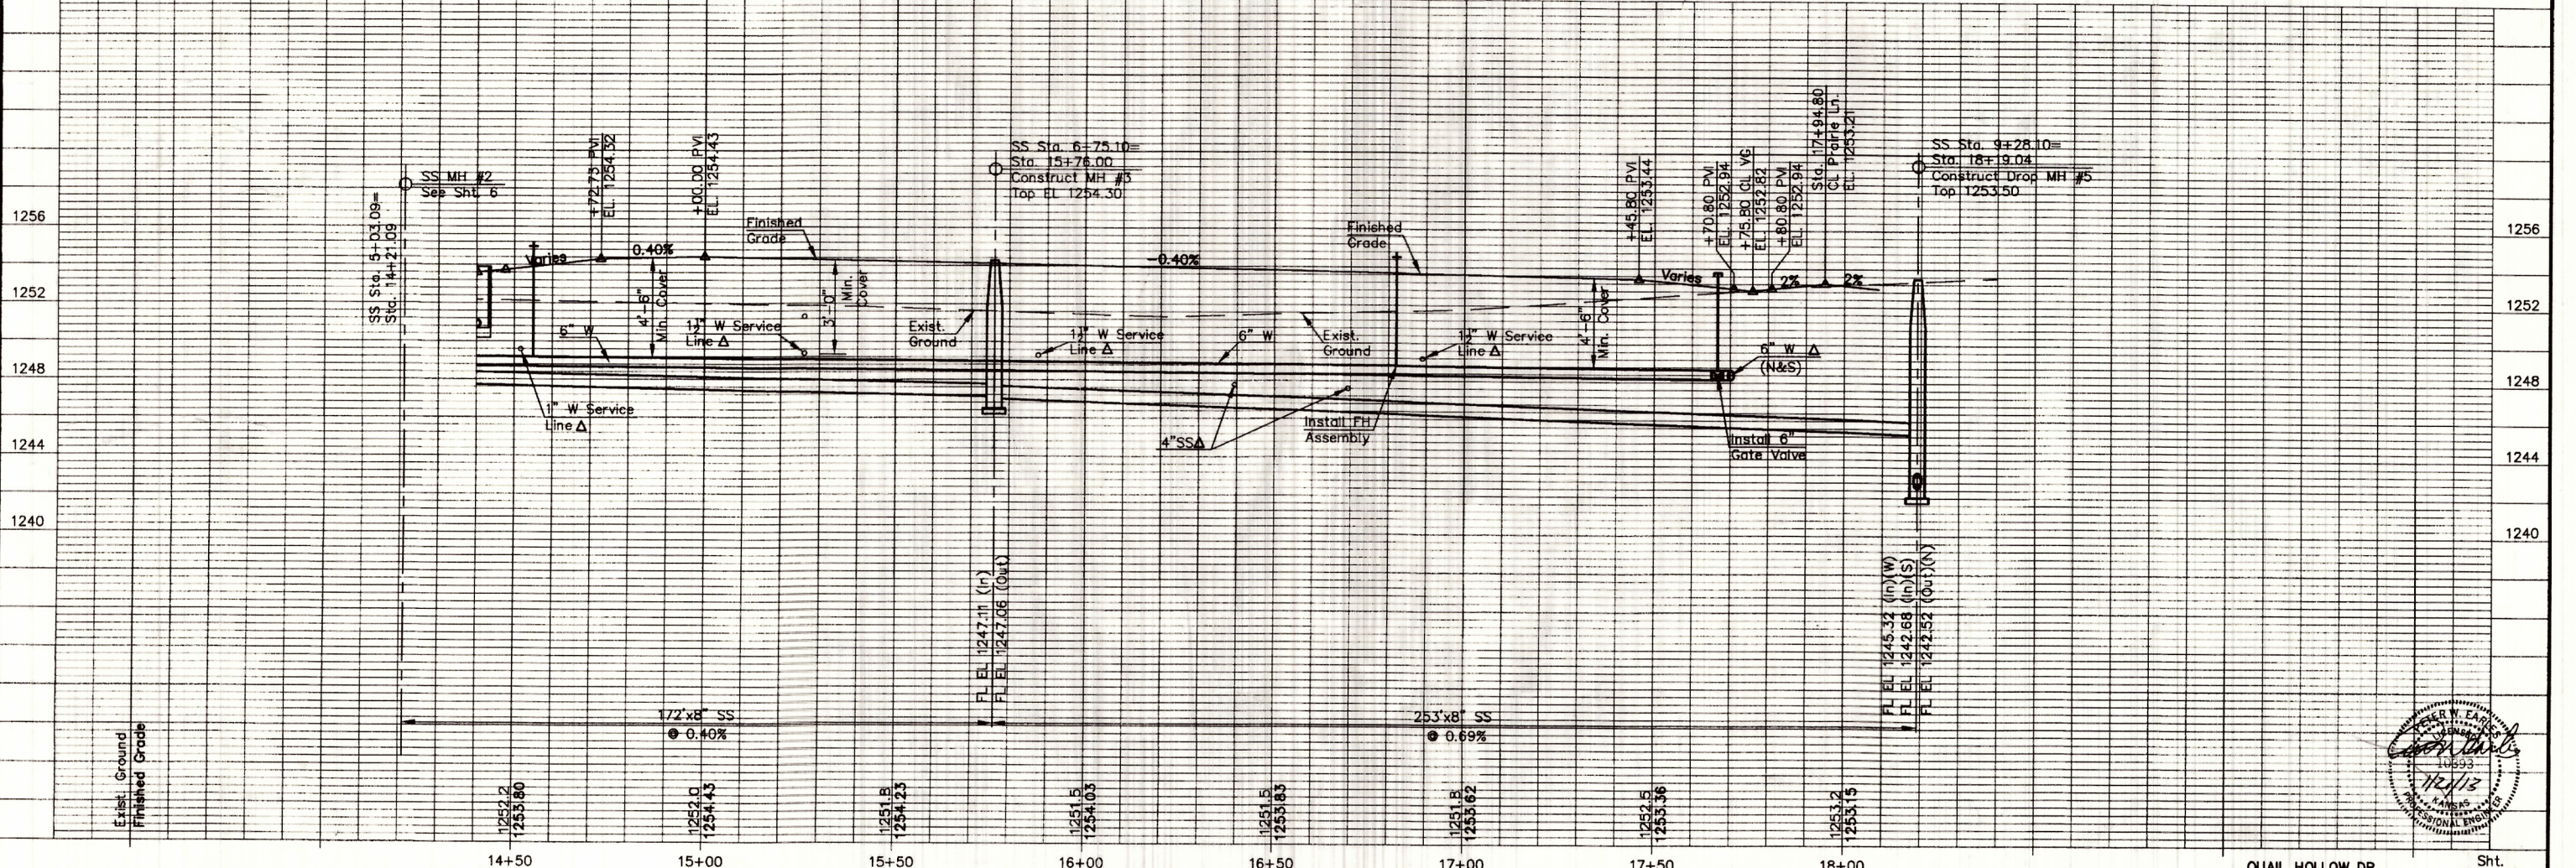

Professional Engineer  
 Seal and Signature  
 12/13

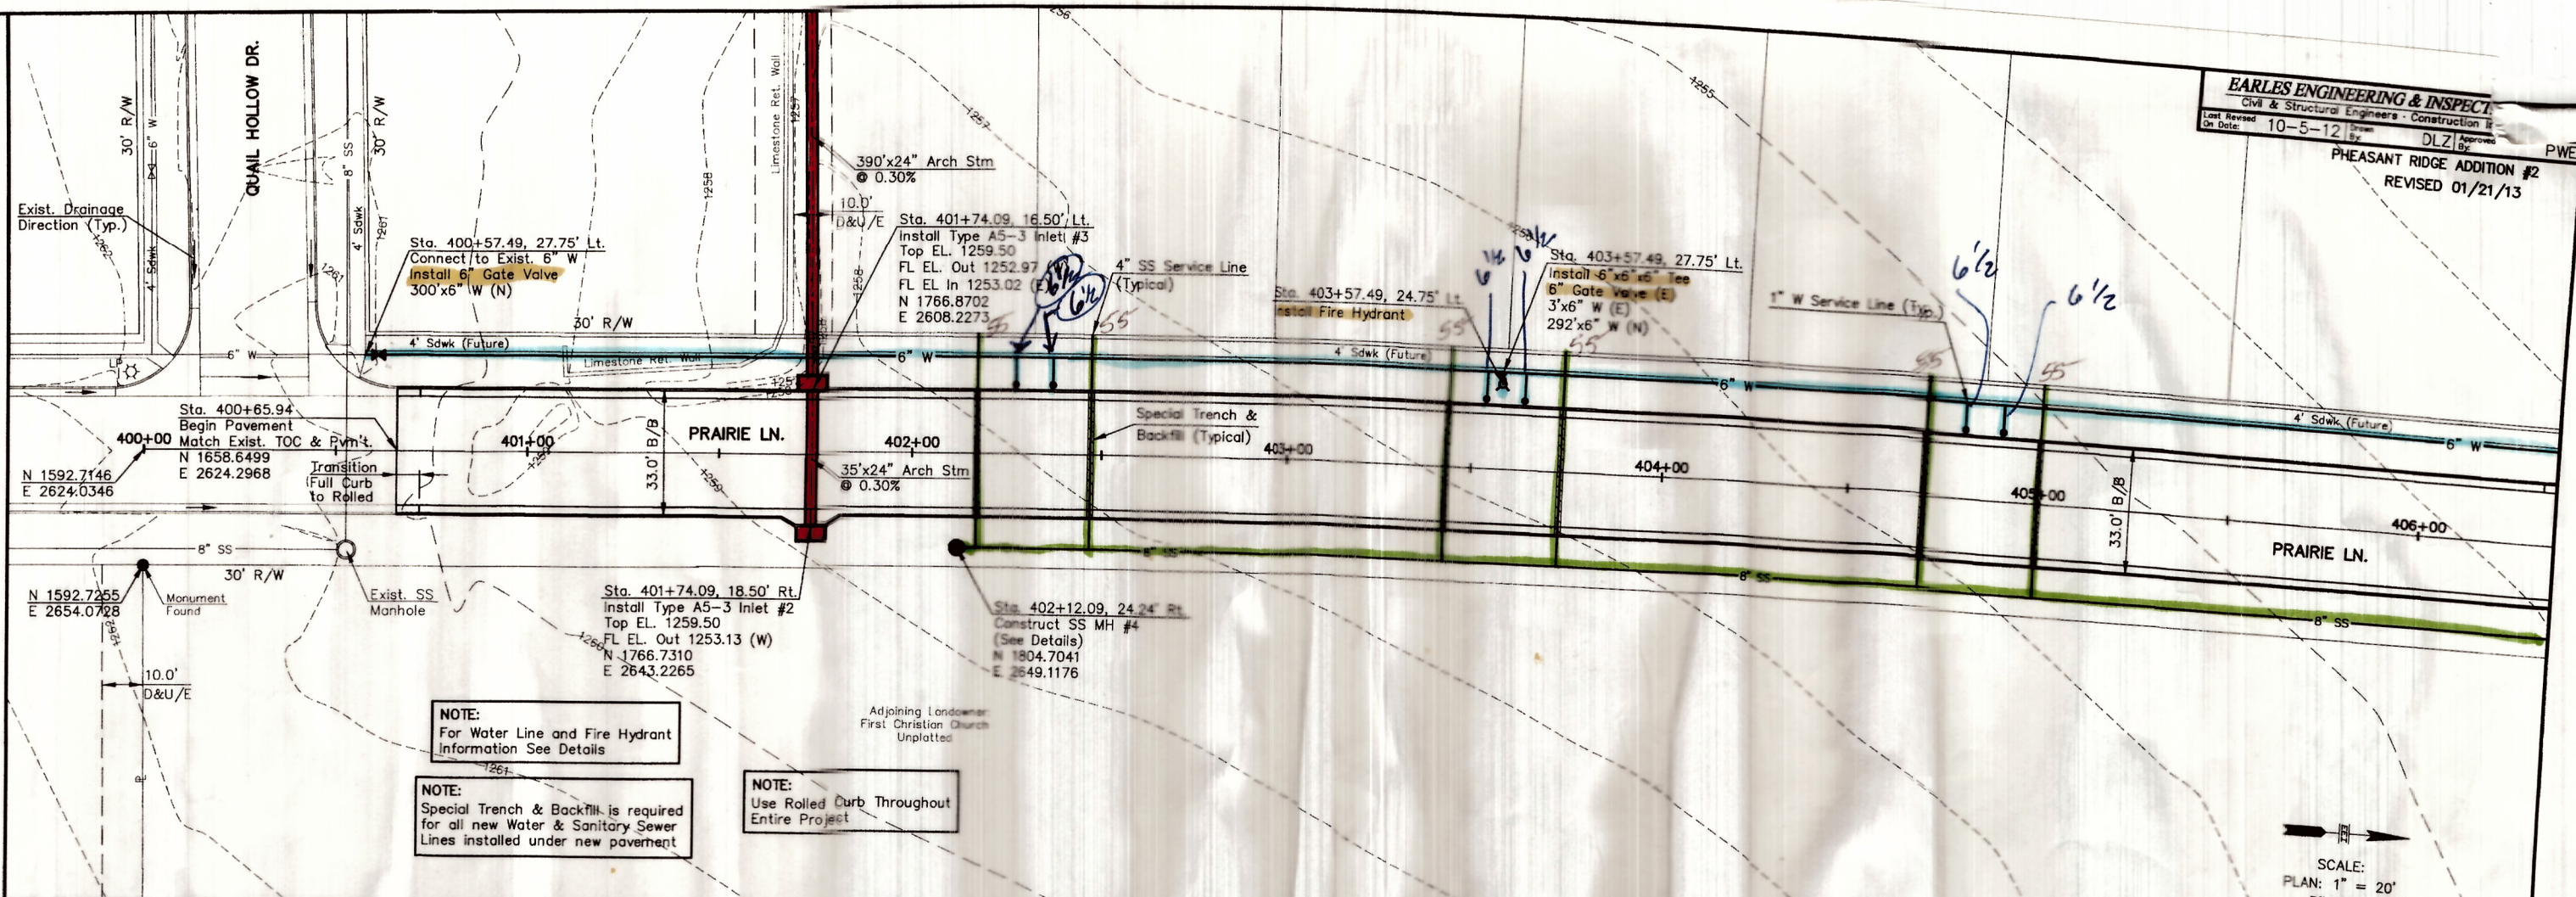


**NOTE:**  
 For Water Line and Fire Hydrant  
 Information See Details


**NOTE:**  
 Special Trench & Backfill is required  
 for all new Water & Sanitary Sewer  
 Lines installed under new pavement


**NOTE:**  
 Use Rolled Curb Throughout  
 Entire Project

SCALE:  
 PLAN: 1" = 20'  
 PROFILE: 1" = 20'  
 HORIZONTAL: 1" = 20'  
 VERTICAL: 1" = 4'

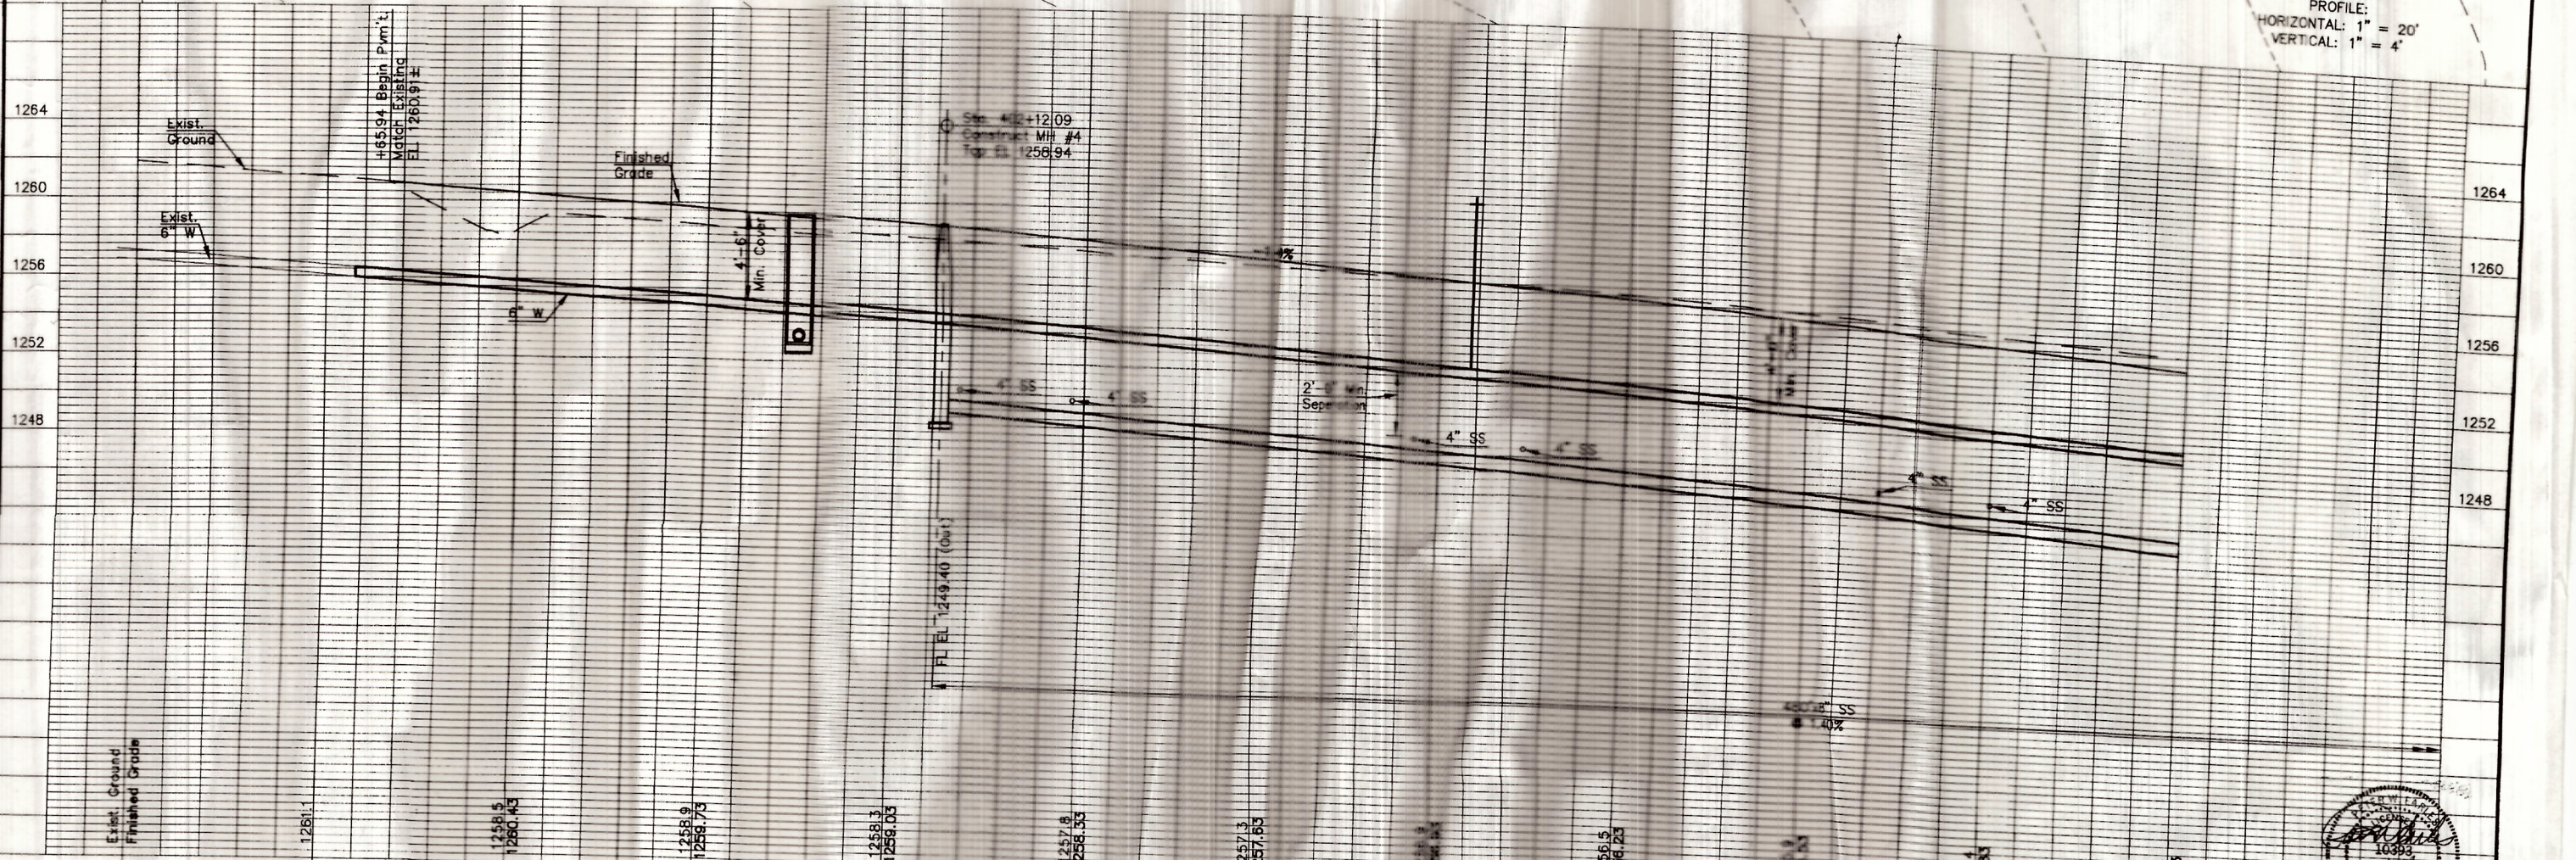

Project: 09-07  
 Description: Welsh Private  
 Title:  
 Path: F: 2009\09-07 Private Project\Welsh Private Master  
 Filename: Prairie Lane  
 List Revision:

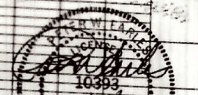


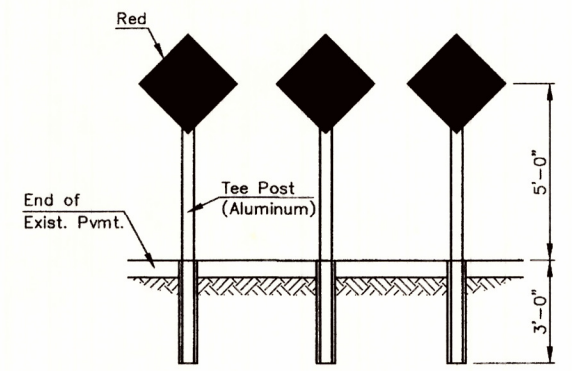

**ROAD CHEVRONS**  
Not To Scale


All traffic control devices, their installation and maintenance shall comply with the requirements of the Manual on Uniform Traffic Control Devices.

- NOTE:**  
For Water Line and Fire Hydrant Information See Details
- NOTE:**  
Special Trench & Backfill is required for all new Water & Sanitary Sewer Lines installed under new pavement
- NOTE:**  
Use Rolled Curb Throughout Entire Project

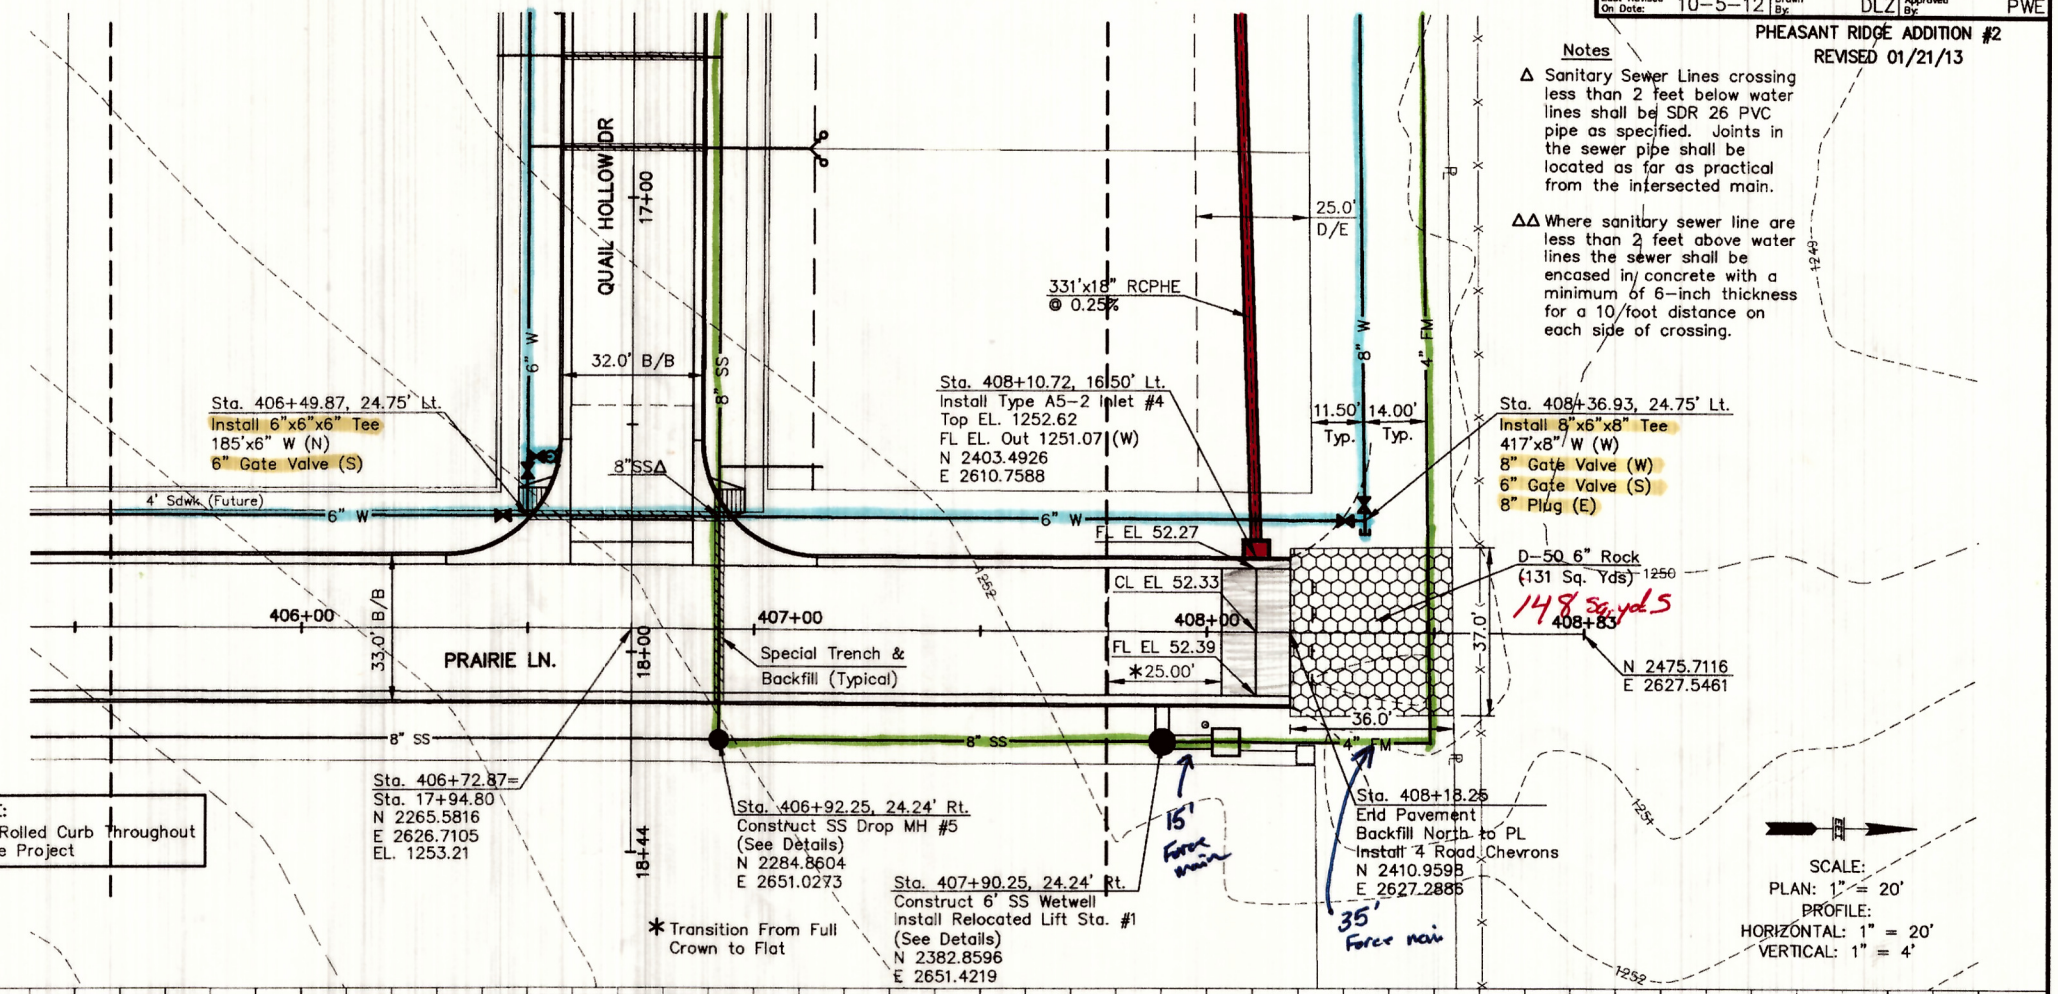

- Notes**
- △ Sanitary Sewer Lines crossing less than 2 feet below water lines shall be SDR 26 PVC pipe as specified. Joints in the sewer pipe shall be located as far as practical from the intersected main.
  - △△ Where sanitary sewer line are less than 2 feet above water lines the sewer shall be encased in concrete with a minimum of 6-inch thickness for a 10-foot distance on each side of crossing.

**SCALE:**  
 PLAN: 1" = 20'  
 PROFILE: HORIZONTAL: 1" = 20'  
 VERTICAL: 1" = 4'

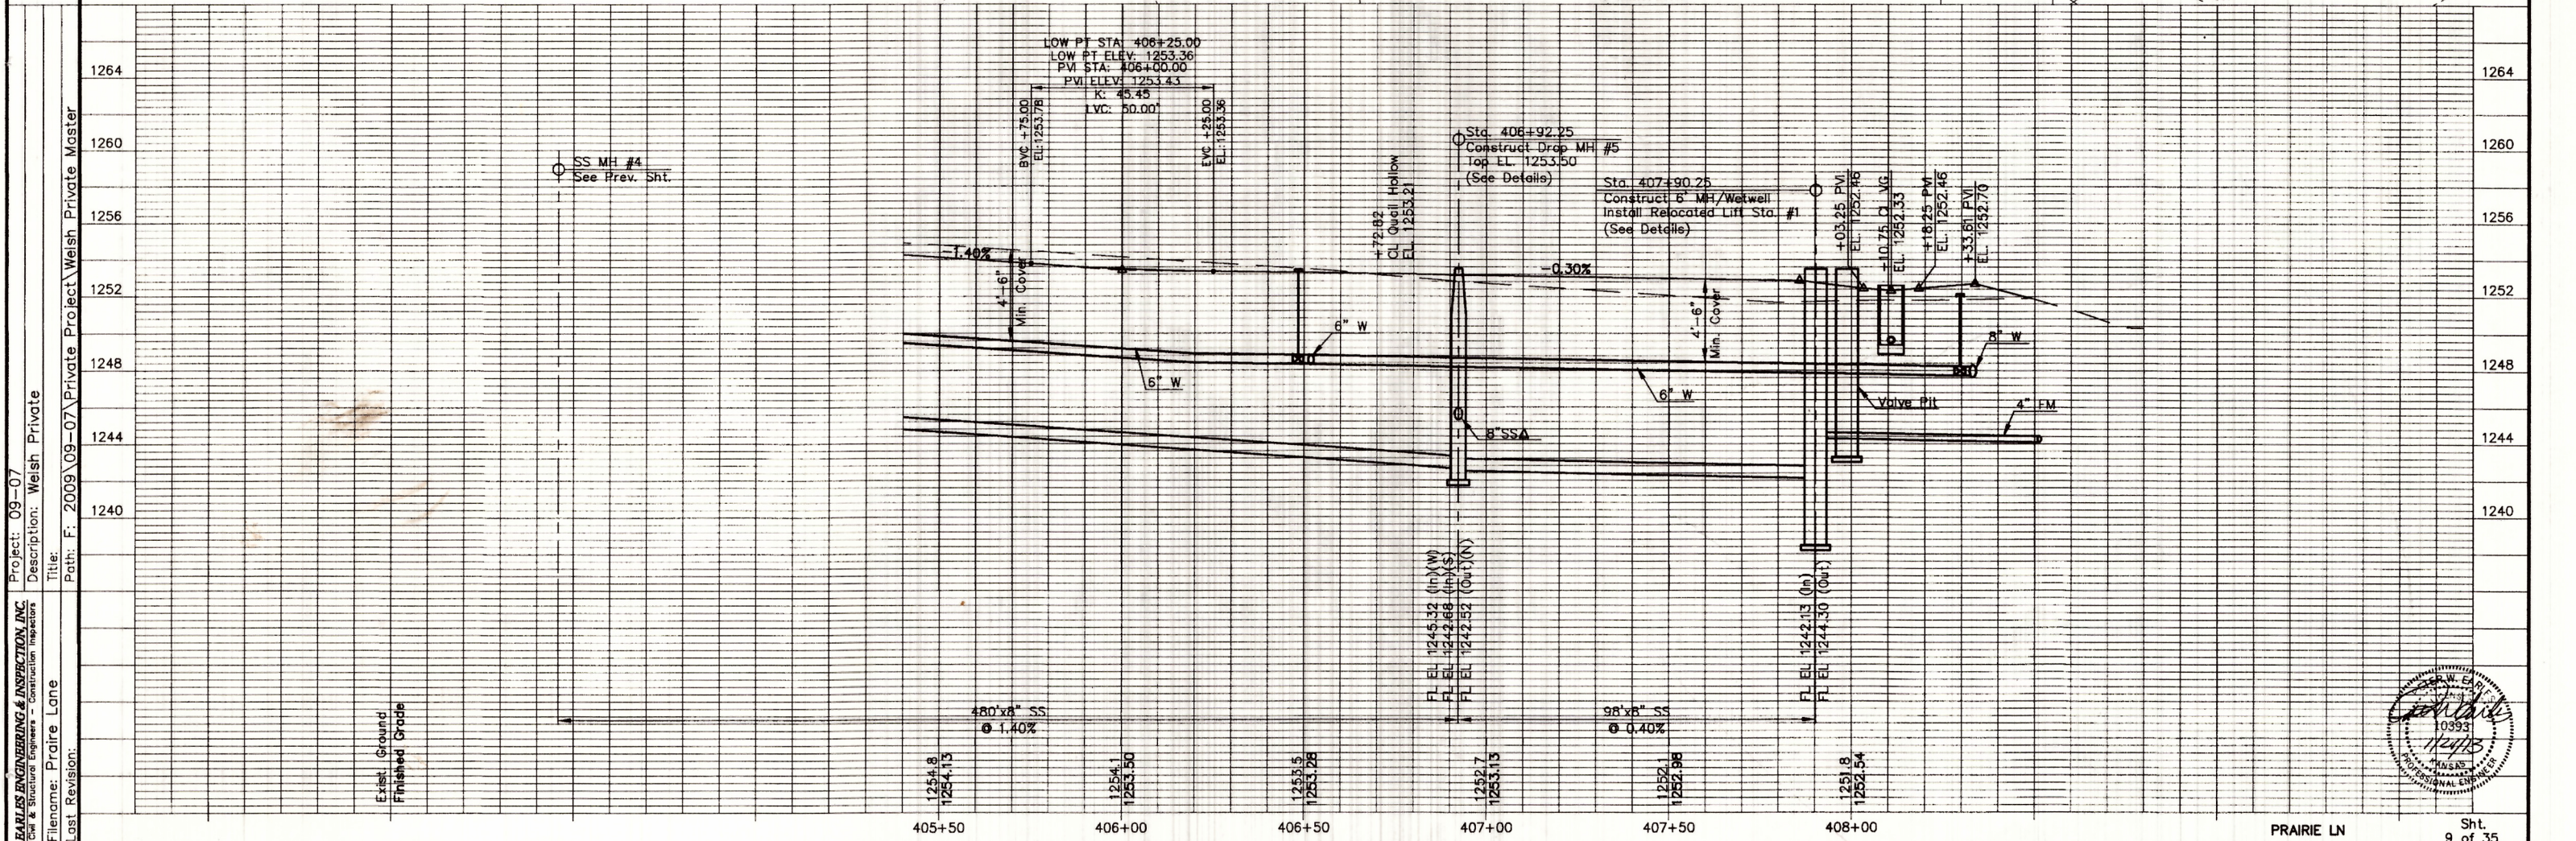

Project: 09-07  
 Description: Welsh Private  
 Title: Private Project  
 Path: F:\2009\09-07 Private Project\Welsh Private Master  
 Filename: Prairie Lane  
 Last Revision:

