



Revised By: JPDICKMAN  
 Plotted: 9/28/2021 6:30 PM  
 File Name: 13-23\_002 PARADISE LN\_LDWG  
 File Location: F:\V-Drive\2013\13-23 Ryan Add\Civil Drawings\Plan Set

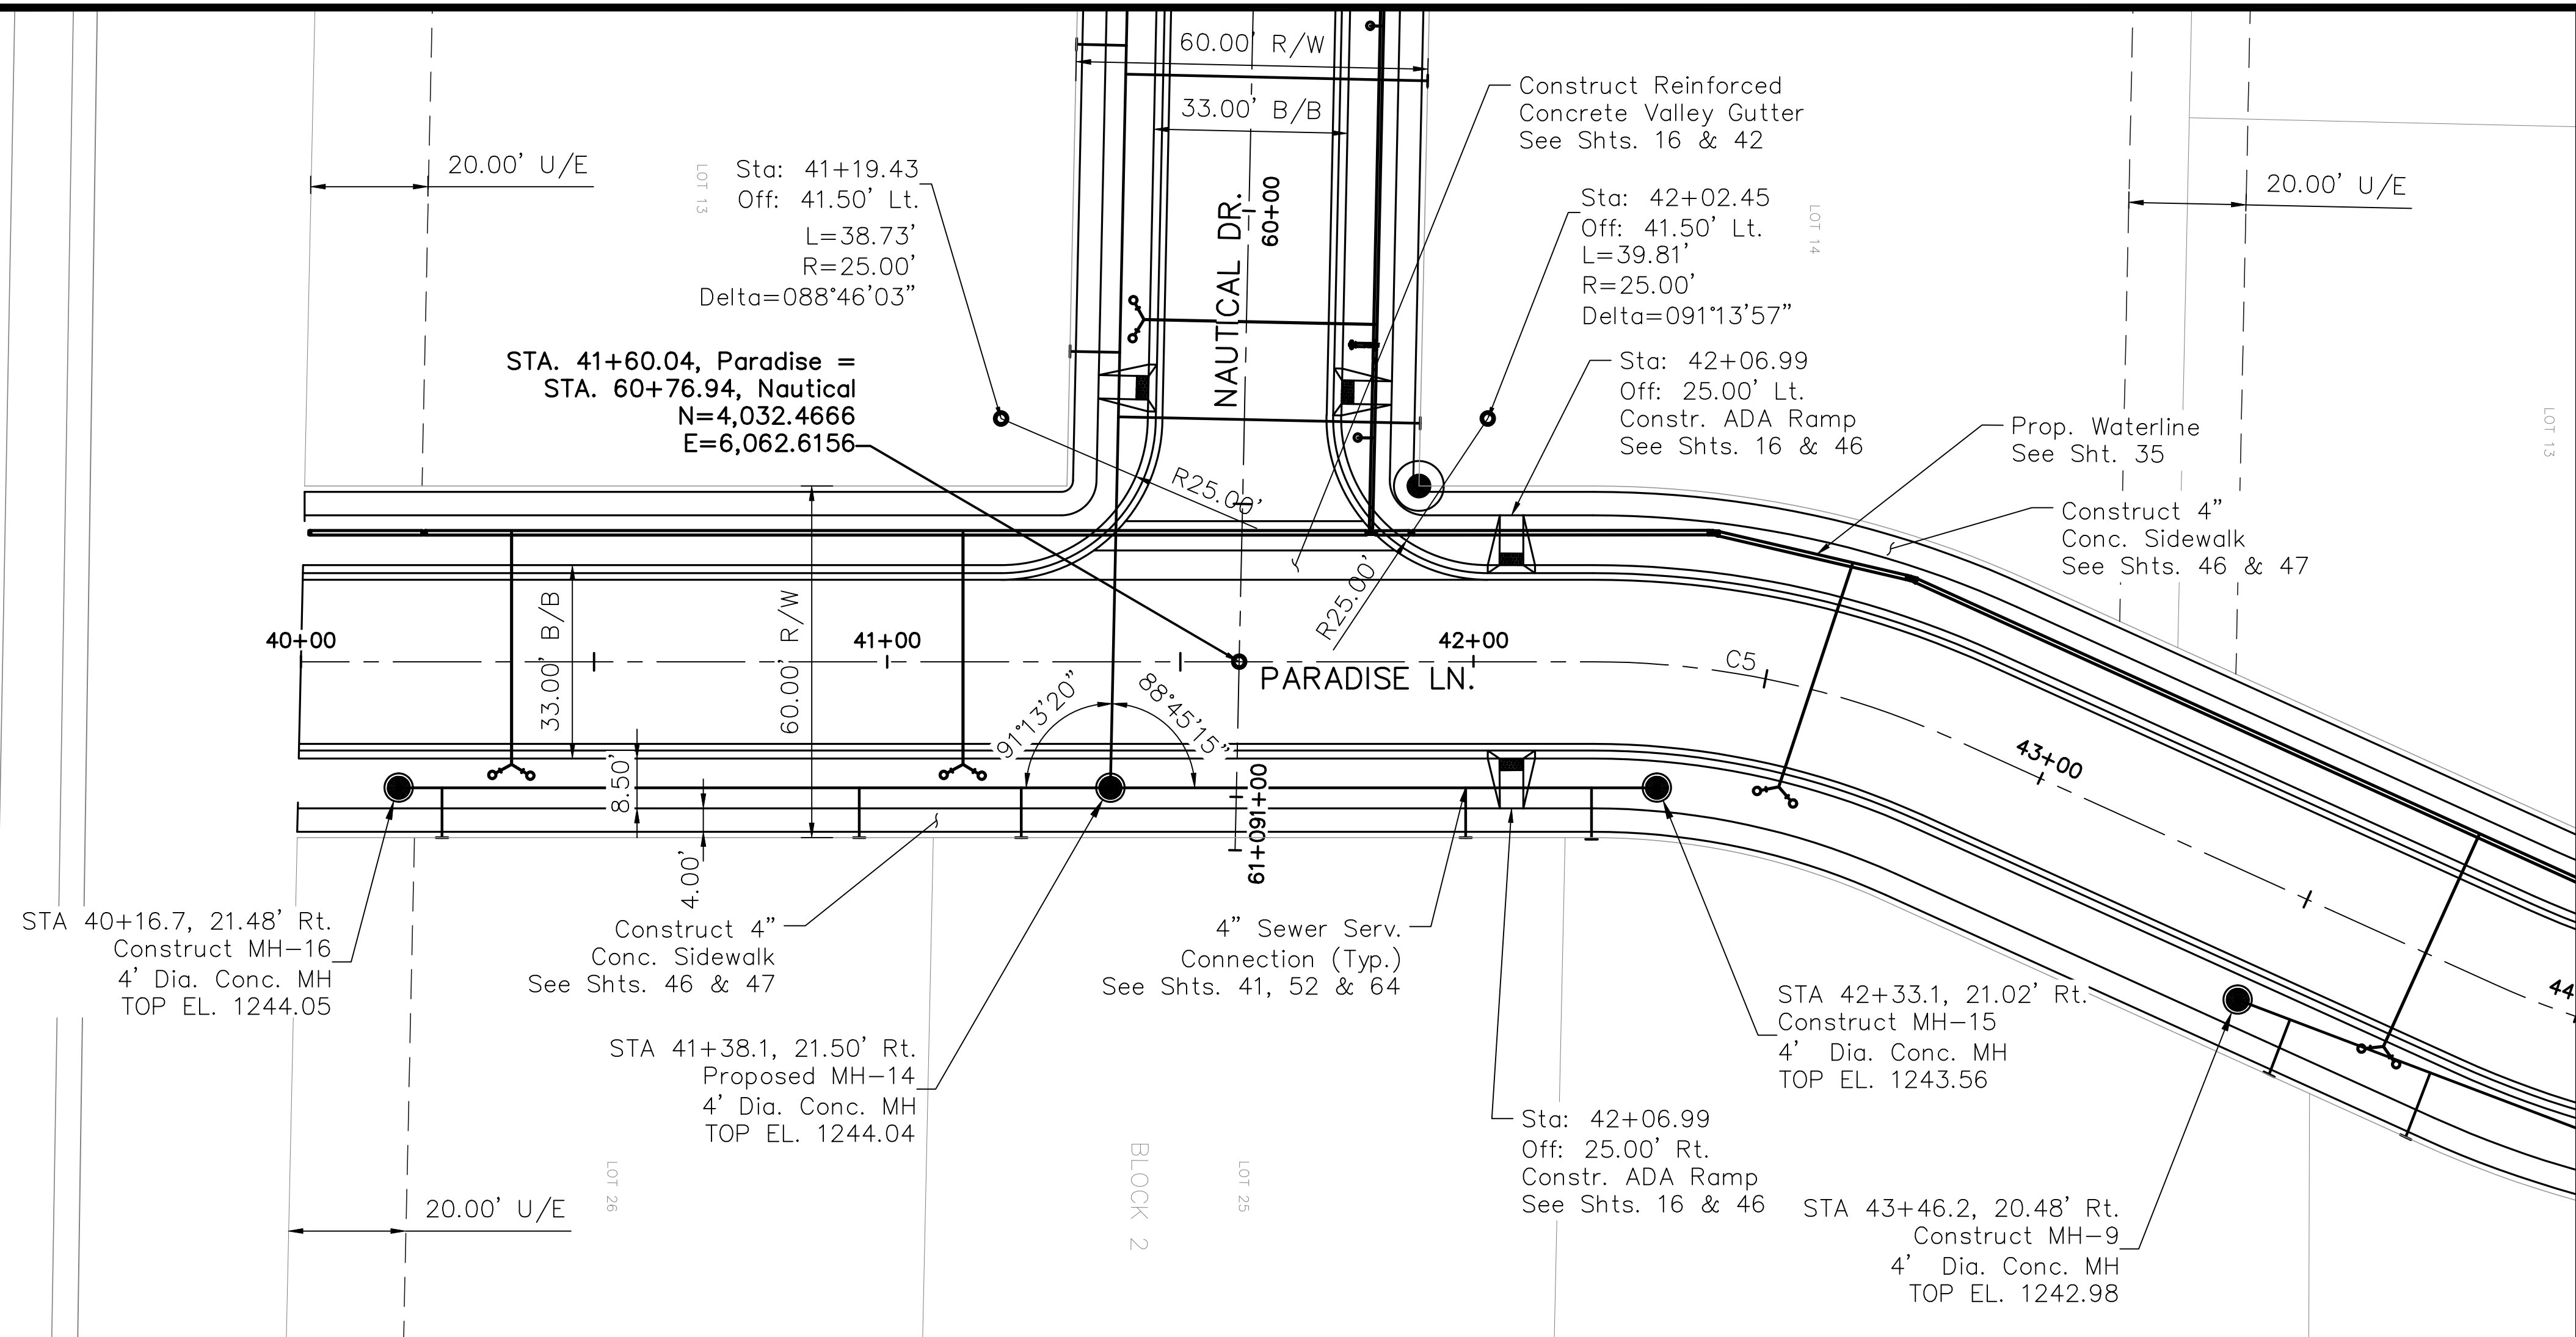

CURVE TABLE									
CURVE #	RADIUS (FT)	CURVE (FT)	TANGENT (FT)	CHORD (FT)	DELTA (A)	PC (NORTH/EAST)	PT (NORTH/EAST)	PI (STATION)	PI (NORTH/EAST)
C5	150.00'	63.86'	63.86'	63.38'	24°23'38"	N: 4092.81 E: 6062.10	N: 4154.87 E: 6074.96	42+52.80	N: 4125.23 E: 6061.83

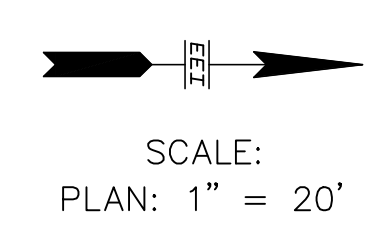


REVISIONS	
NO.	DESCRIPTION
1	11/18/21 Revised Lot Grading & Sidewalks

**EARLES ENGINEERING & INSPECTION, INC.**  
 Civil & Structural Engineers  
 Construction Inspectors - Surveyors  
 Email: eearlesinc@earthlink.net


KANSAS

**RYAN ADDITION  
 STREET & SANITARY SEWER  
 PARADISE LN  
 40+00 TO 44+00**

CITY OF SALINA

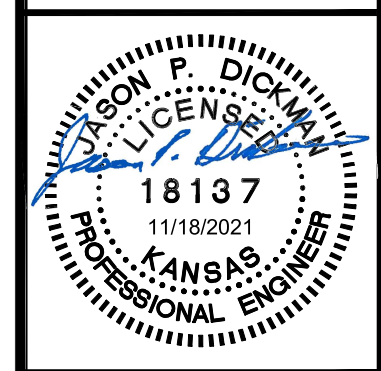

ENGINEER: JPD  
 CHECKED BY: PWE  
 DRAWN BY: DRB/BFS/JMR  
 DATE: 11-15-2021  
 PROJECT NO: 13-23  
 SHEET: 12 of 94

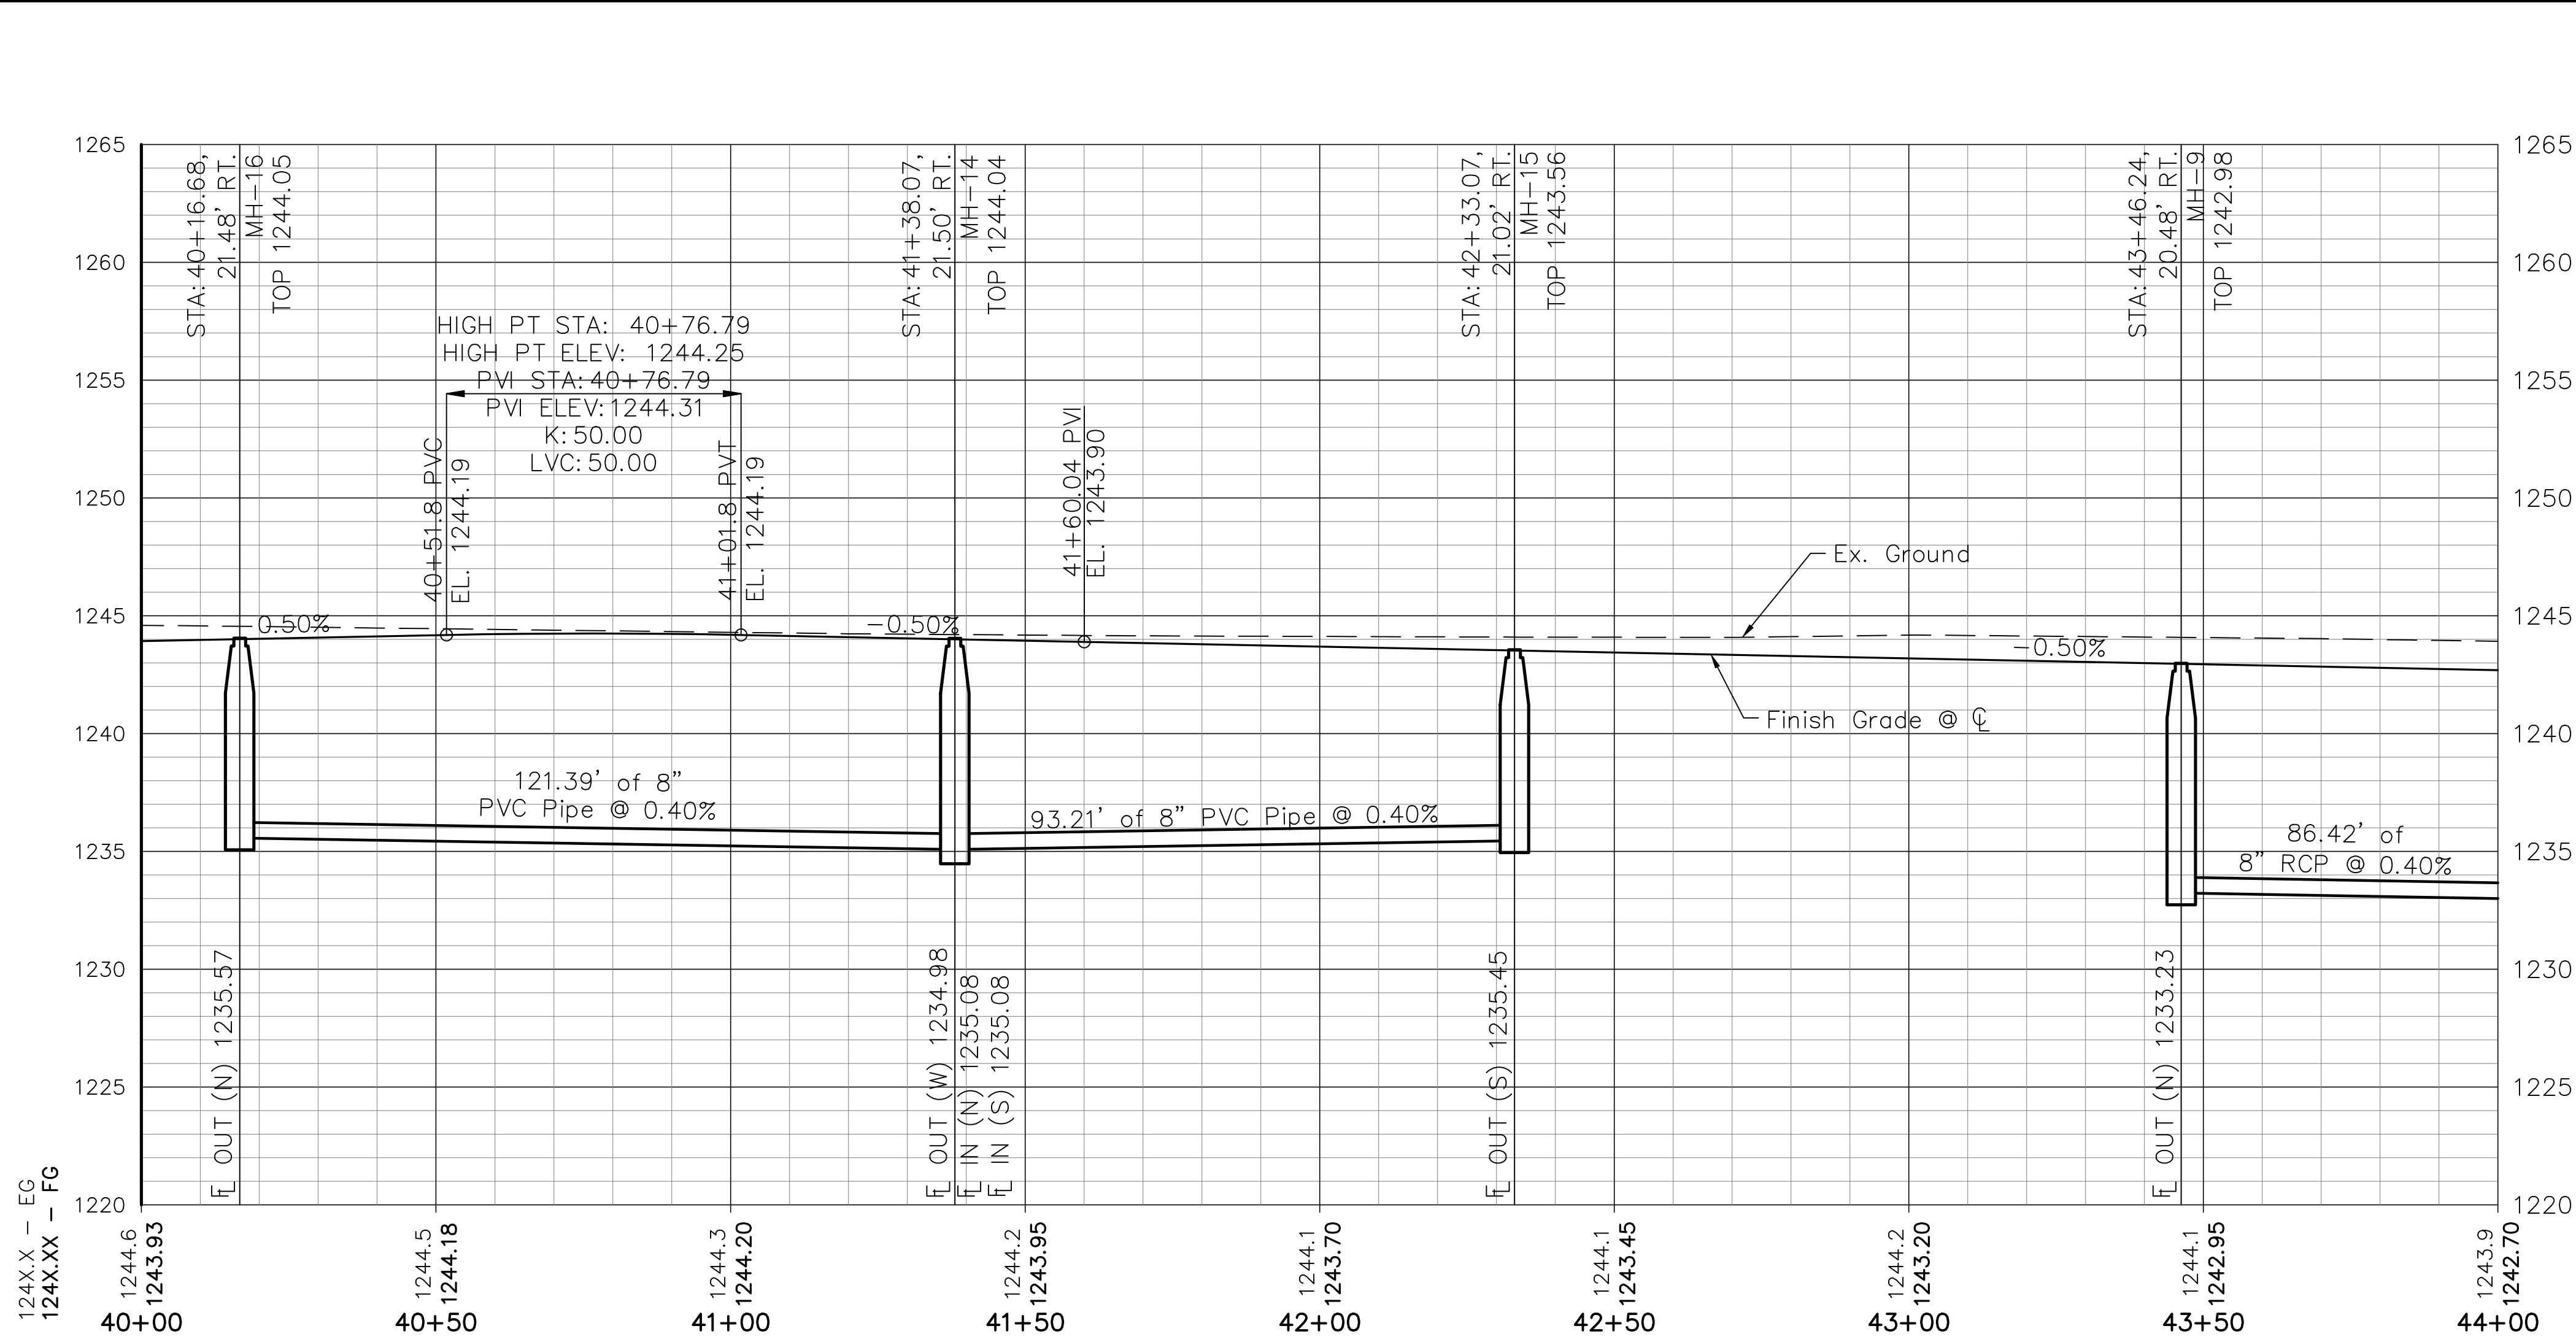

PROFILE SCALE:  
 HORIZONTAL: 1" = 20'  
 VERTICAL: 1" = 5'