

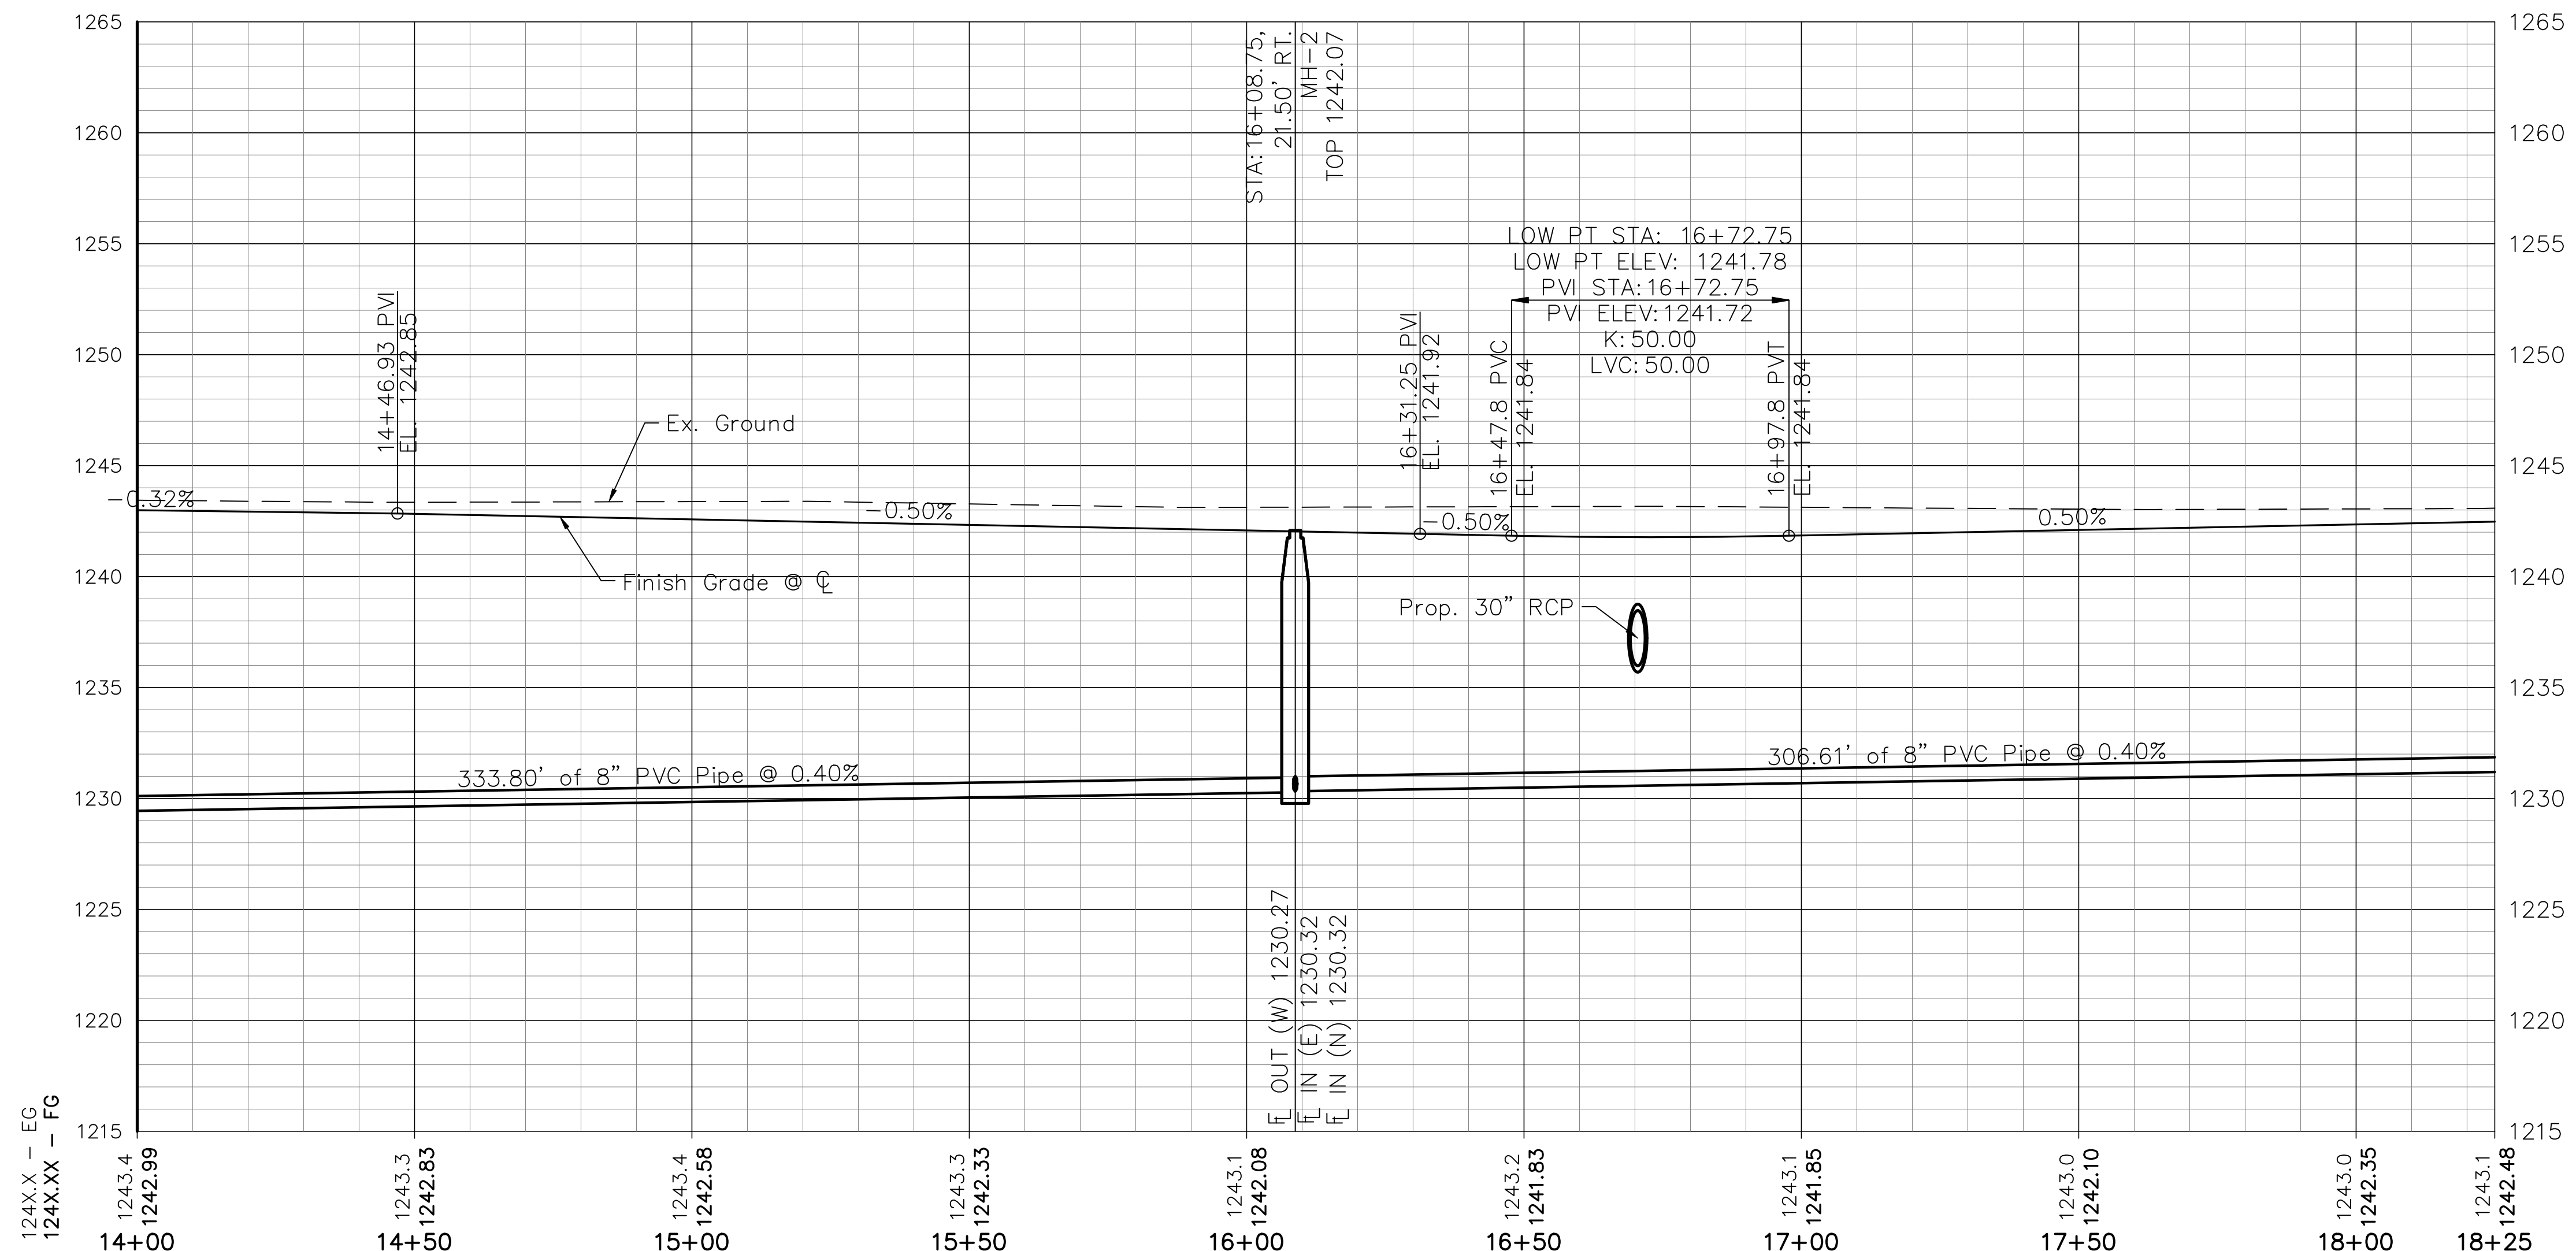


Revised By: DAVE BLESSETT  
 Plotted: 11/15/2021 10:19 AM

Filename: 13-23\_003 HARBOR DR\_2.DWG  
 File Location: F:\V-Drive\2013\13-23 Ryan Add\Civil Drawings\Plan Set

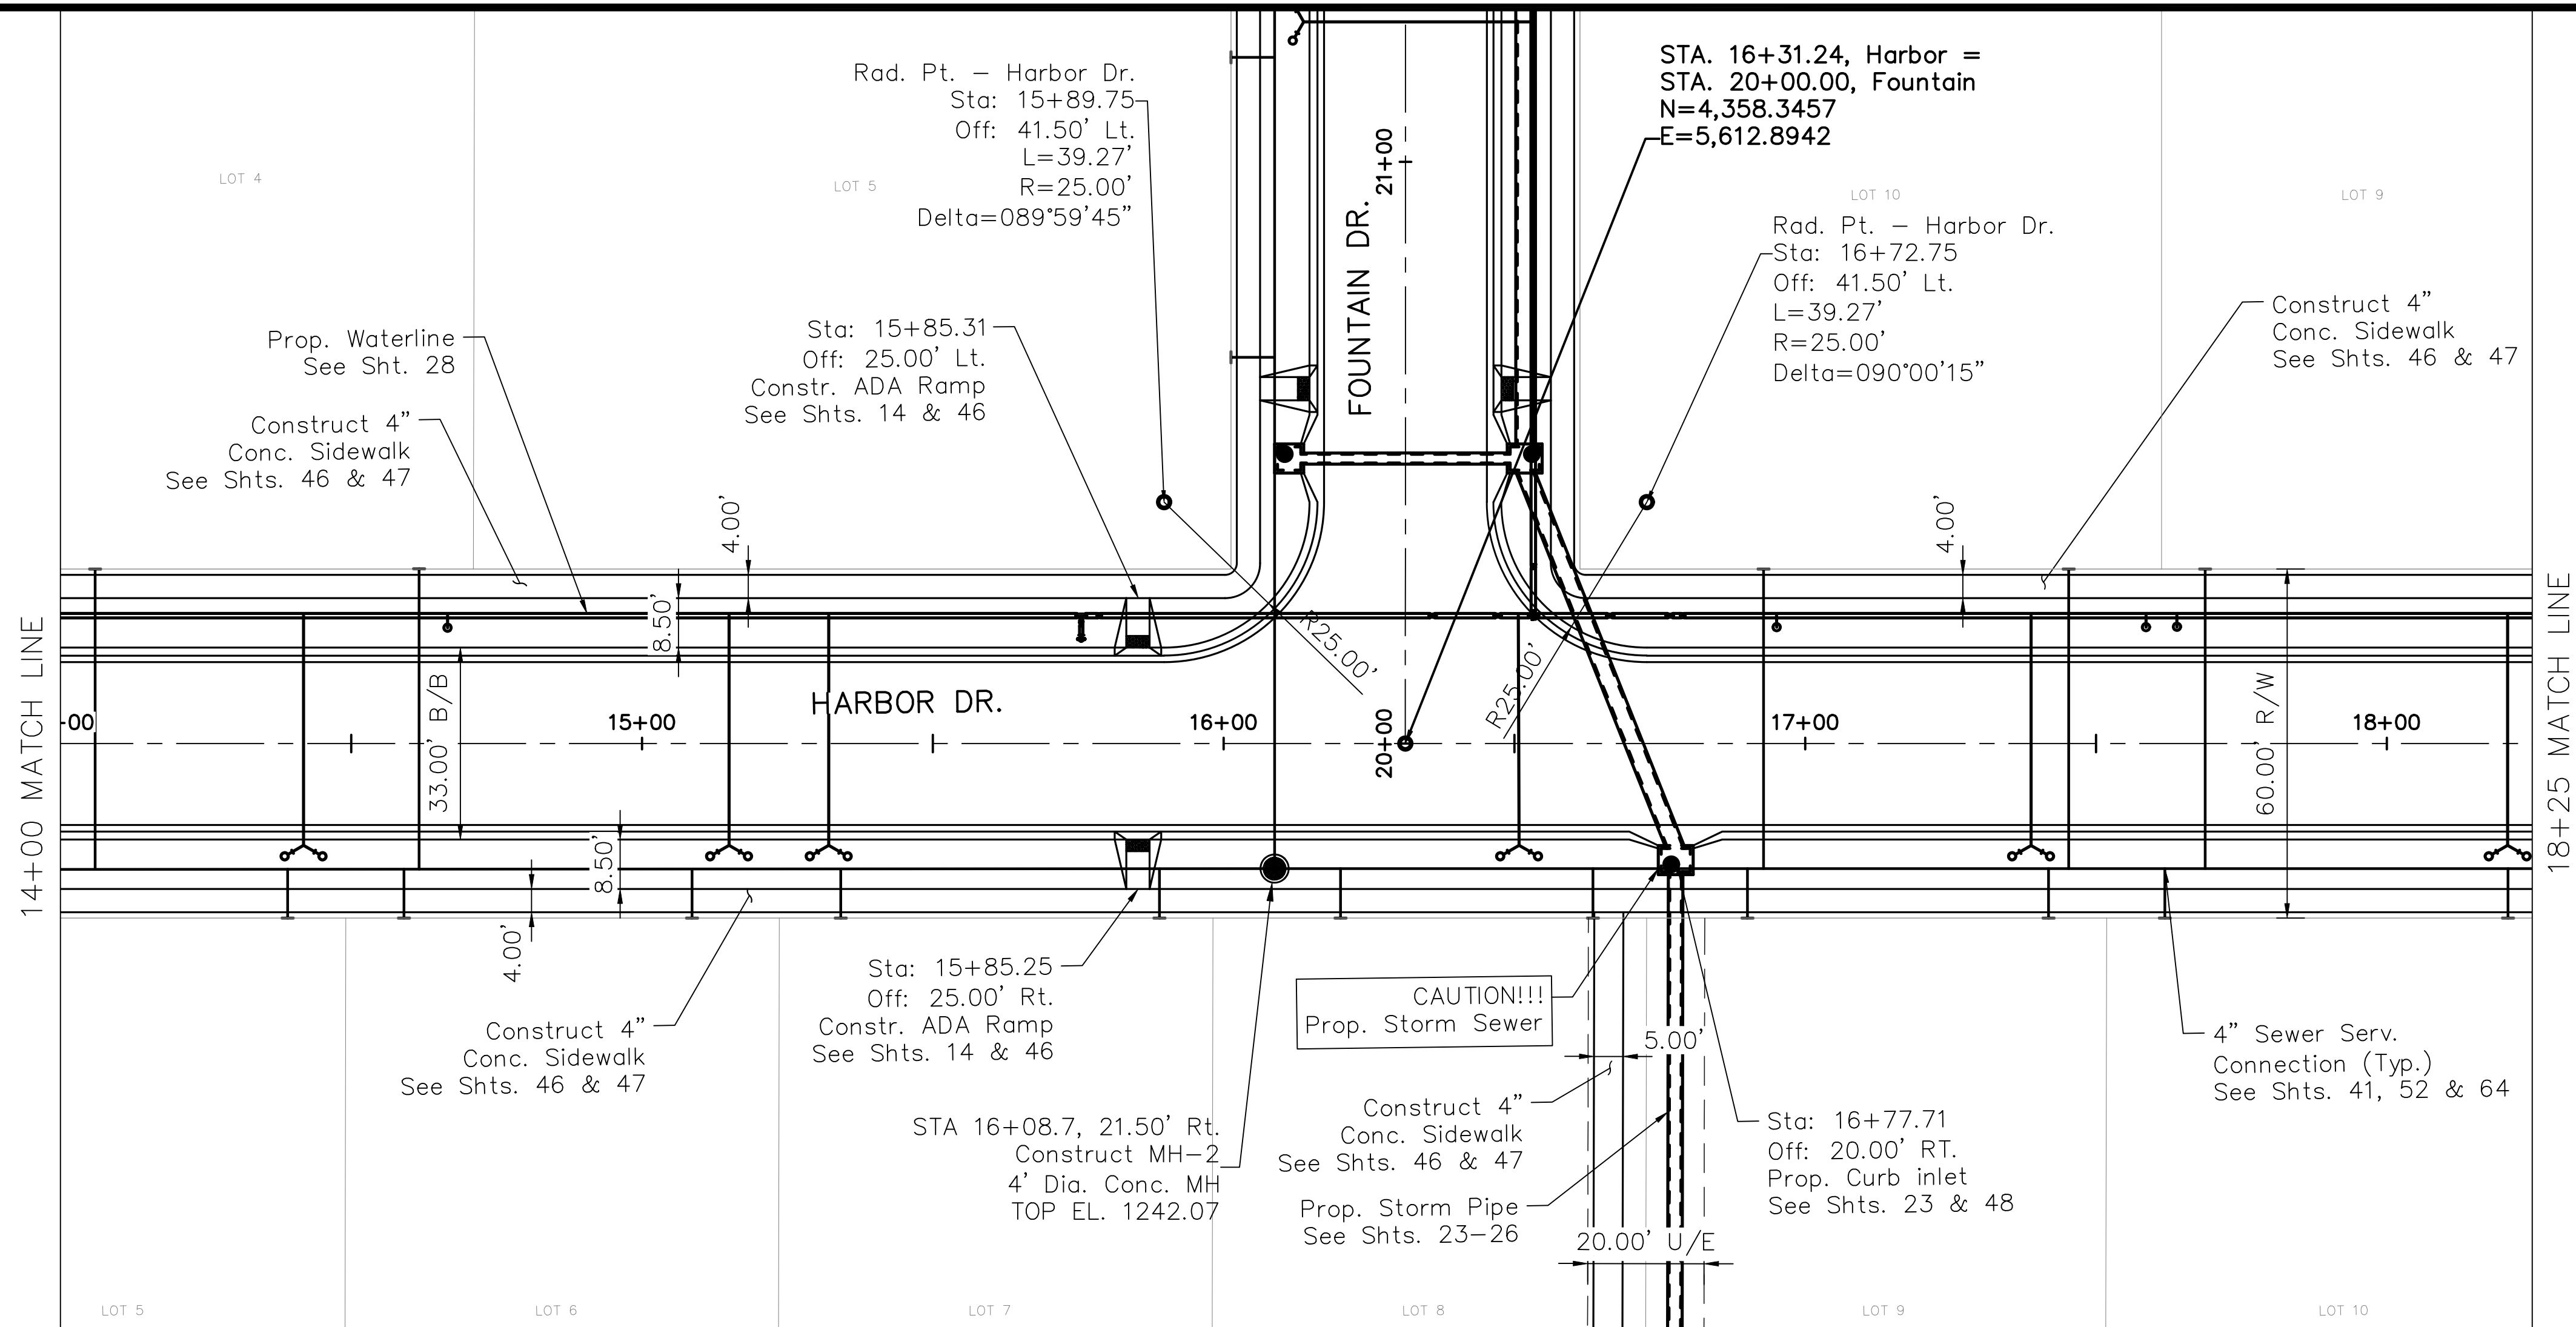

PROFILE SCALE:  
 HORIZONTAL: 1" = 20'  
 VERTICAL: 1" = 5'

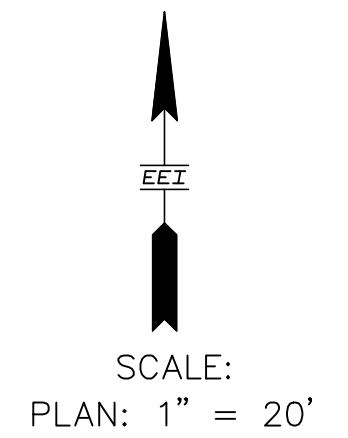

NO.	DATE	DESCRIPTION
1	11/18/21	Revised Lot Grading & Sidewalks

**EARLES ENGINEERING & INSPECTION, INC.**  
 Civil & Structural Engineers  
 Construction Inspectors - Surveyors  
 Email: earlesinc@earleseng.com

KANSAS

**RYAN ADDITION  
 STREET & SANITARY SEWER  
 HARBOR DRIVE  
 STA. 14+00 TO 18+25**

CITY OF SALINA



ENGINEER:	JPD
CHECKED BY:	PWE
DRAWN BY:	DRB/BFS/JMR
DATE:	11-15-2021
PROJECT NO:	13-23
SHEET:	5 of 94