



Revised By: DAVE BLESSETT
 Plotted: 11/15/2021 10:13 AM
 Filename: 13-23-001 FOUNTAIN DR_LDWG
 File Location: F:\V-Drive\2013\13-23 Ryan Add\Civil Drawings\Plan Set

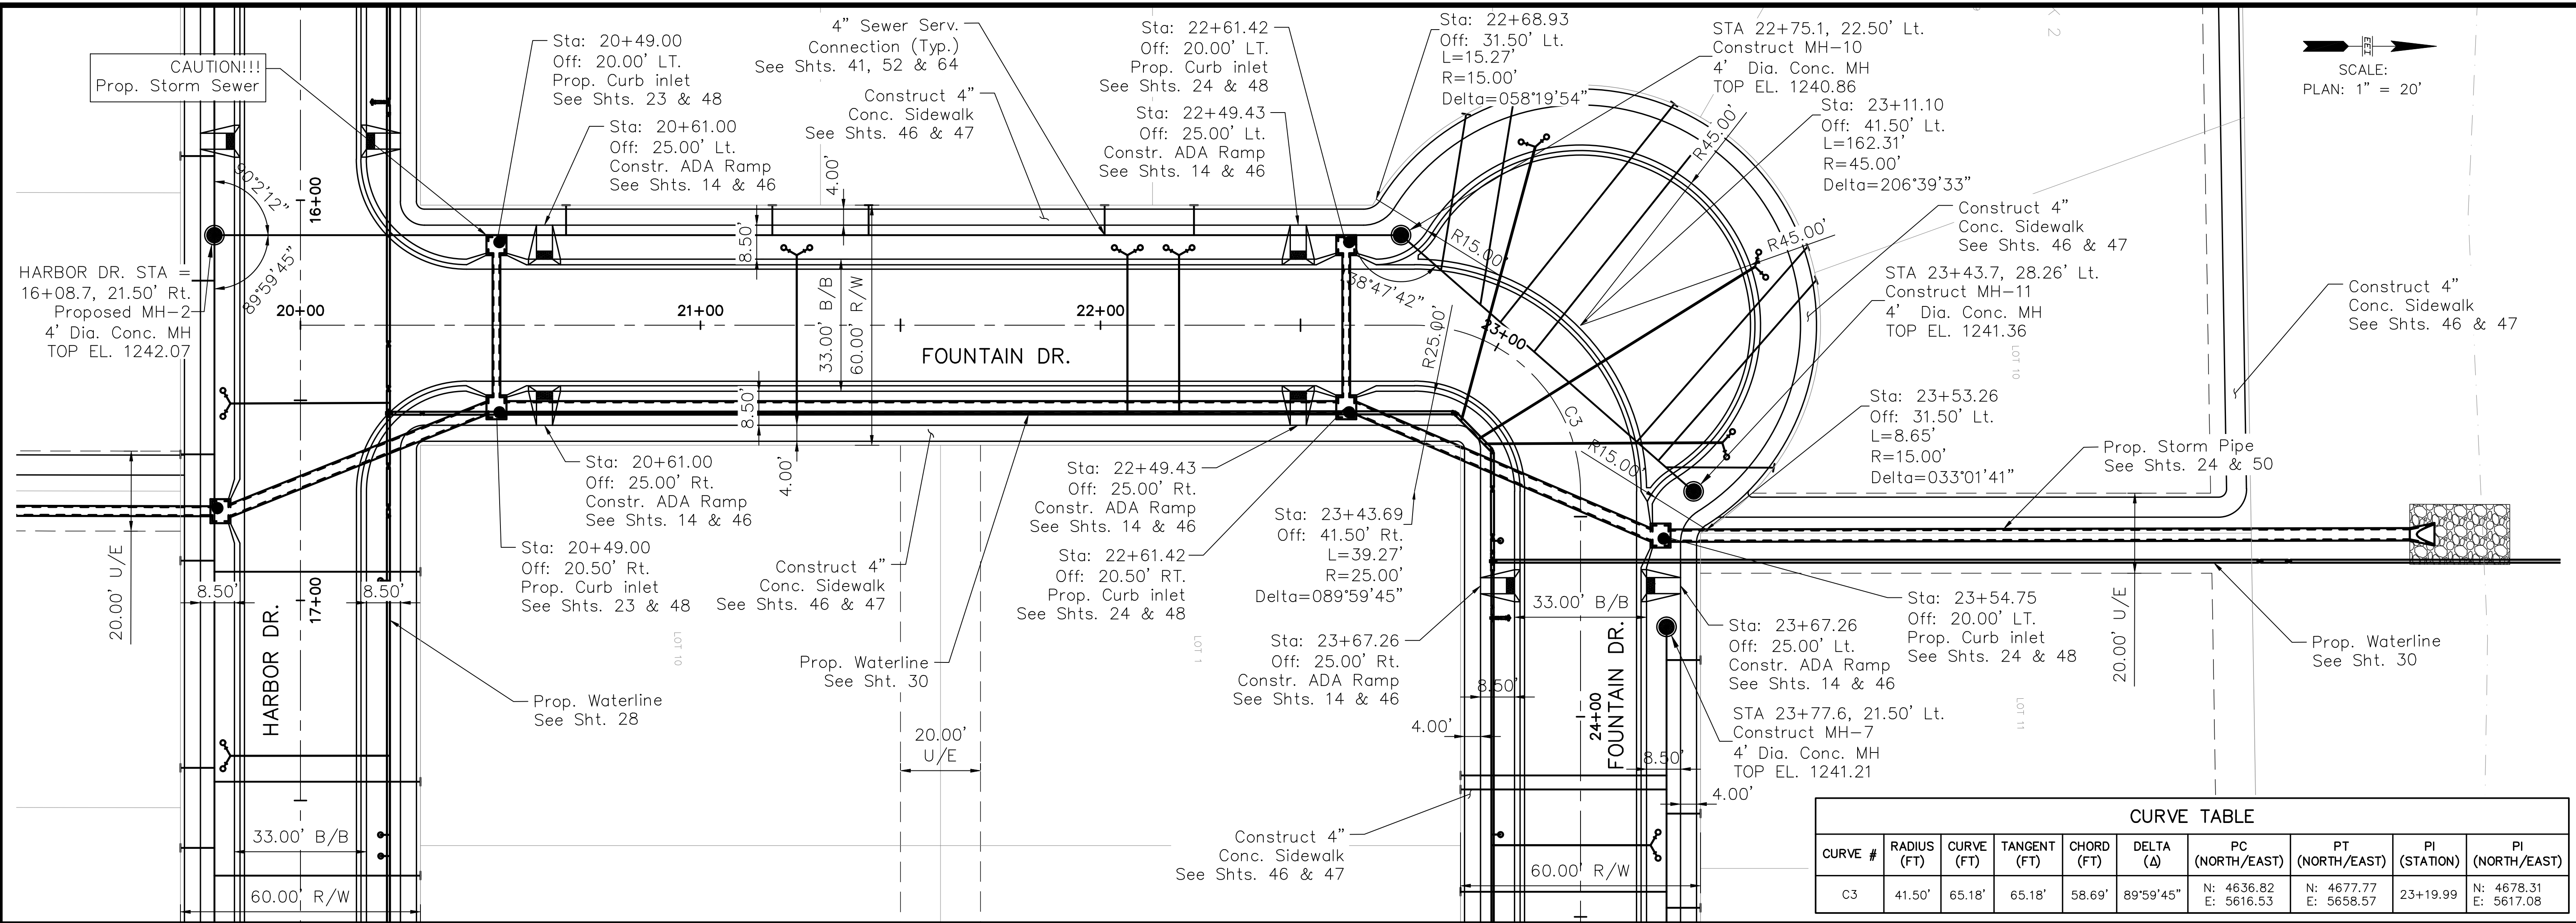

CURVE #	RADIUS (FT)	CURVE (FT)	TANGENT (FT)	CHORD (FT)	DELTA (Δ)	PC (NORTH/EAST)	PT (NORTH/EAST)	PI (STATION)	PI (NORTH/EAST)
C3	41.50'	65.18'	65.18'	58.69'	89°59'45"	N: 4636.82 E: 5616.53	N: 4677.77 E: 5658.57	23+19.99	N: 4678.31 E: 5617.08

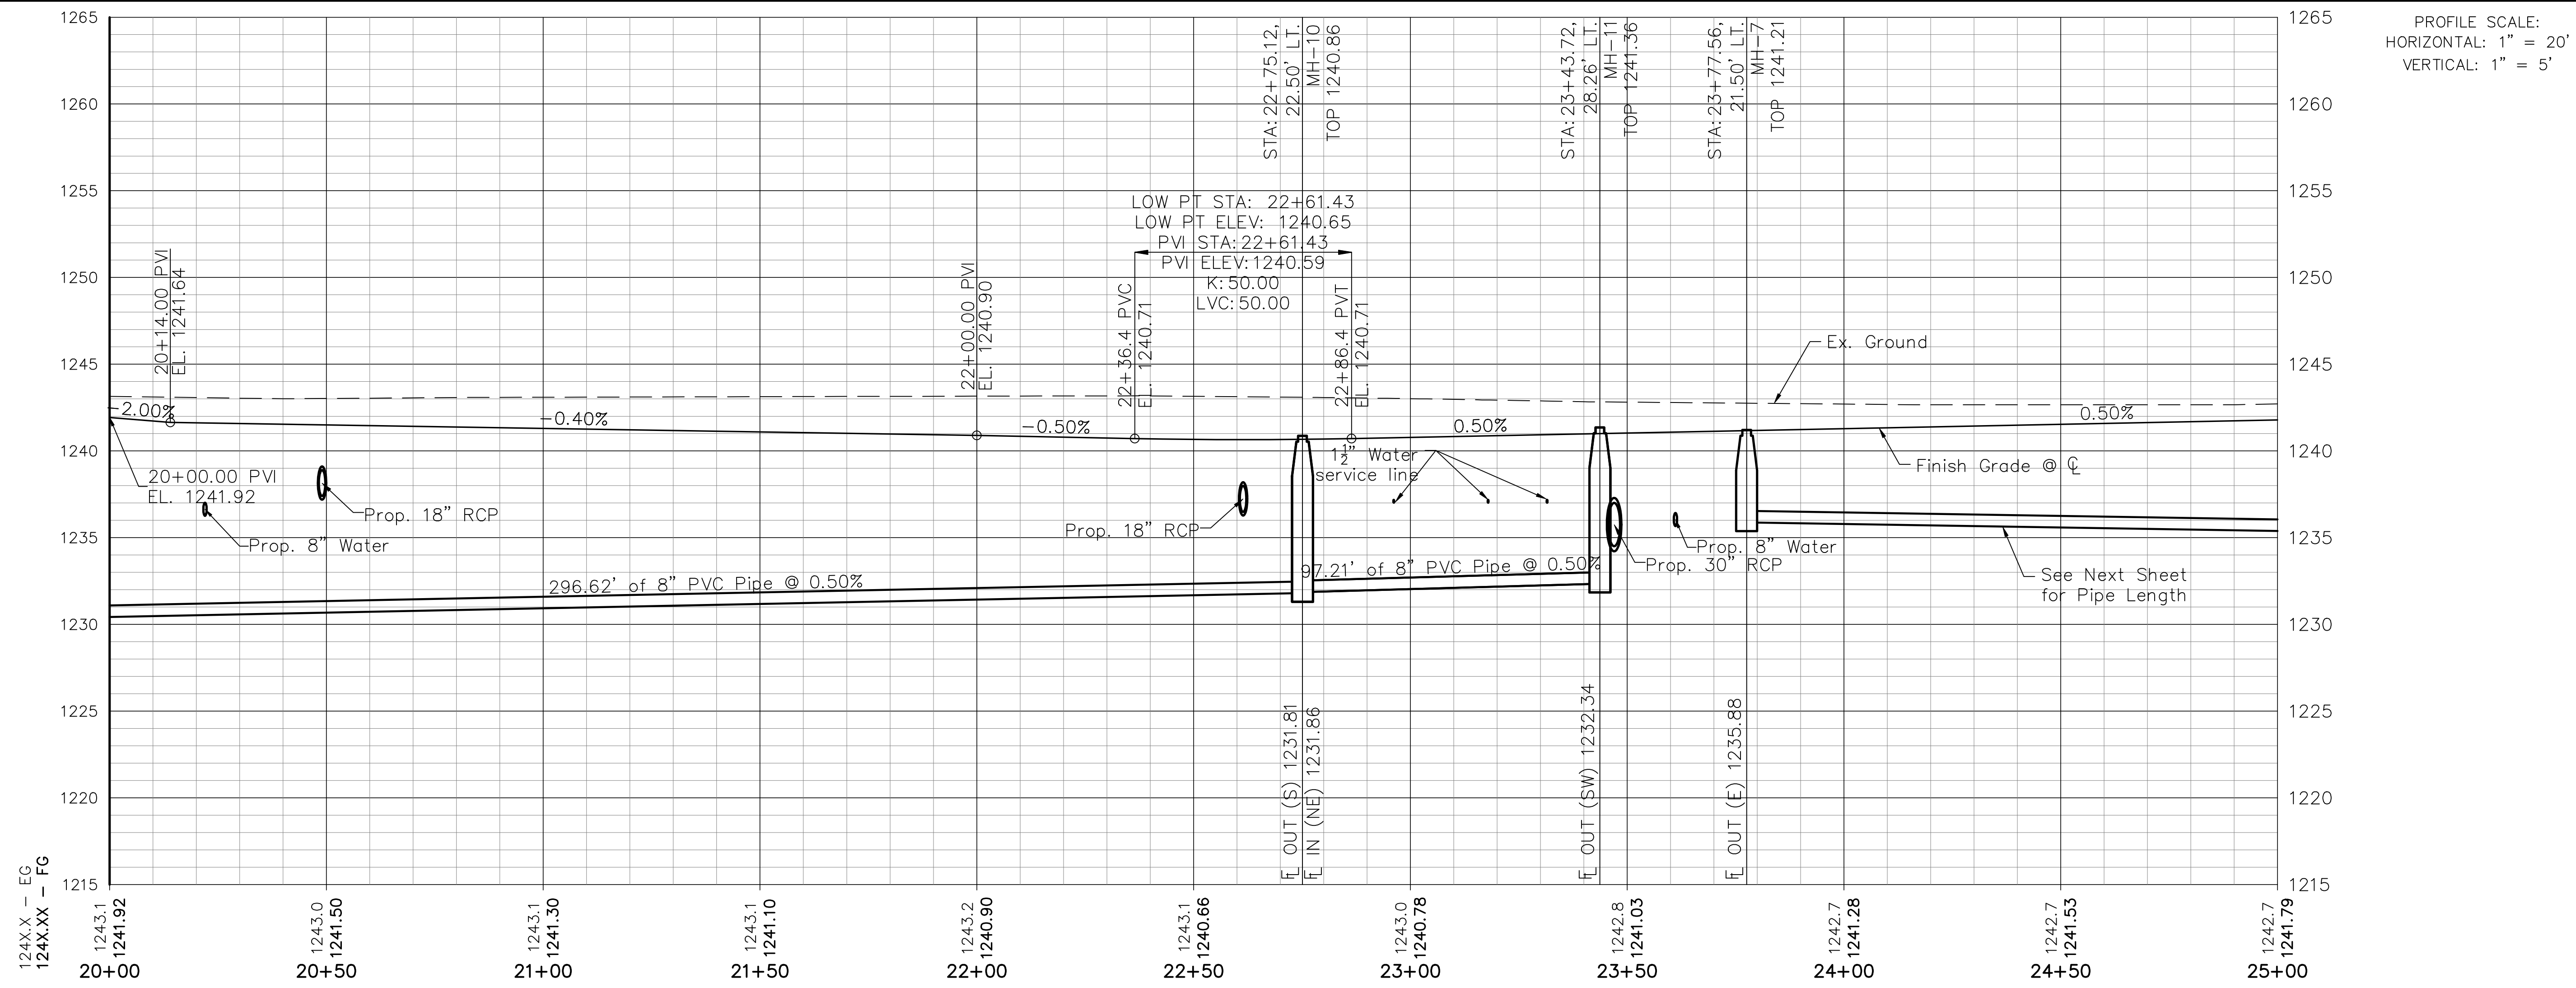

REVISIONS

NO.	DATE	DESCRIPTION
1	11/18/21	Revised Lot Grading & Sidewalks

EARLES ENGINEERING & INSPECTION, INC.
 Civil & Structural Engineers
 Construction Inspectors - Surveyors
 Email: earlesinc@earleseng.com

KANSAS

RYAN ADDITION
 STREET & SANITARY SEWER
 FOUNTAIN DRIVE
 STA. 20+00 TO 25+00

CITY OF SALINA

ENGINEER:
 JPD

CHECKED BY:
 PWE

DRAWN BY:
 DRB/BFS/JMR

DATE:
 11-15-2021

PROJECT NO:
 13-23

SHEET:
 7 of 94

PROFESSIONAL ENGINEER
 18137
 11/18/2021
 KANSAS