
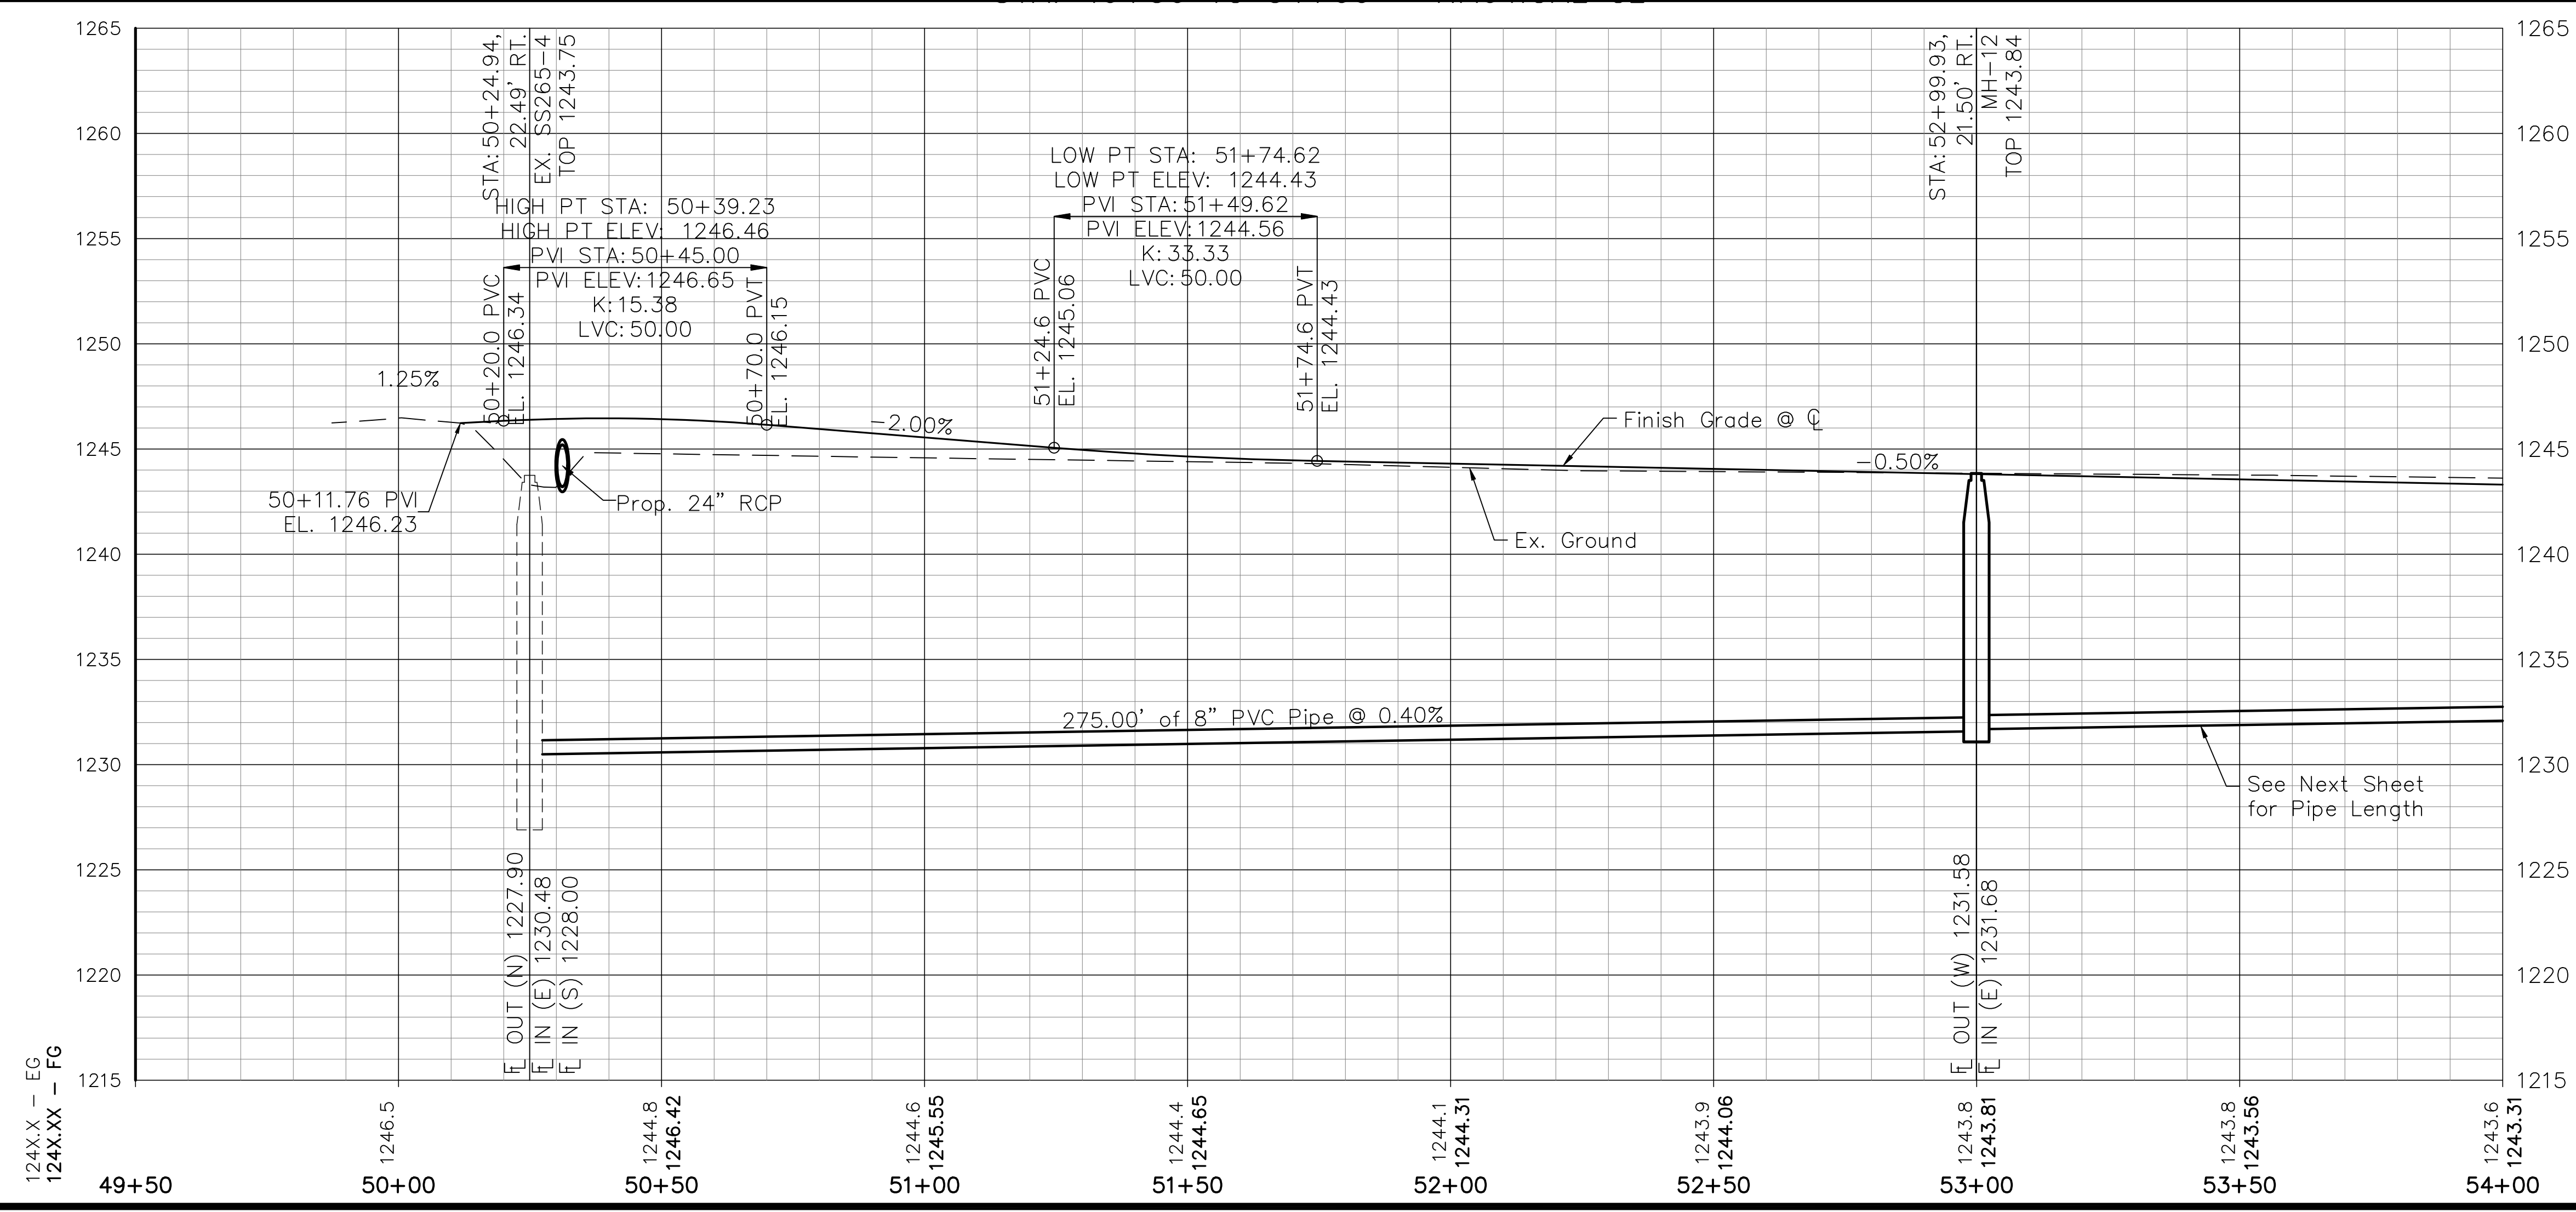
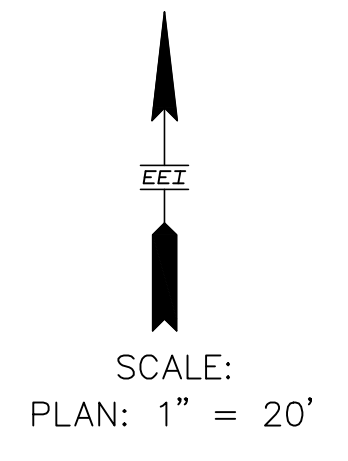


Revised By: DAVE BLESSETT
 Plotted: 11/15/2021 10:07 AM

Filename: 13-23_002 NAUTICAL DR_1.DWG
 File Location: F:\V-Drive\2013\13-23 Ryan Add\Civil Drawings\Plan Set

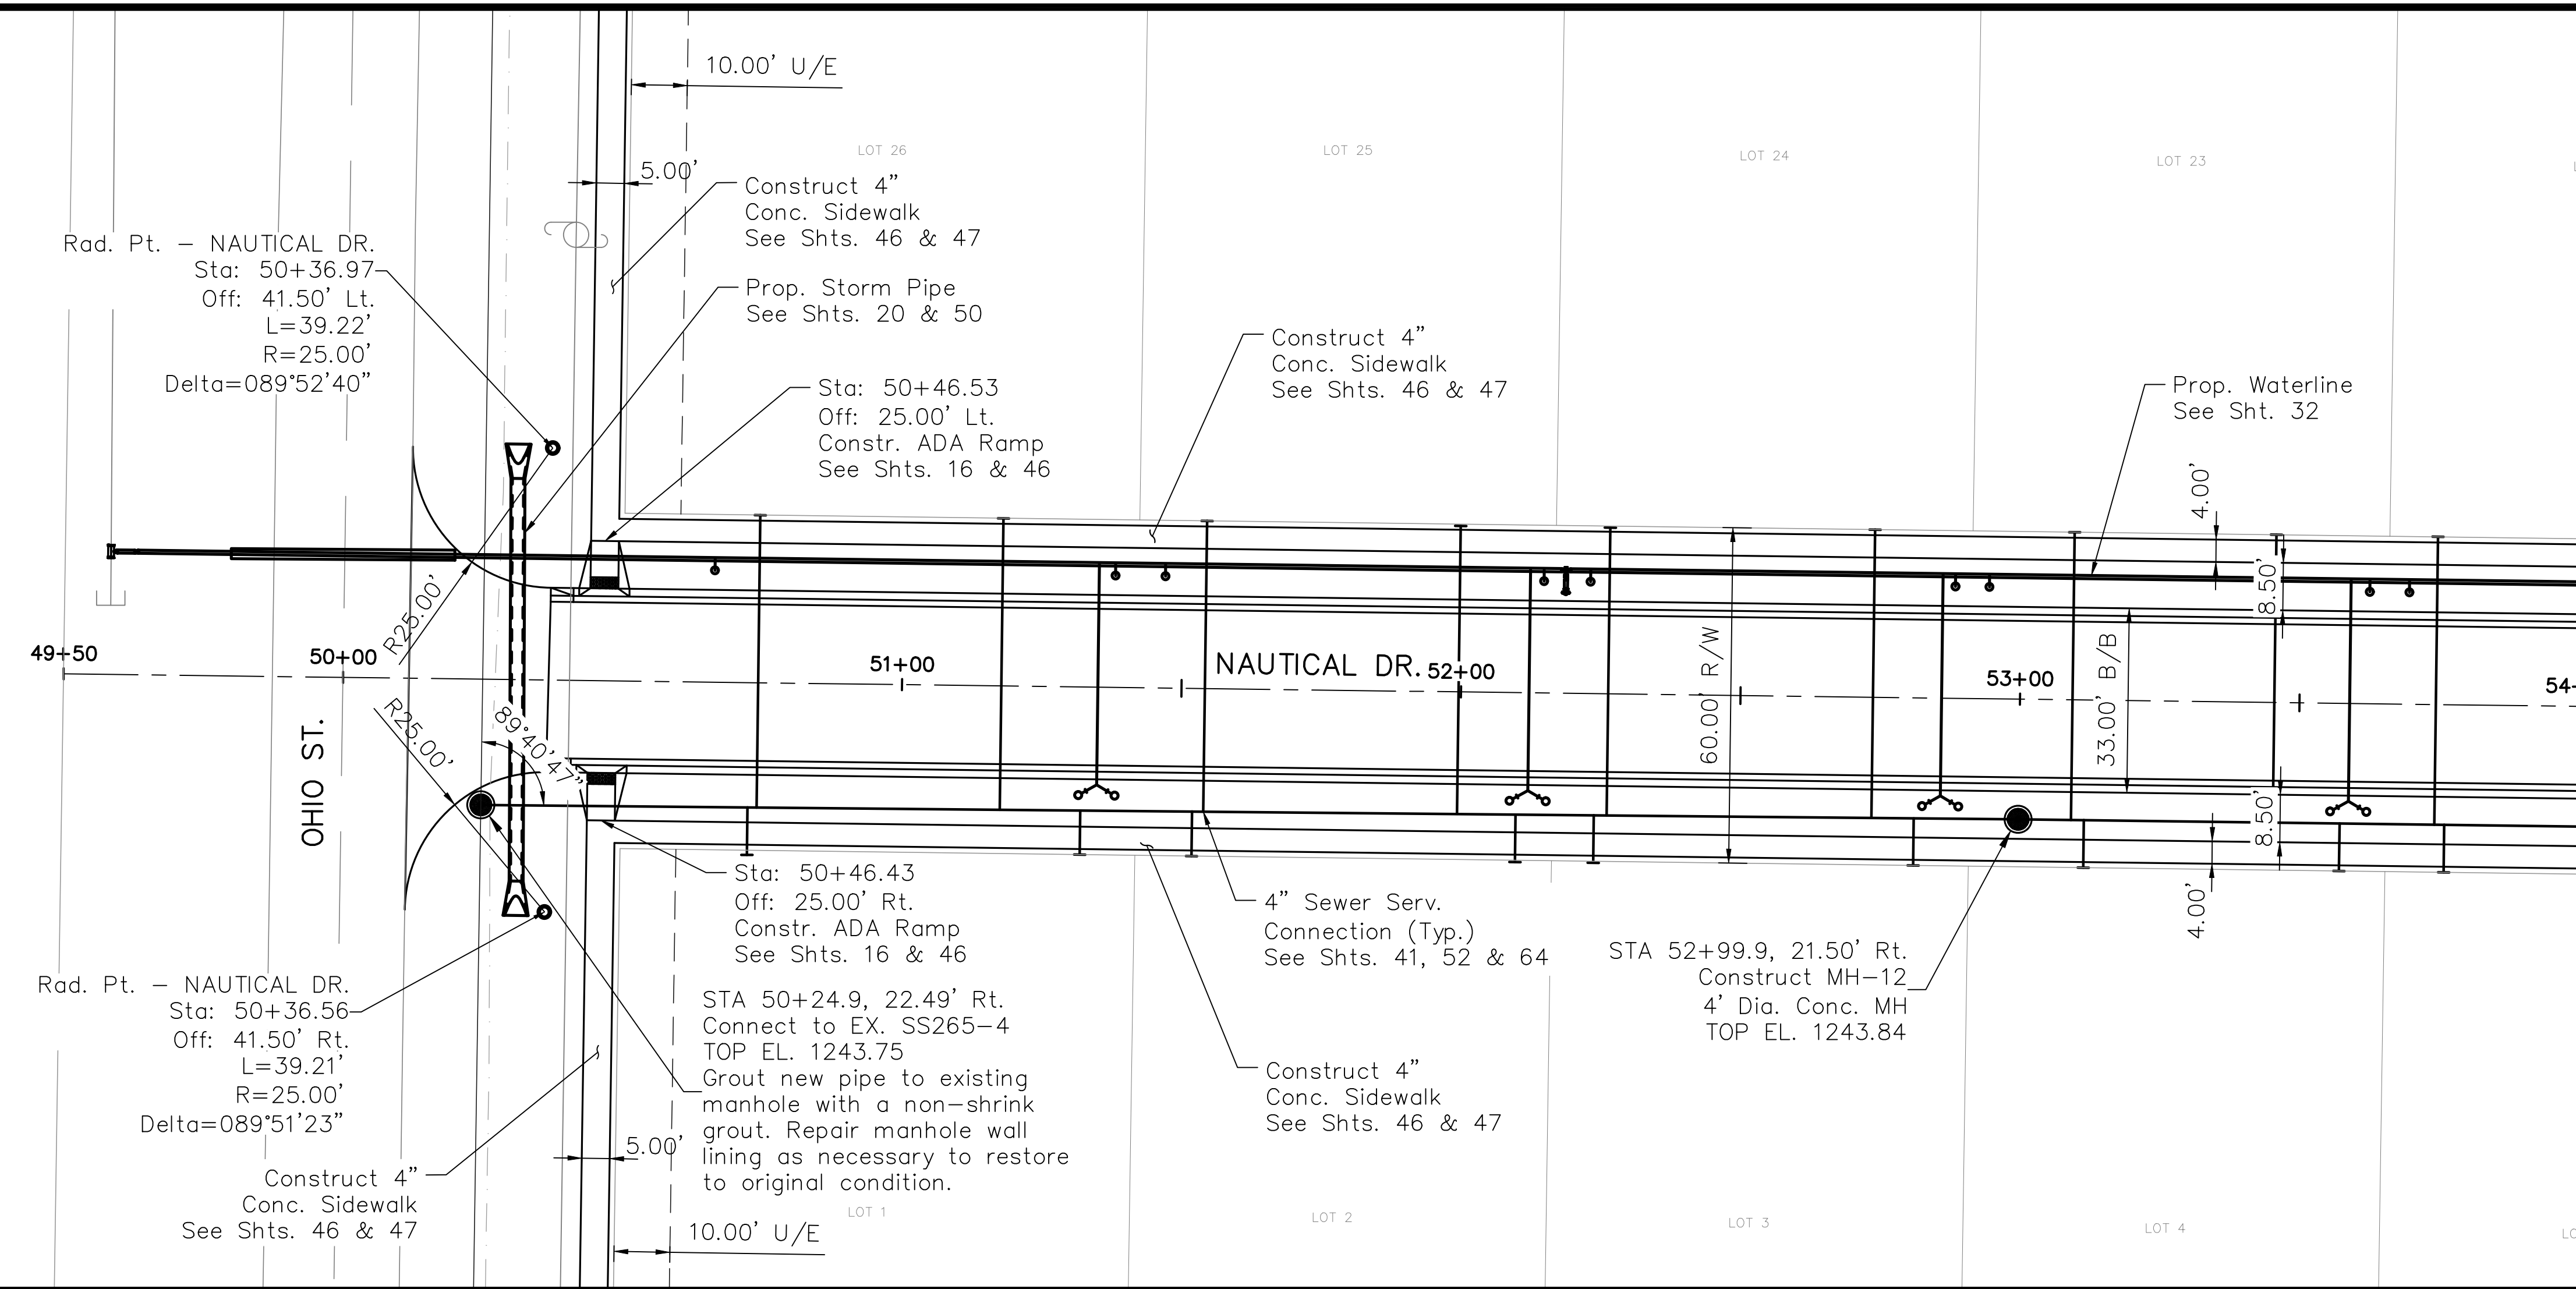

PROFILE SCALE:
 HORIZONTAL: 1" = 20'
 VERTICAL: 1" = 5'


NO.	DATE	DESCRIPTION
1	11/18/21	Revised Lot Grading & Sidewalks

EARLES ENGINEERING & INSPECTION, INC.
 Civil & Structural Engineers
 Construction Inspectors - Surveyors
 Email: earlesinc@earleseng.com

KANSAS

RYAN ADDITION STREET & SANITARY SEWER NAUTICAL DR STA. 49+50 TO 54+00

CITY OF SALINA

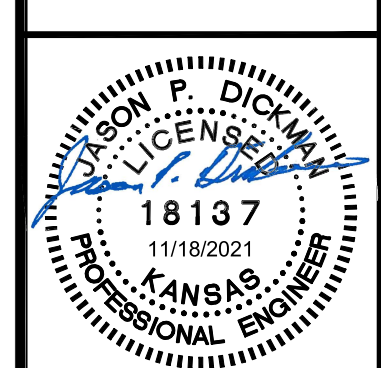

ENGINEER:	JPD
CHECKED BY:	PWE
DRAWN BY:	DRB/BFS/JMR
DATE:	11-15-2021
PROJECT NO:	13-23
SHEET:	9 of 94