


**TIM ROGERS LANE**

**WATER & SANITARY SEWER**

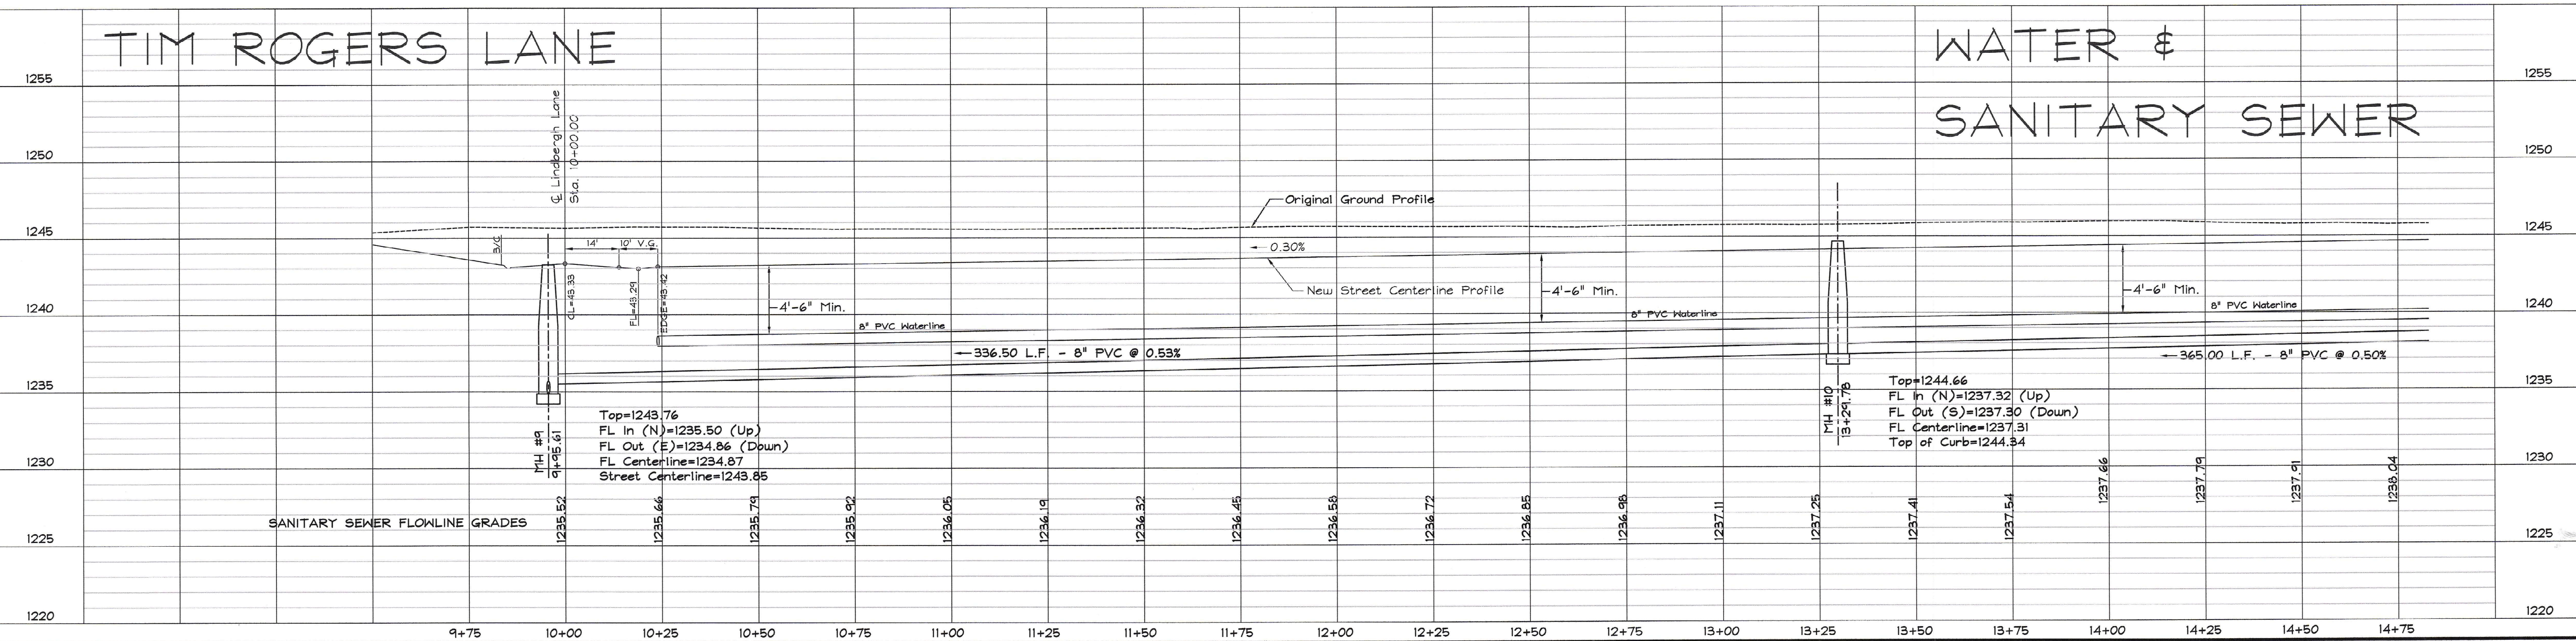

APPENDUM #1  
TIM ROGERS - WATER & SEWER