


WRIGHT LANE

WATER & SANITARY SEWER

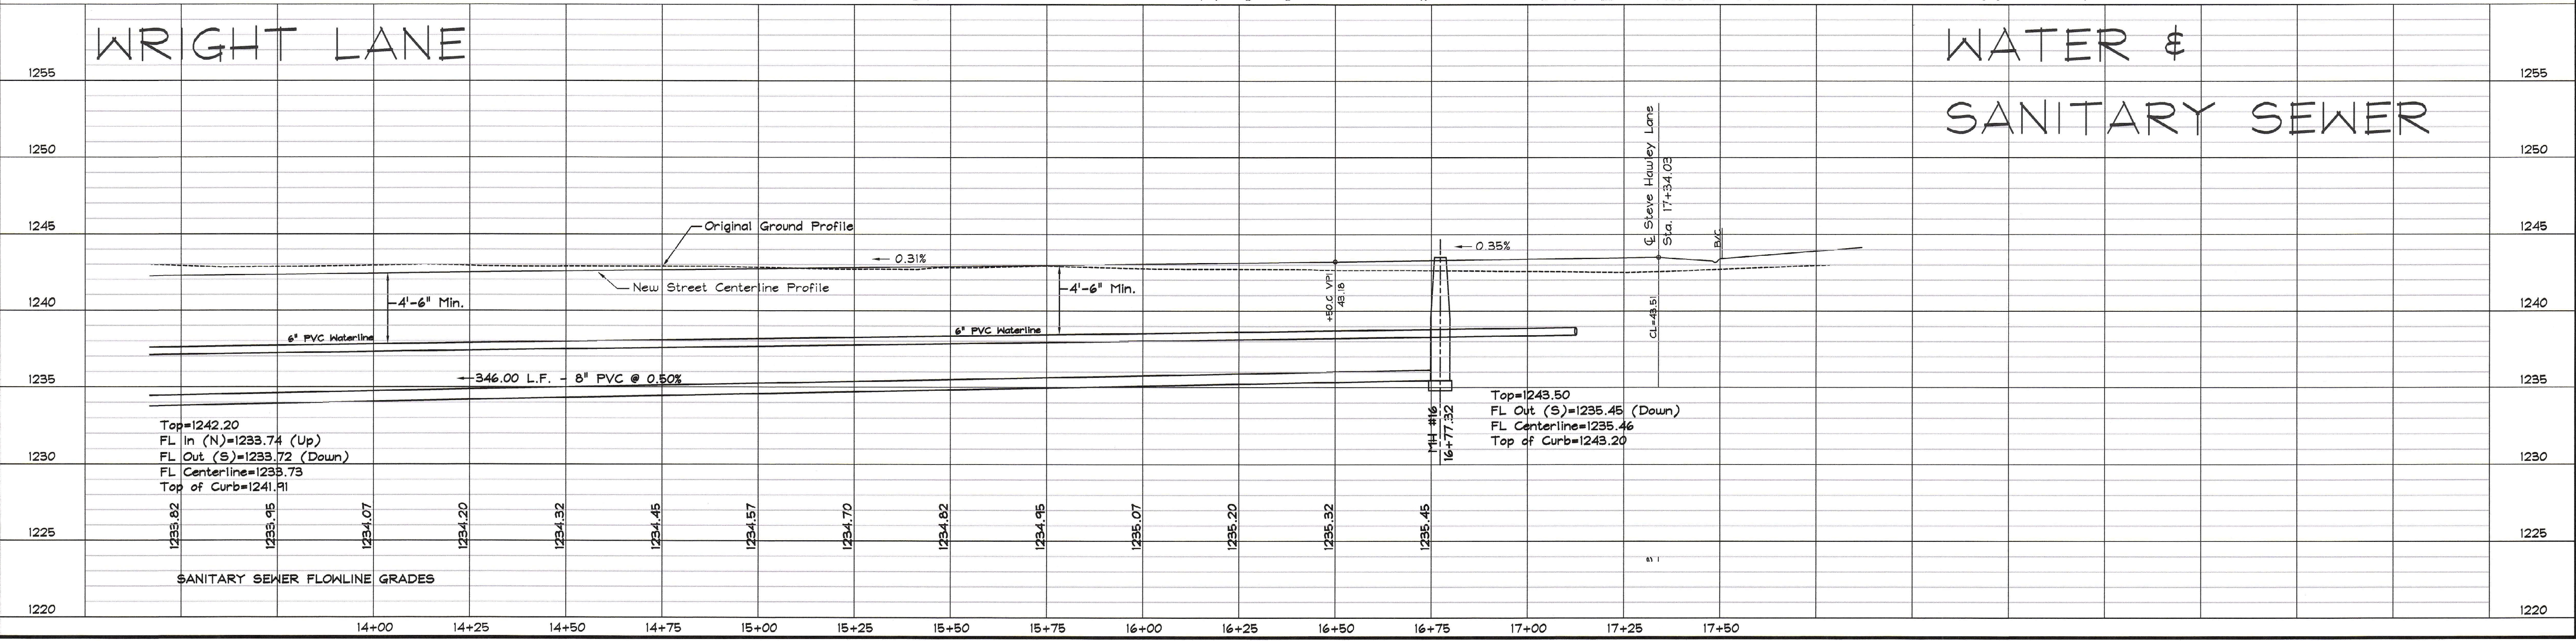

WRIGHT - WATER & SEWER