

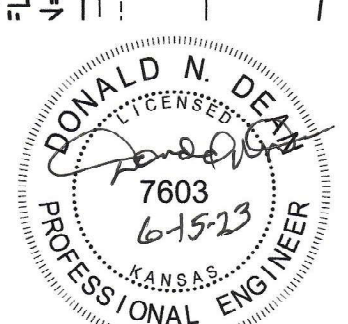
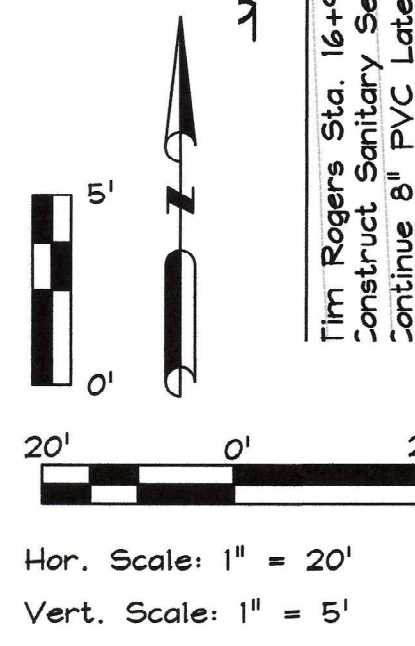


BLOCK 2

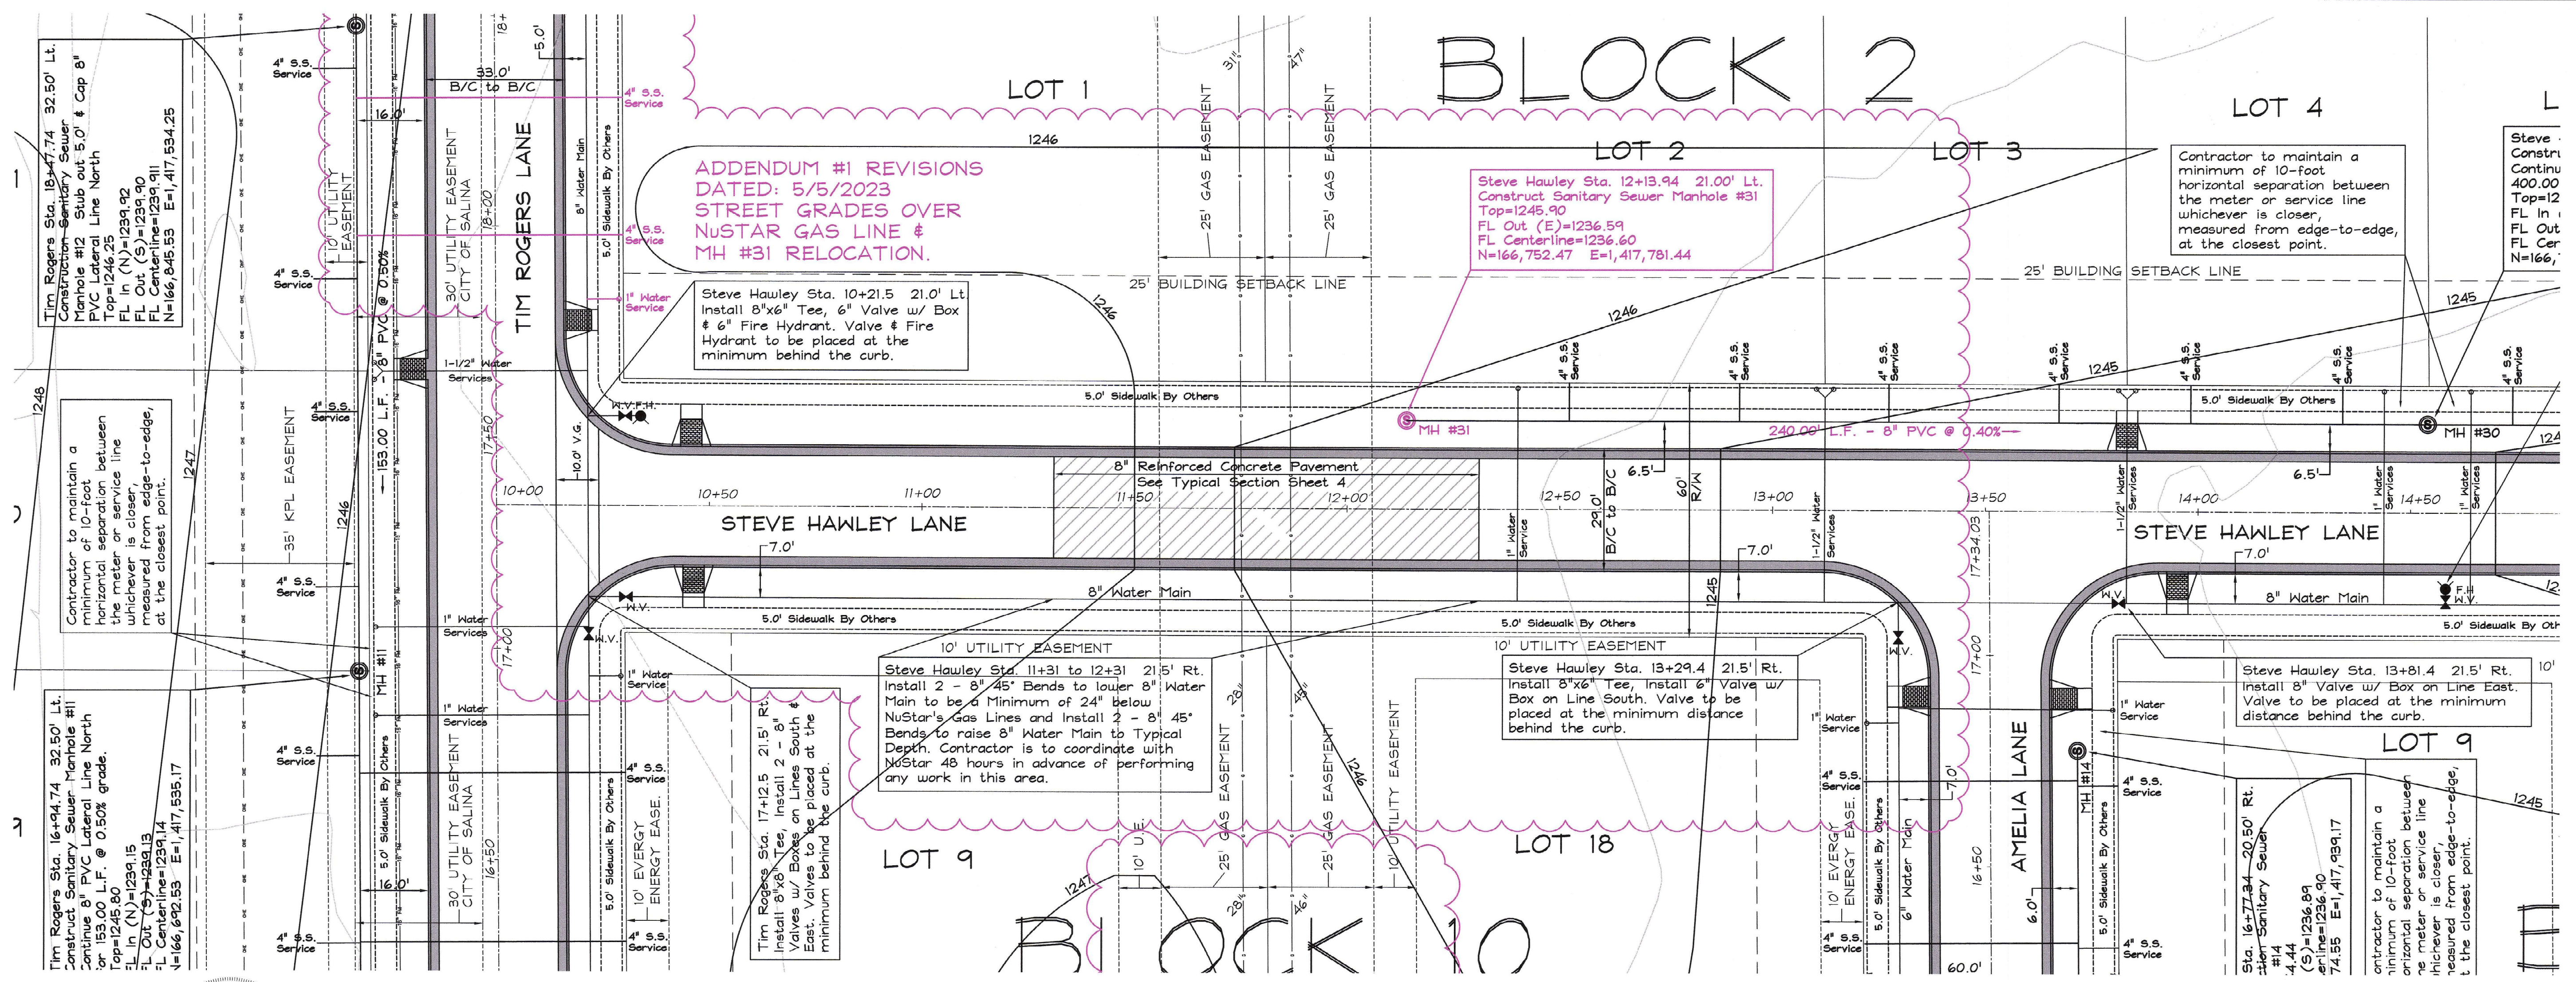

STEVE HAWLEY LANE

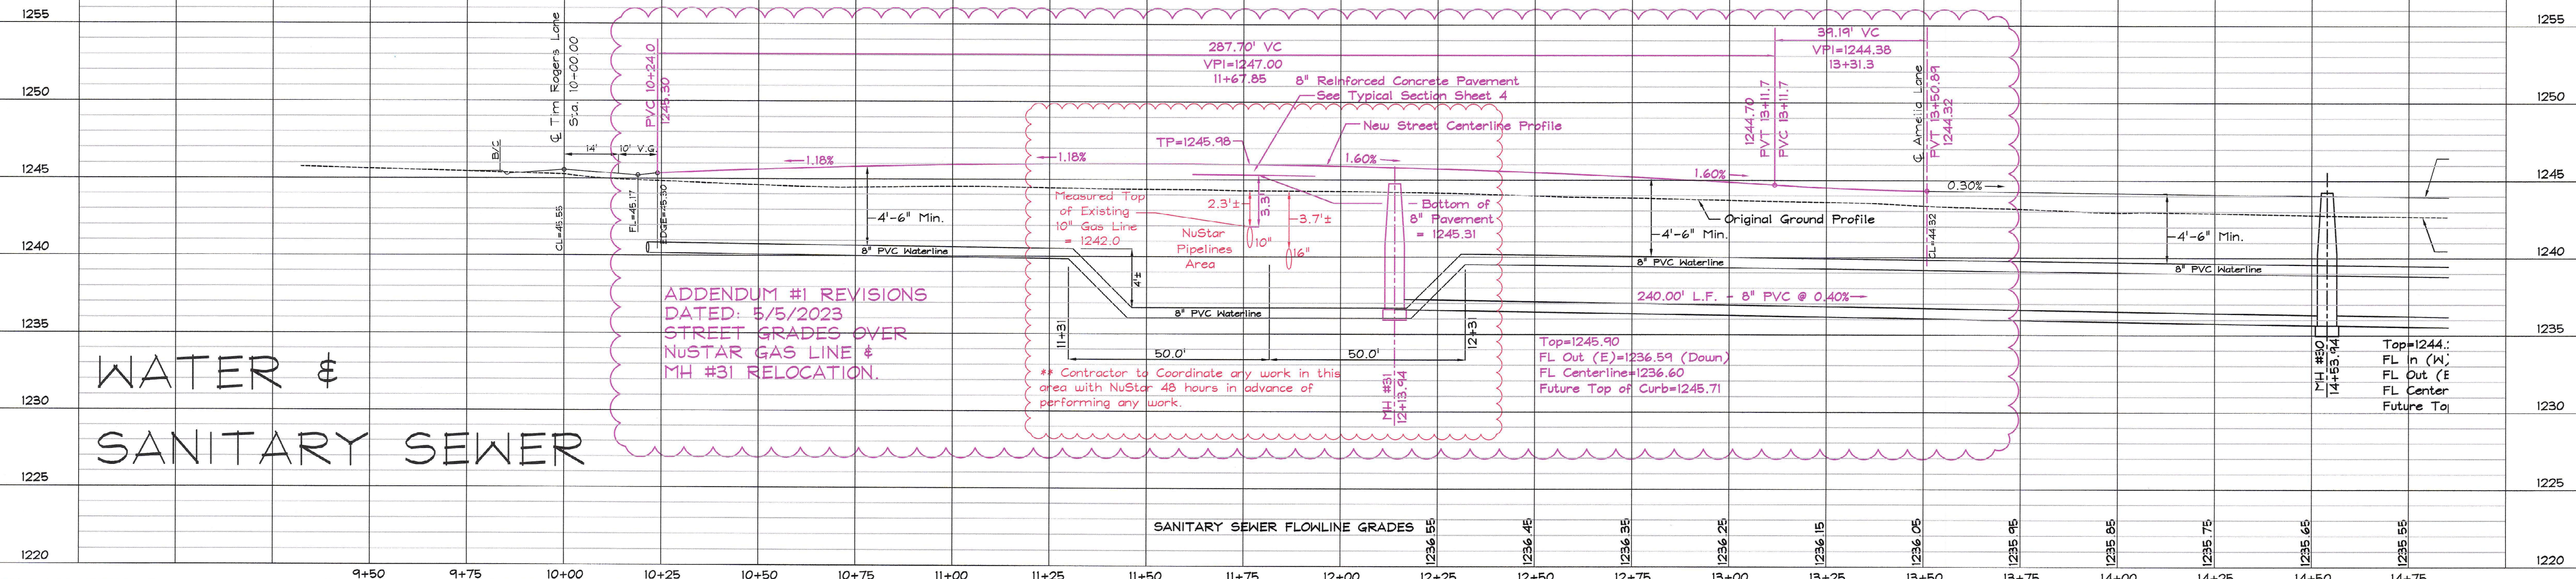

WATER & SANITARY SEWER

ADDENDUM #1
 STEVE HAWLEY - WATER & SEWER