



Steve Hawley Sta. 25+42.94 21.00' Lt.  
 Construct Sanitary Sewer Manhole #27  
 Continue 8" PVC Lateral Line West for  
 355.00 L.F. @ 0.40% grade.  
 Top=1242.90  
 FL In (W)=1231.29  
 FL Out (E)=1231.27  
 FL Centerline=1231.28  
 N=166,749.10 E=1,419,110.44

Yeager Sta. 17+70.37 23.25' Rt.  
 Construct Sanitary Sewer Manhole #25  
 Stub Out 8" PVC Lateral Line 5.0'  
 L.F. North & Cap  
 Begin 8" PVC Lateral Line West for  
 370.00 L.F. @ 0.40% grade.  
 Top=1229.25  
 FL In (W)=1229.80  
 FL Out (S)=1229.29  
 FL Centerline=1229.30  
 N=166,739.91 E=1,419,480.32

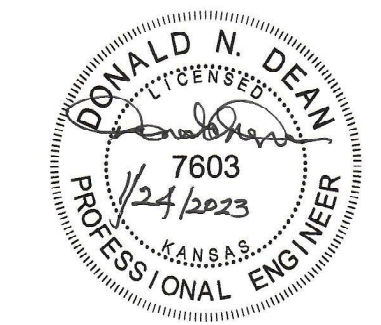

STEVE HAWLEY LANE SANITARY SEWER

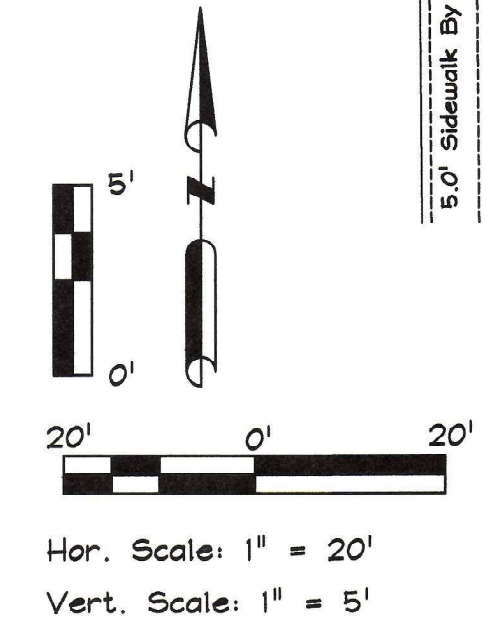