


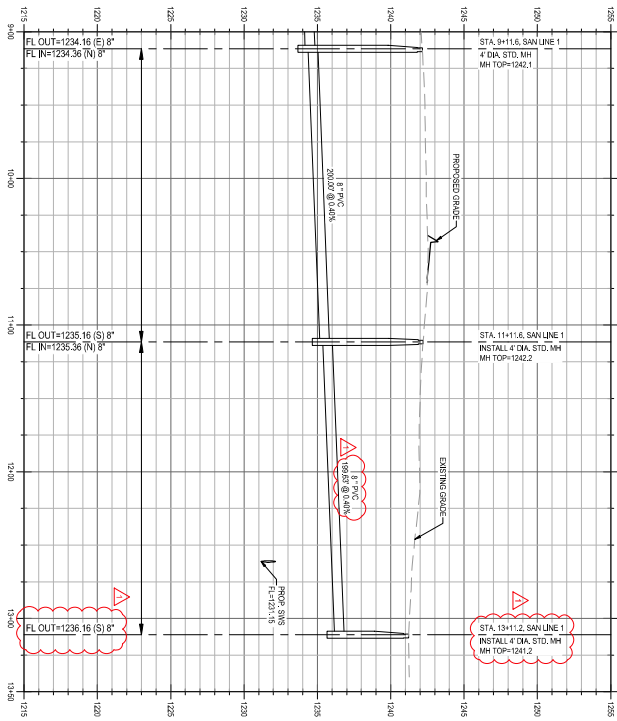


**4 SANITARY LINE 1 (CONT.2) PROFILE**

SCALE: VERTICAL 1" = 4', HORIZONTAL 1" = 40'



**3 SANITARY LINE 1 (CONT.2) PLAN**

GRAPHIC SCALE: 1" = 40'

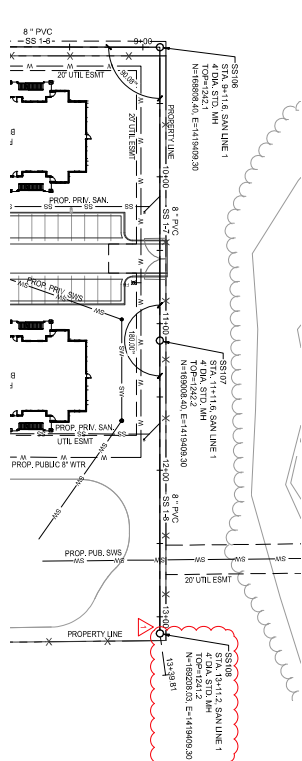

REVISION 1	01/12/2024
DESCRIPTION	DATE
PROJECT NO.	1060600001
STATUS	REVISION SET
DATE	01/02/24
DRAWN BY	MM
CHECKED BY	MM

SANITARY SEWER  
 PLAN & PROFILE -  
 LINE 1

**CU221**

SALINA DESTINATION DEVELOPMENT  
**SALINA APARTMENTS - PHASE 1A**  
 VIRGINIA DR  
 SALINA, KS 67401

