


35/77

DRAWN
 CHECKED
 DATE 10/16/2009
 SCALE 1" = 20'
 JOB NO. 07074
 SHEET

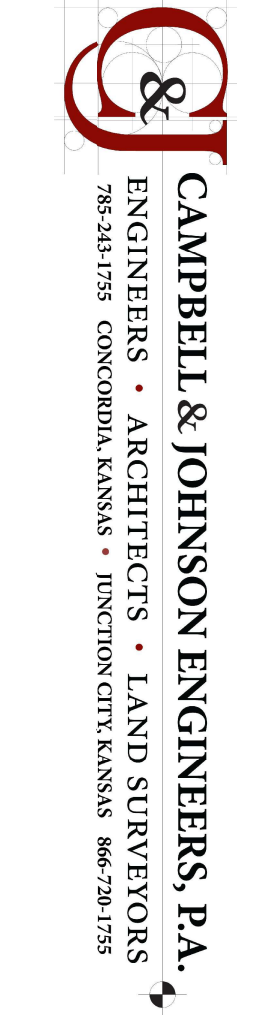

Waterline/San Sewer Sheet
 Grand Prairie Addition
 City of Salina, KS

REVISIONS