


38/77

SHEET
JOB NO. 07074
SCALE 1" = 20'
DATE 10/16/2009
CHECKED DND
DRAWN GLA

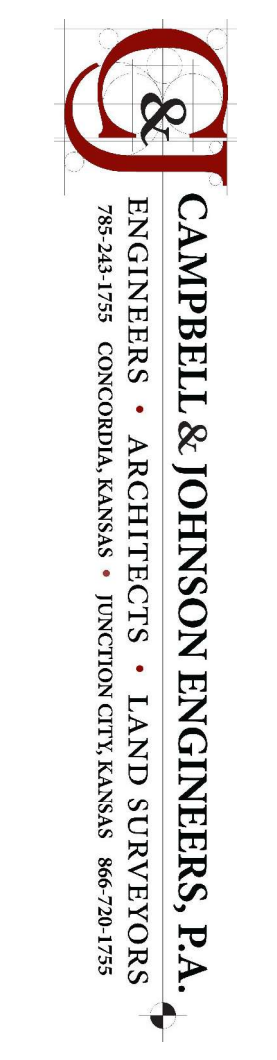

Waterline/San Sewer Sheet
Grand Prairie Addition
City of Salina, KS

REVISIONS