


SANITARY SEWER—LINE D  
 BENTGRASS DRIVE  
 WATER/SANITARY SEWER SHEET  
 PHASE 1

40/77

DRAWN  
 CHECKED  
 DATE 10/16/2009  
 SCALE 1" = 20'  
 JOB NO. 07074  
 SHEET

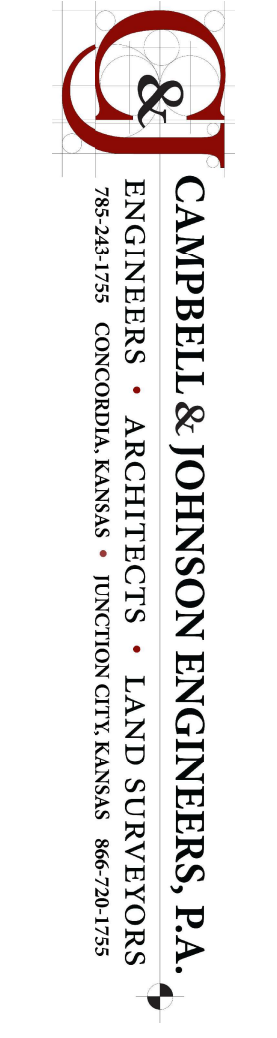

Waterline/San Sewer Sheet  
 Grand Prairie Addition  
 City of Salina, KS

REVISIONS