



E1
SCALE: 1" = 20'
SANITARY SEWER PLAN



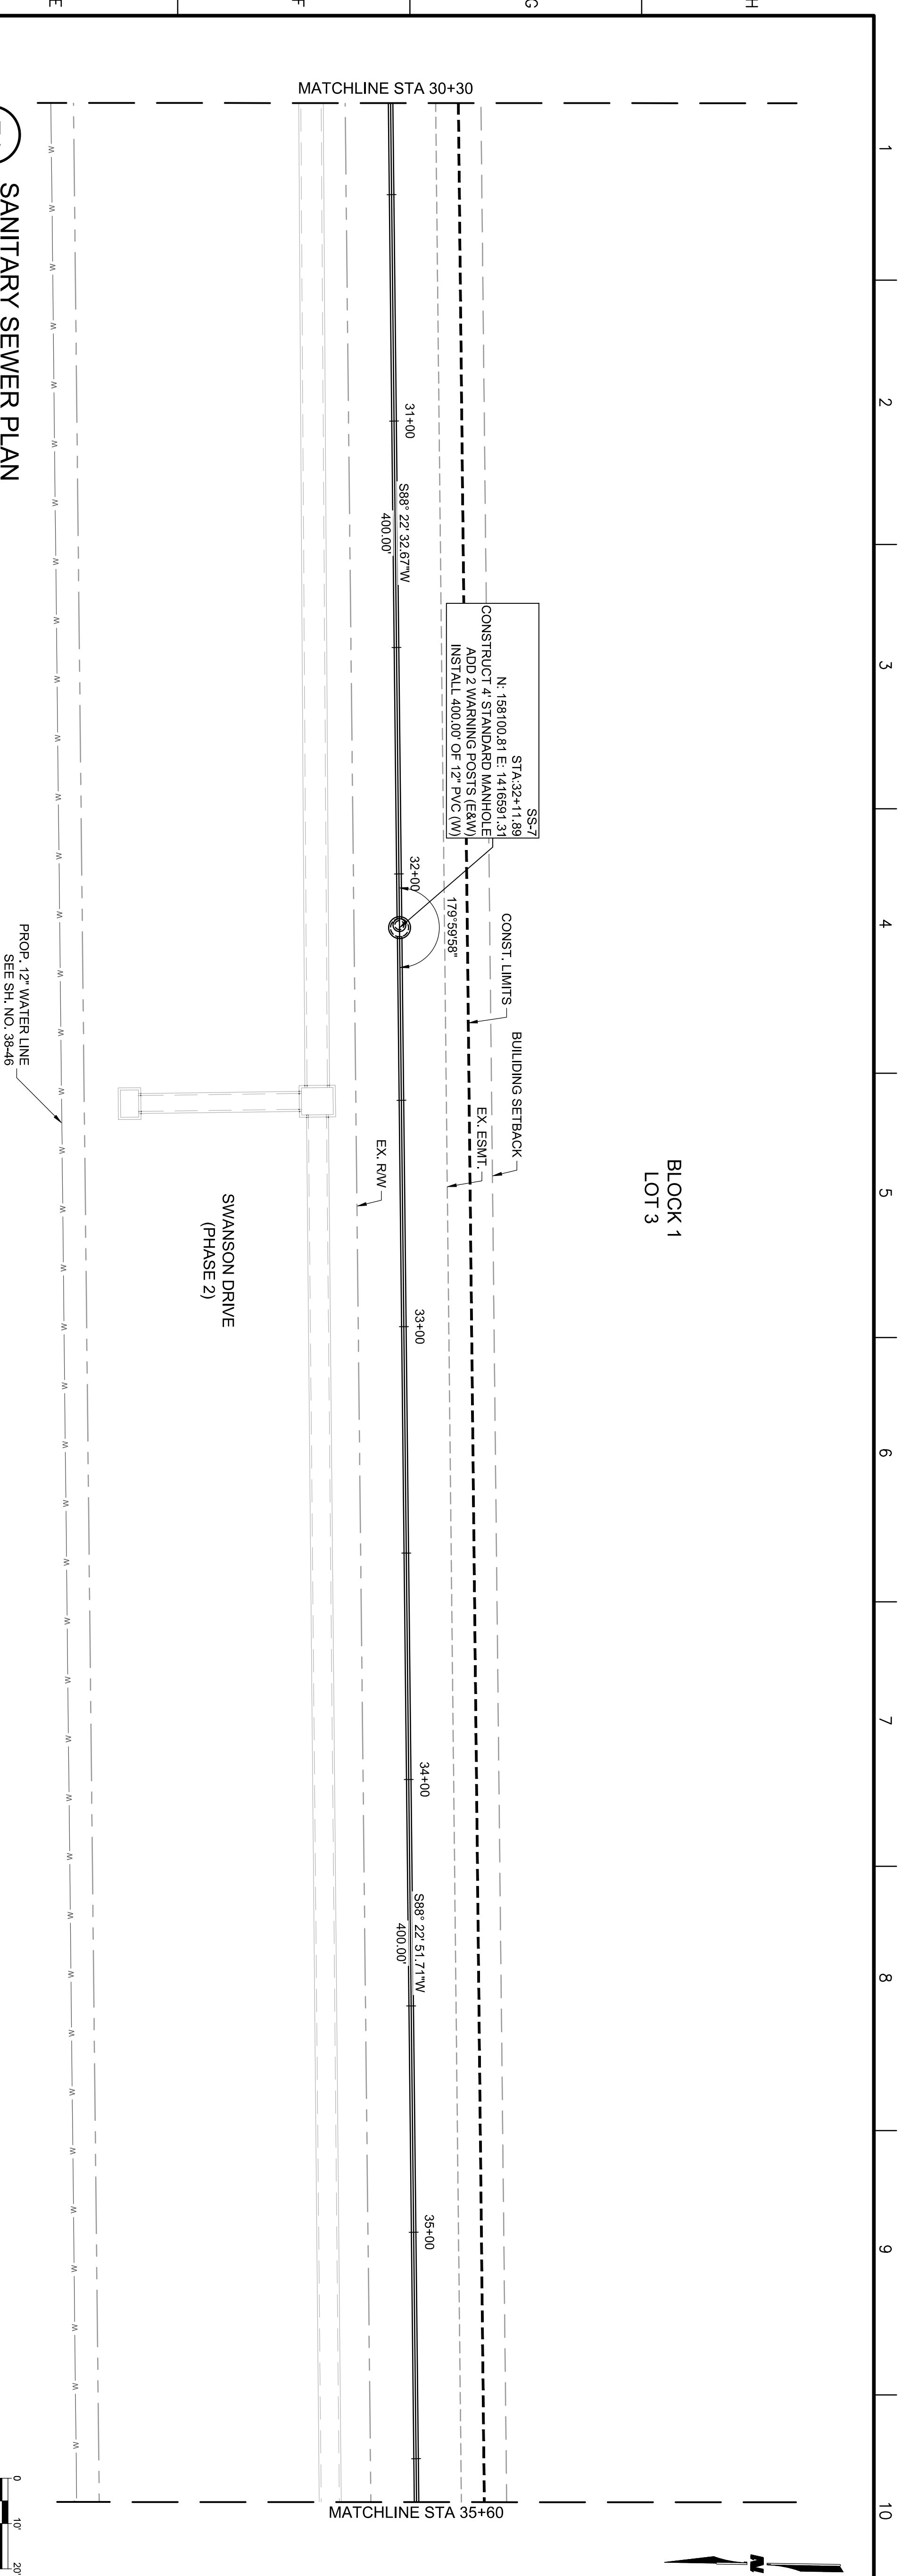


BLOCK 1
LOT 3

SWANSON DRIVE
(PHASE 2)

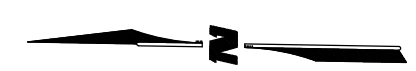

A1
SCALE: 1" = 20'
SANITARY SEWER PROFILE

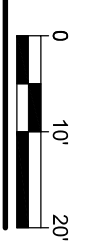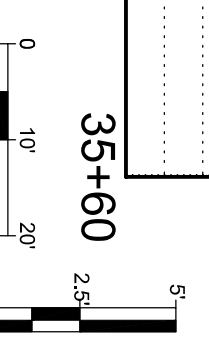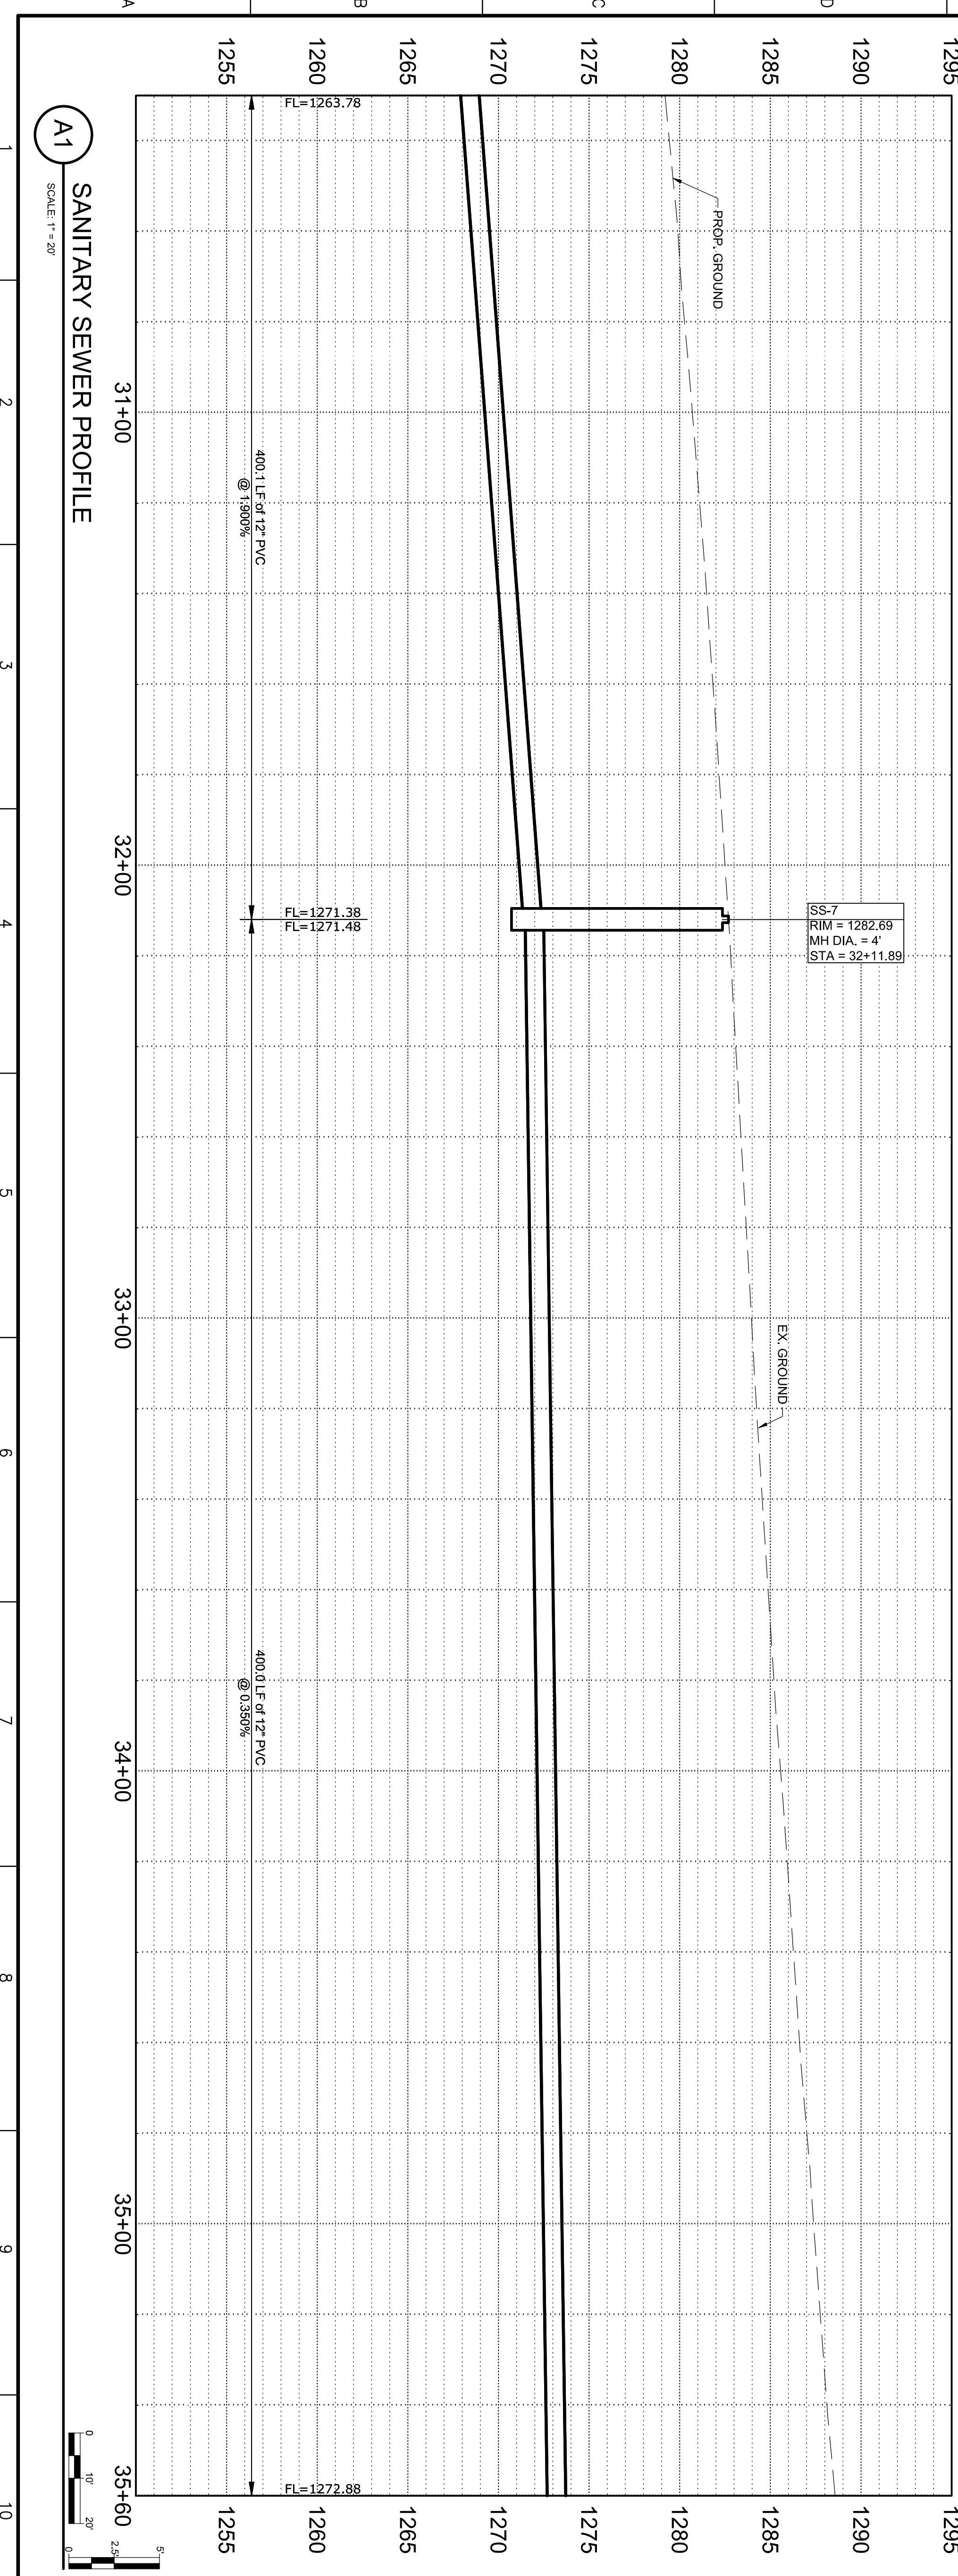

SHEET NO: 51 OF 103	SHEET TITLE SANITARY SEWER PLAN & PROFILE	PROJECT NO.: 24-000-292-01 DESIGNED BY: TAW DRAWN BY: TAW CHECKED BY: DJM DATE: 10/21/2024	<table border="1" style="width: 100%; border-collapse: collapse;"> <thead> <tr> <th>REV.</th> <th>DATE</th> <th>DESCRIPTION</th> <th>BY</th> </tr> </thead> <tbody> <tr> <td>1</td> <td>10/18/24</td> <td>ADDENDUM 1</td> <td>AJM</td> </tr> </tbody> </table>	REV.	DATE	DESCRIPTION	BY	1	10/18/24	ADDENDUM 1	AJM	PROJECT NAME CITY OF SALINA, KS SALINA AIRPORT AUTHORITY (SAA) PROJECT 80 PHASE I	SEAL 	CONSULTANTS
REV.	DATE	DESCRIPTION	BY											
1	10/18/24	ADDENDUM 1	AJM											

WILSON & COMPANY
1700 EAST IRON AVE.
SALINA, KS 67401
PHONE: 785-827-0433
FAX: 785-827-5949
www.wilsonco.com