


SCALE:
 PLAN: 1"=20'
 PROFILE: 1"=20' HORIZ.
 1"=5' VERT.

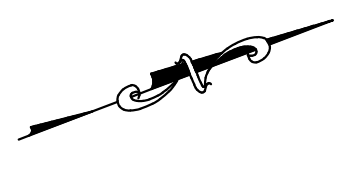

- SEPARATION OF WATER MAINS AND SANITARY SEWERS:**
1. A MINIMUM HORIZONTAL DISTANCE OF 10 FEET SHALL BE MAINTAINED BETWEEN WATER (MANS AND SERVICE) AND SANITARY SEWER (MANS AND SERVICE) LINES. AT POINT WHERE SEWERS CROSS WATER MAINS, THE SEWER SHALL BE OVER THE WATER MAIN. SEWER SHALL BE OR PIPE ENCASED IN CONCRETE FOR A DISTANCE OF 10 FEET EACH SIDE OF THE OUTSIDE DIAMETER OF THE SEWER LINE (EDGE-TO-EDGE), NOT ITS CENTERLINE, UNLESS THE WATER MAIN IS AT LEAST 2 FEET ABOVE THE SEWER.
 2. WHERE A WATER MAIN MUST CROSS A SEWER LINE, MAINTAIN 2 FEET VERTICAL SEPARATION WITH THE WATER MAIN ABOVE THE SEWER.
 3. BUILDERS TO MAINTAIN MINIMUM 10' SEPARATION FROM THE OUTSIDE EDGE OF SANITARY SEWER MANHOLES TO THE OUTSIDE EDGE OF WATER SERVICE LINES WHEN RUNNING SERVICE LINES TO HOUSE.
 4. ALL SANITARY SEWER SERVICE LINE WILL BE AT A MIN 2% GRADE.
 5. ALL NORTHING AND EASTING WAS TAKEN FROM CENTER OF STRUCTURE. REFERENCE DETAIL FOR ACTUAL LID LOCATION.

THIS DRAWING SHALL NOT BE UTILIZED BY ANY PERSON, FIRM, OR CORPORATION IN WHOLE OR IN PART WITHOUT THE SPECIFIC PERMISSION OF KAW VALLEY ENGINEERING, INC.

STONE LAKE ADDITION - PHASE 2		SHORELINE DRIVE		SALINA, KANSAS 67401																									
PROJ. NO. E1922116 DESIGNER MO DRAWN BY TDA		 KAW VALLEY ENGINEERING <small>KAW VALLEY ENGINEERING, INC. IS AUTHORIZED TO OFFER ENGINEERING SERVICES BY KANSAS STATE CERTIFICATE OF AUTHORIZATION # E-113, EXPIRES 12/31/20</small>		JUSTIN M. OWENS ENGINEER KS # 20933																									
SHEET 14 REV 2				<table border="1" style="width: 100%; border-collapse: collapse;"> <thead> <tr> <th>REV</th> <th>DATE</th> <th>DESCRIPTION</th> <th>DSN</th> <th>DWN</th> <th>CHK</th> </tr> </thead> <tbody> <tr> <td>2</td> <td>10/31/19</td> <td>PER KDHE COMMENTS</td> <td>JMO</td> <td>TDA</td> <td>JMO</td> </tr> <tr> <td>1</td> <td>07/31/19</td> <td>PER KDHE COMMENTS</td> <td>JMO</td> <td>TDA</td> <td>JMO</td> </tr> <tr> <td>0</td> <td>05/31/19</td> <td>INITIAL ISSUE</td> <td>JMO</td> <td>TDA</td> <td>JMO</td> </tr> </tbody> </table>		REV	DATE	DESCRIPTION	DSN	DWN	CHK	2	10/31/19	PER KDHE COMMENTS	JMO	TDA	JMO	1	07/31/19	PER KDHE COMMENTS	JMO	TDA	JMO	0	05/31/19	INITIAL ISSUE	JMO	TDA	JMO
REV	DATE	DESCRIPTION	DSN	DWN	CHK																								
2	10/31/19	PER KDHE COMMENTS	JMO	TDA	JMO																								
1	07/31/19	PER KDHE COMMENTS	JMO	TDA	JMO																								
0	05/31/19	INITIAL ISSUE	JMO	TDA	JMO																								