



Revised By: BRIST
 Plotted: 2/26/2024 11:10 AM

Filename: 21-85_C00_SANITARY_5.DWG
 File Location: F:\2021\21-85 North McArthur\Drawings\Plan_Sat

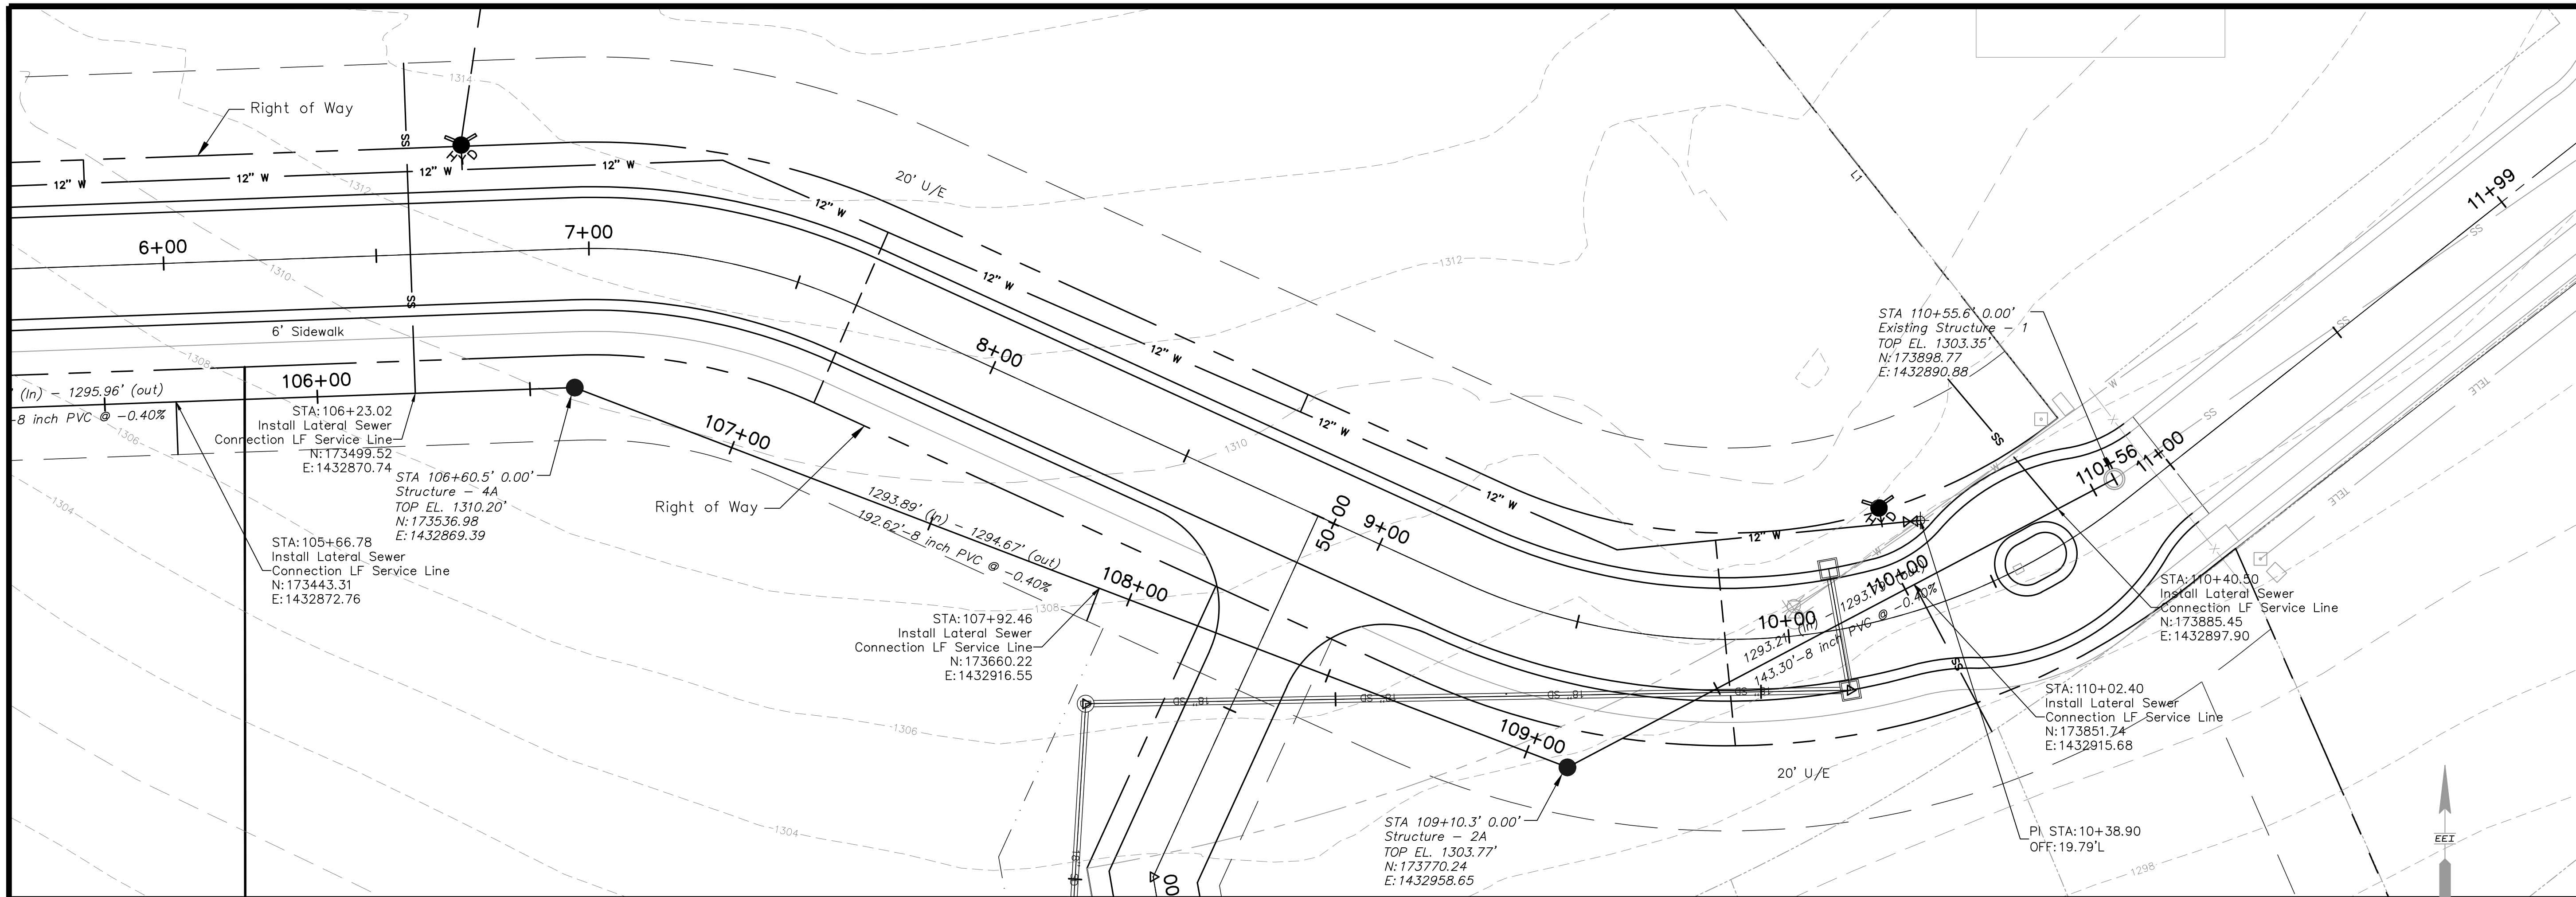

SCALE:
 PLAN: 1" = 20'
 PROFILE: 1" = 20'
 HORIZONTAL: 1" = 20'
 VERTICAL: 1" = 4'

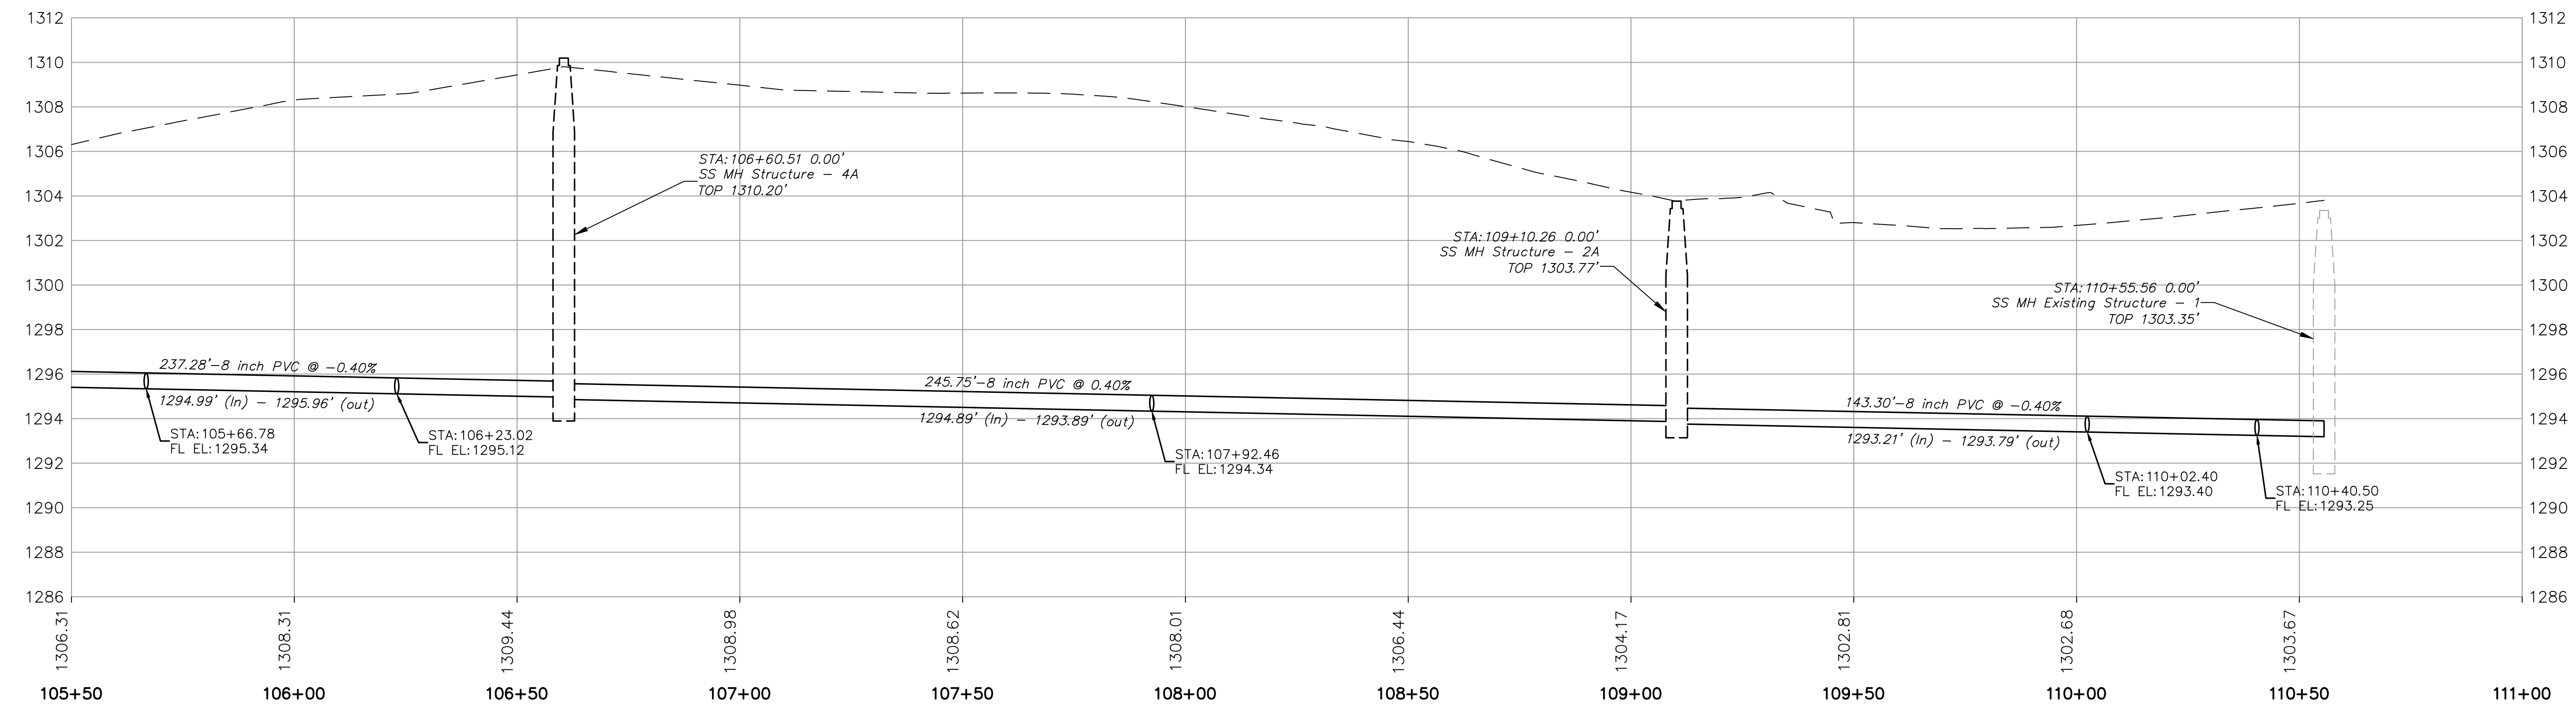

NO.	DATE	DESCRIPTION

EARLES ENGINEERING & INSPECTION, INC.
 Civil & Structural Engineers
 Constructors - Inspectors - Surveyors
 Email: earlesinc@earleseng.com

OVERLOOK ESTATES
SEWER PLAN & PROFILE 2
 KANSAS
 SALINA



ENGINEER: ENH
 CHECKED BY: PWE
 DRAWN BY: TGS
 DATE: 2/26/2024
 PROJECT NO: 21-85
 SHEET: 11 of ??