

DATE: \_\_\_\_\_  
 BY: R.E.B.  
 SURVEYED: \_\_\_\_\_  
 NOTE BOOK: \_\_\_\_\_  
 ALIGNMENT CHECKED: \_\_\_\_\_  
 RT. OF WAY CHECKED: \_\_\_\_\_  
 PLAN NO. \_\_\_\_\_

DATE: \_\_\_\_\_  
 BY: R.E.B.  
 SURVEYED: \_\_\_\_\_  
 NOTE BOOK: \_\_\_\_\_  
 GRADES CHECKED: \_\_\_\_\_  
 B. M. NOTED: \_\_\_\_\_  
 STRUCTURE NOTATIONS CHKD: \_\_\_\_\_  
 PROFILE NO. \_\_\_\_\_

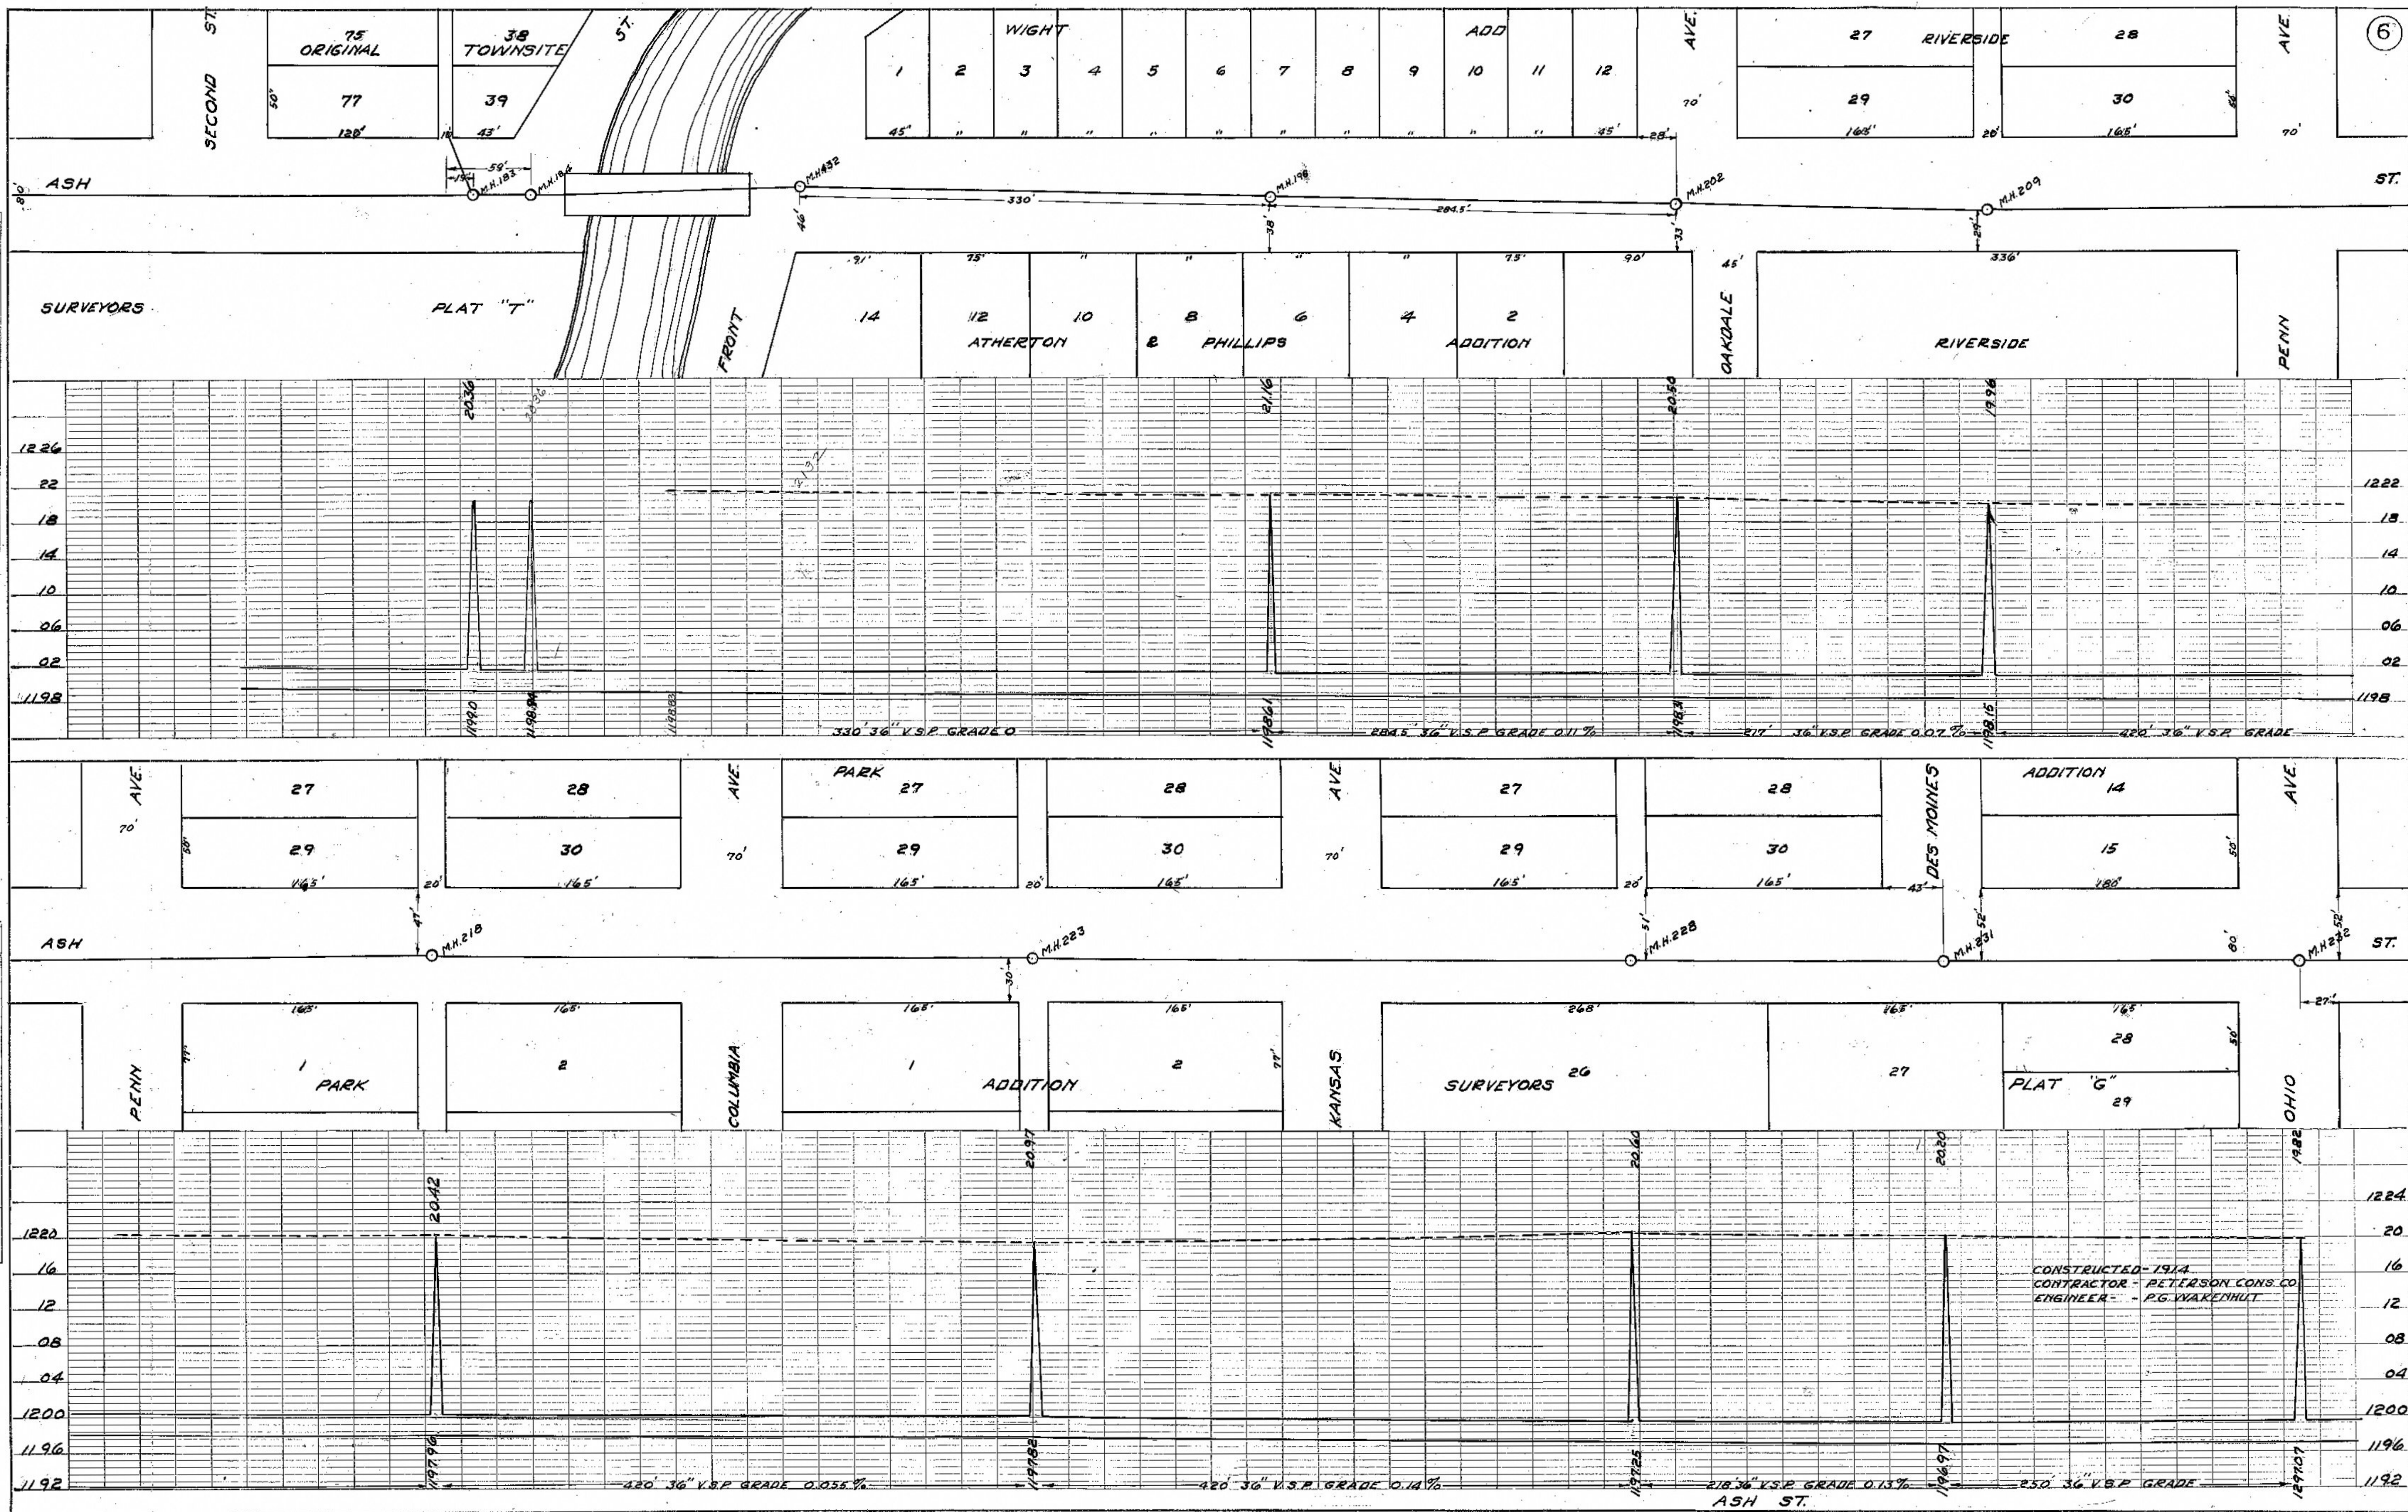


PLATE 2-PLAN-PROFILE D. P. R. STANDARD

MAIN SEWER "E"