



7

PLAN
 SURVEYED...
 PLANT CHECKED...
 NOTE BOOK NO. 1218
 DATE 12/1/1914

PROFILE
 SURVEYED...
 GRADES CHECKED...
 NOTE BOOK NO. 1218
 DATE 12/1/1914

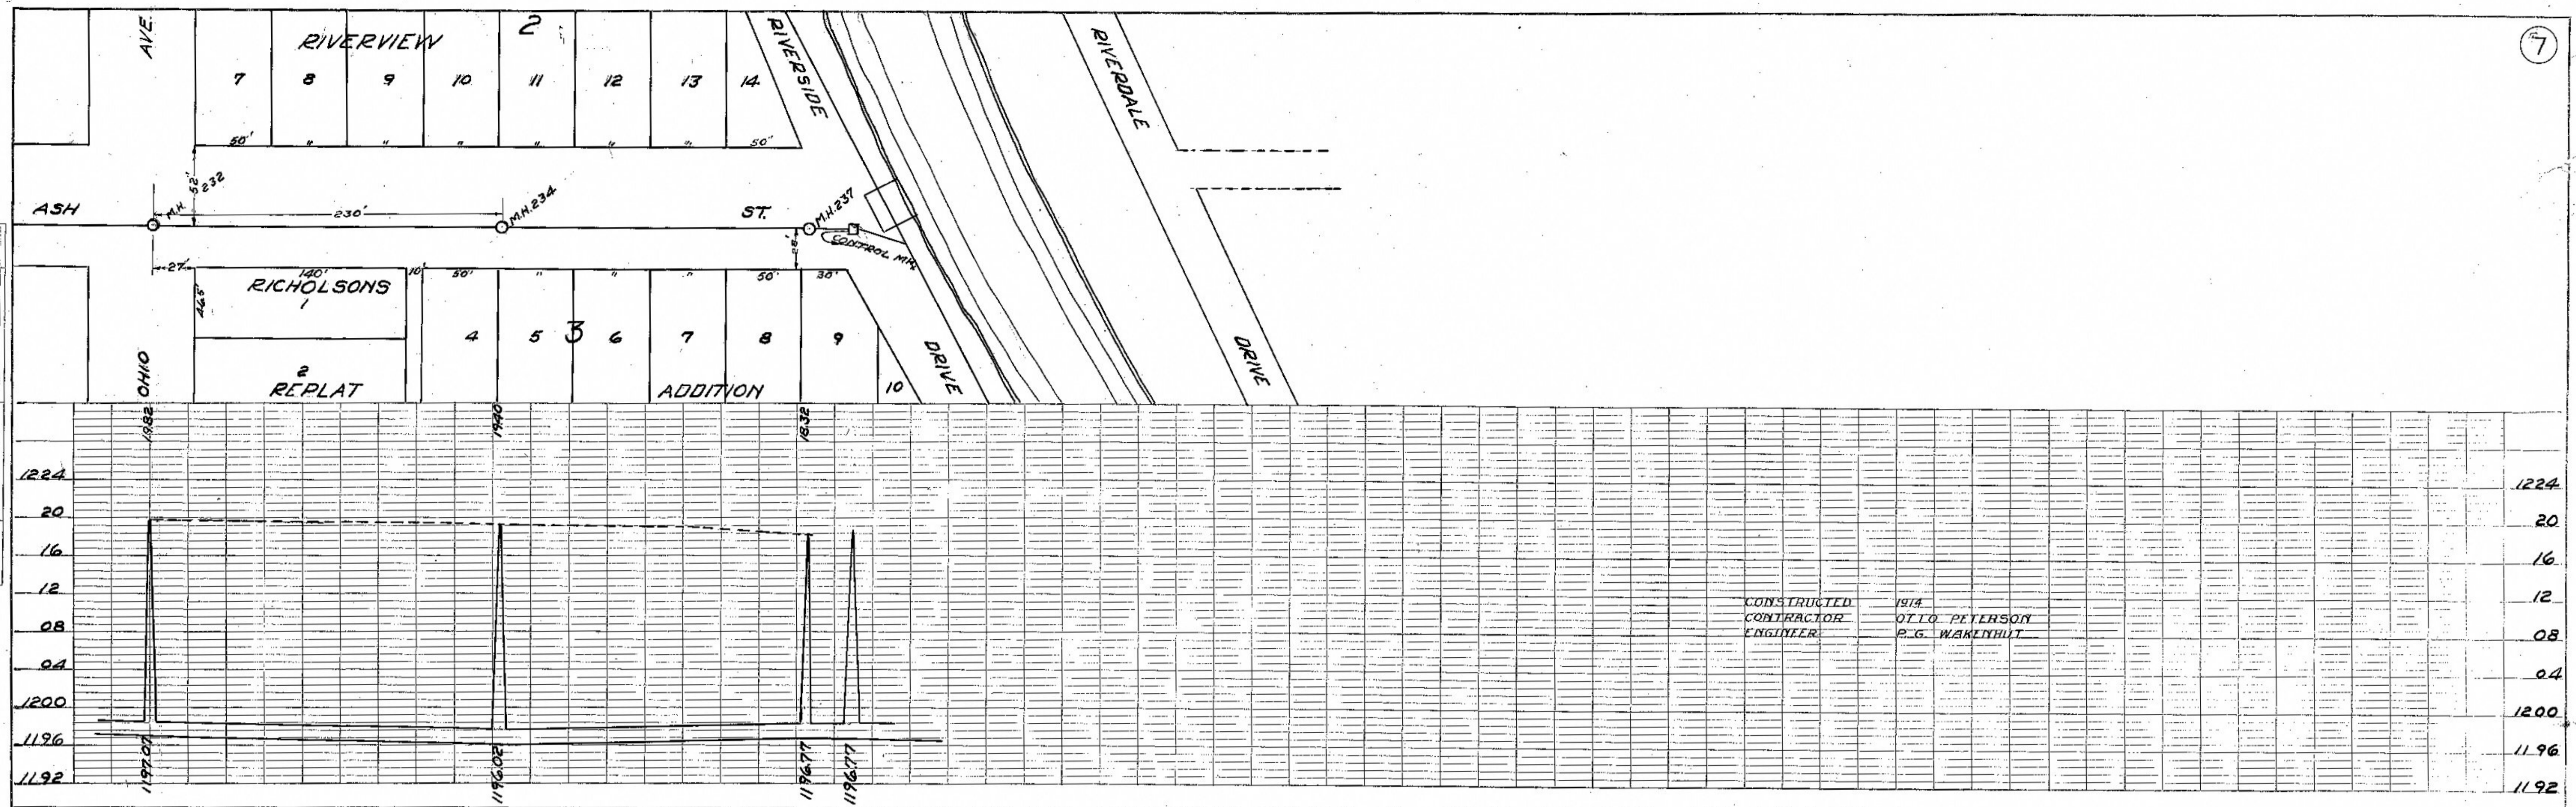

CONSTRUCTED BY
 CONTRACTOR OTTO PEYERSON

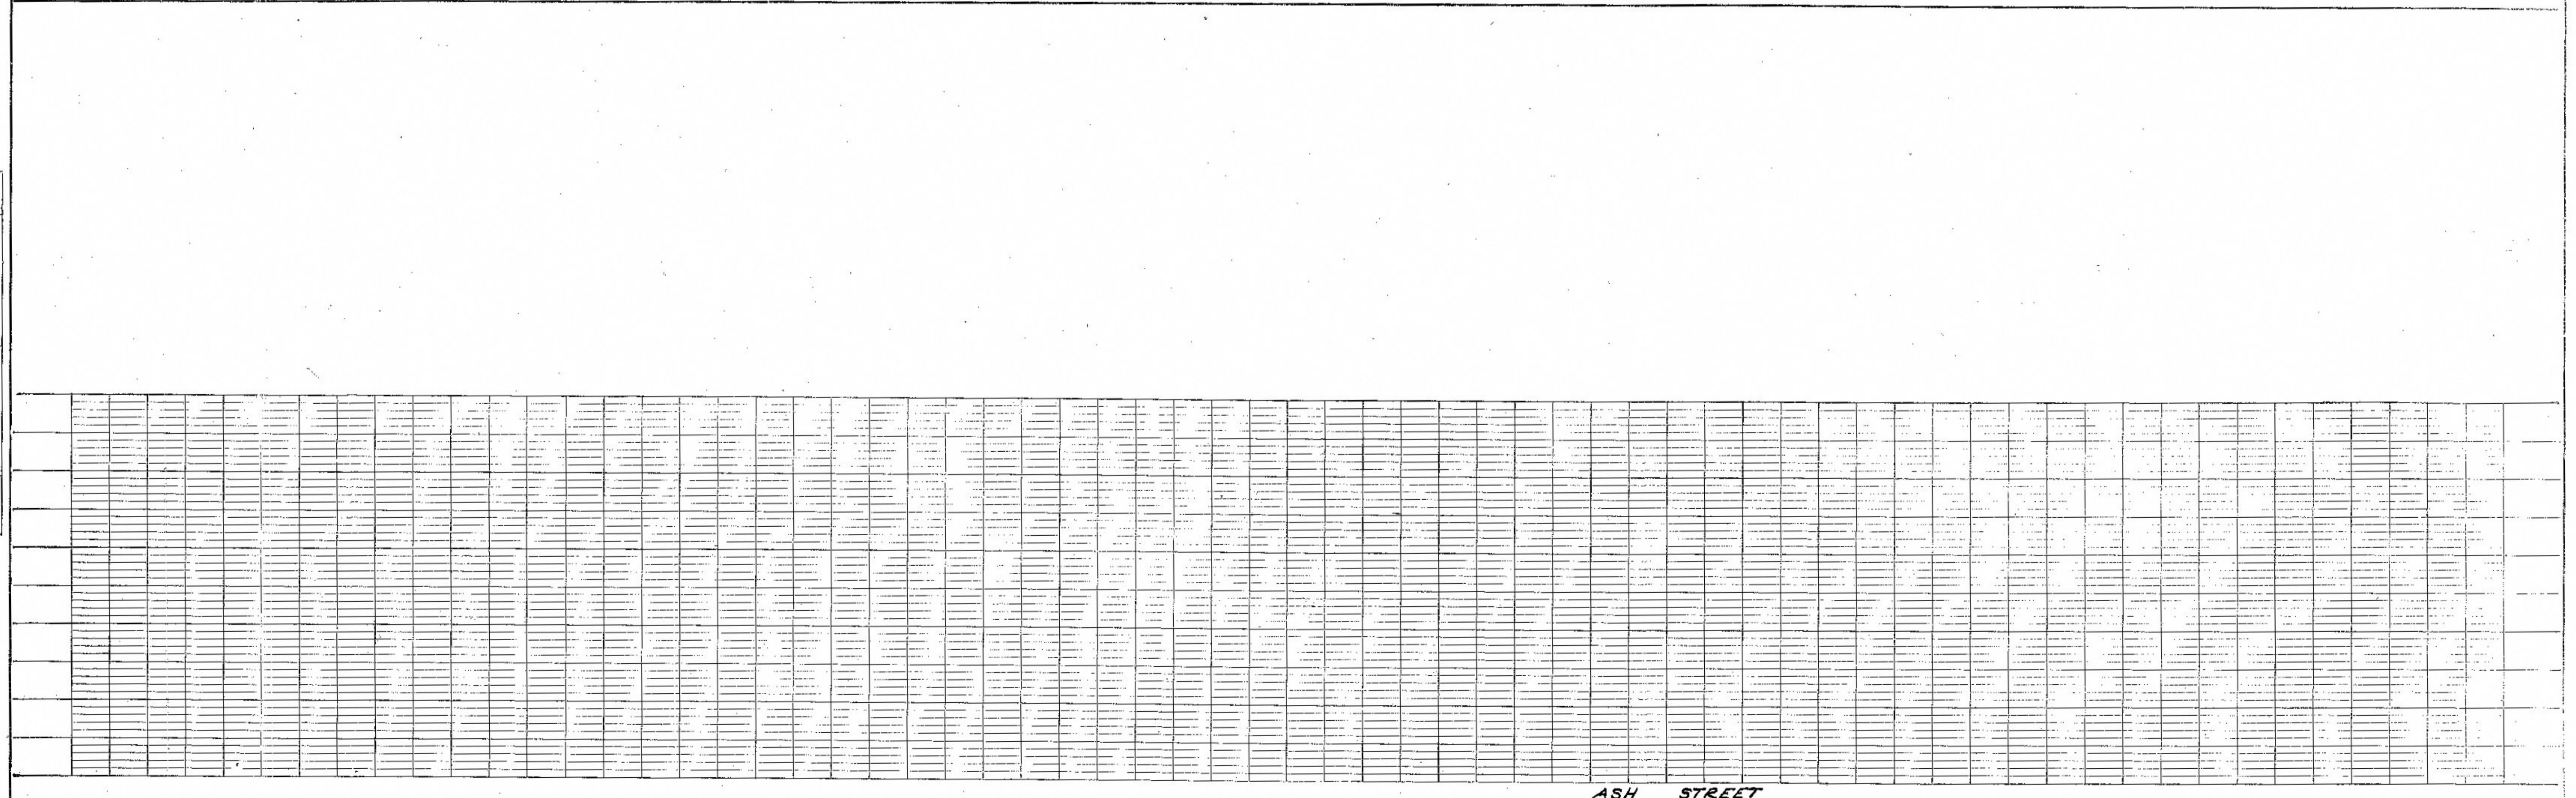

ASH STREET