



DATE
SITE
PLAN
SURVEYED
PLOTTED
NOTE BOOK
NO.
M.H. 228
A.E.B.
ALIGNED CHECKED
BY: W.F. CHAS. 443

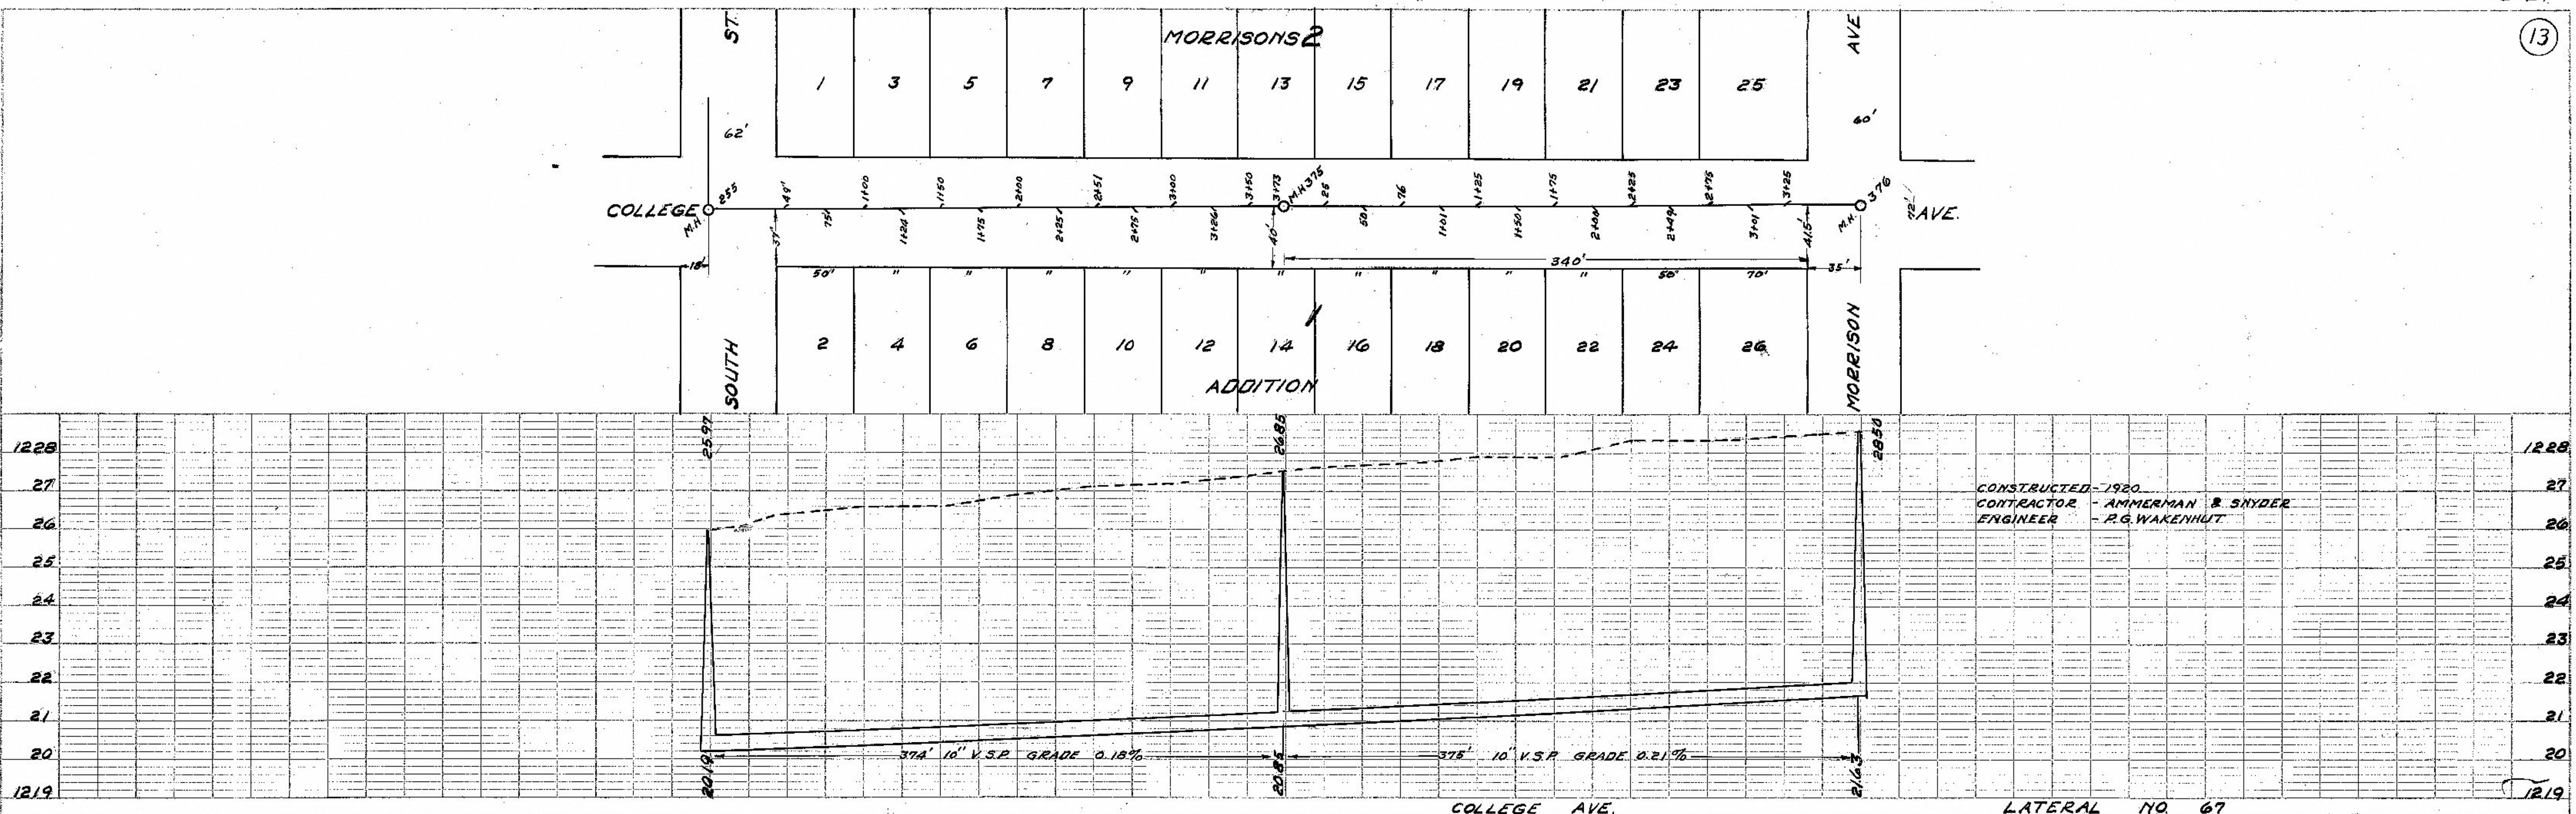

CONSTRUCTED - 1920
CONTRACTOR - AMMERMAN & SNYDER
ENGINEER - P.G. WAKENHUT

DATE
SITE
PROFILE
SURVEYED
PLOTTED
NOTE BOOK
NO.
M.H. 228
A.E.B.
GRAINS CHECKED
BY: W.F. CHAS. 443

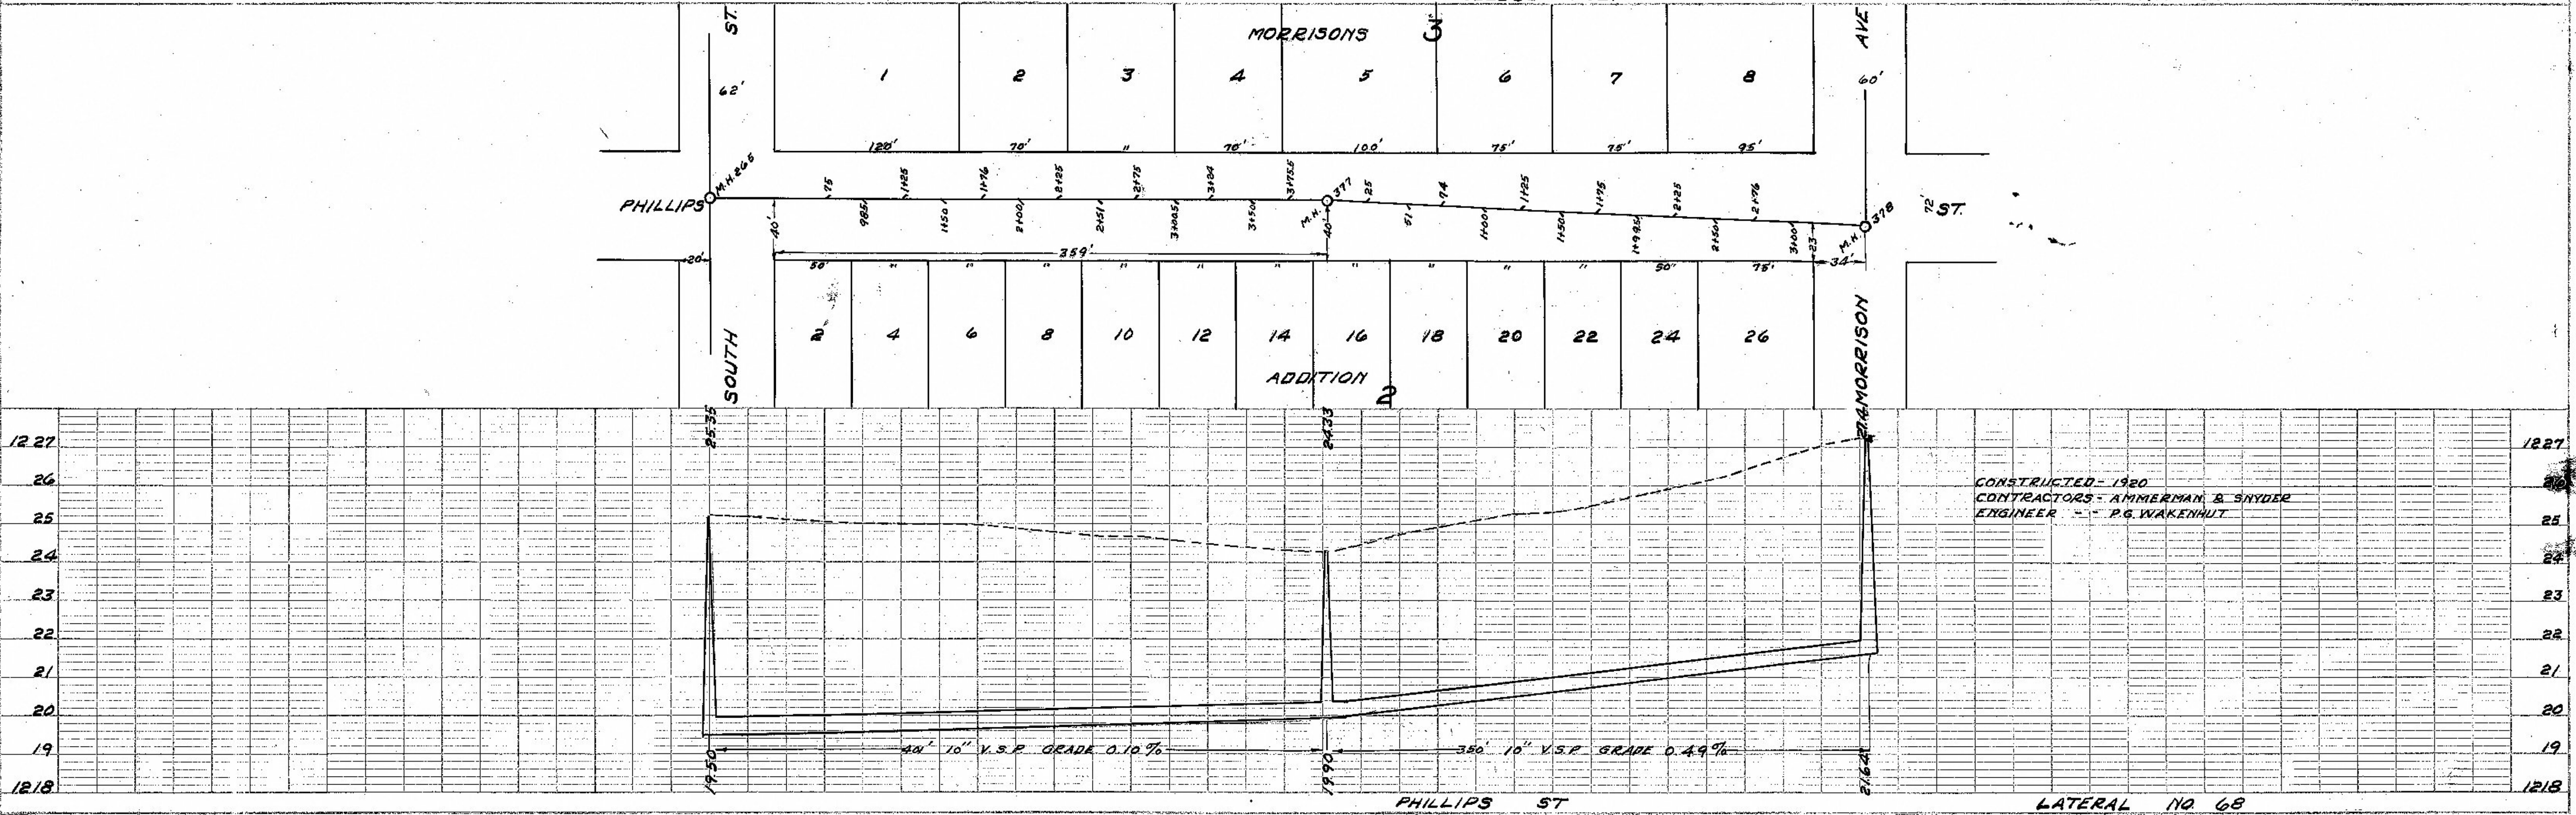

CONSTRUCTED - 1920
CONTRACTORS - AMMERMAN & SNYDER
ENGINEER - P.G. WAKENHUT