


DATE _____ BY _____
 SURVEYED _____
 PLOTTED _____
 CHECKED _____
 RT. OF WAY CHECKED _____
 PLAN _____
 NOTE BOOK _____
 NO. _____

DATE _____ BY _____
 SURVEYED _____
 PLOTTED _____
 CHECKED _____
 B. M. NOTED _____
 STRUCTURE NOTATIONS CHECKED _____
 PROFILE _____
 NOTE BOOK _____
 NO. _____

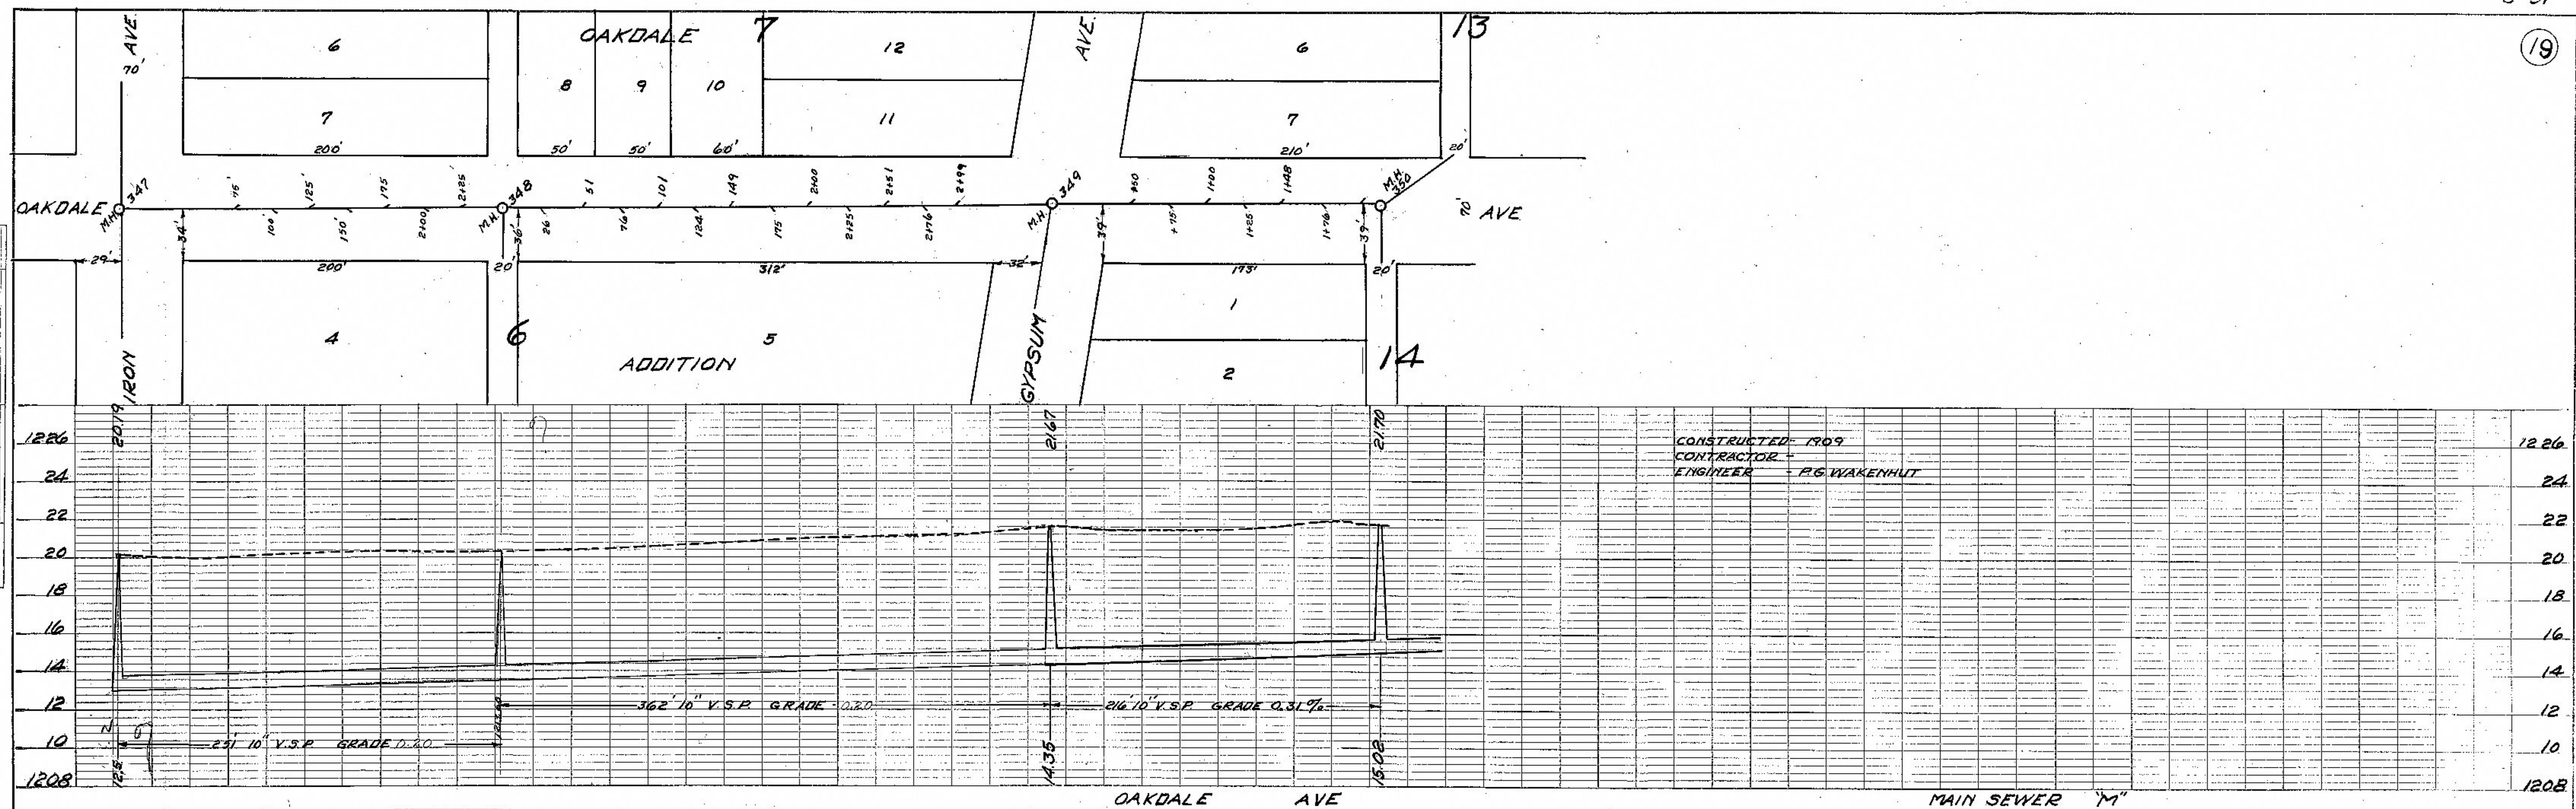

CONSTRUCTED 1909
 CONTRACTOR _____
 ENGINEER - P.S. WAKENHUT

