


DATE: _____
 BY: H.W. B.P.
 SURVEYED: _____
 PLOTTED: _____
 CHECKED: _____
 PLAN NO. _____

DATE: _____
 BY: H.W. B.P.
 SURVEYED: _____
 PLOTTED: _____
 CHECKED: _____
 PROFILE NO. _____

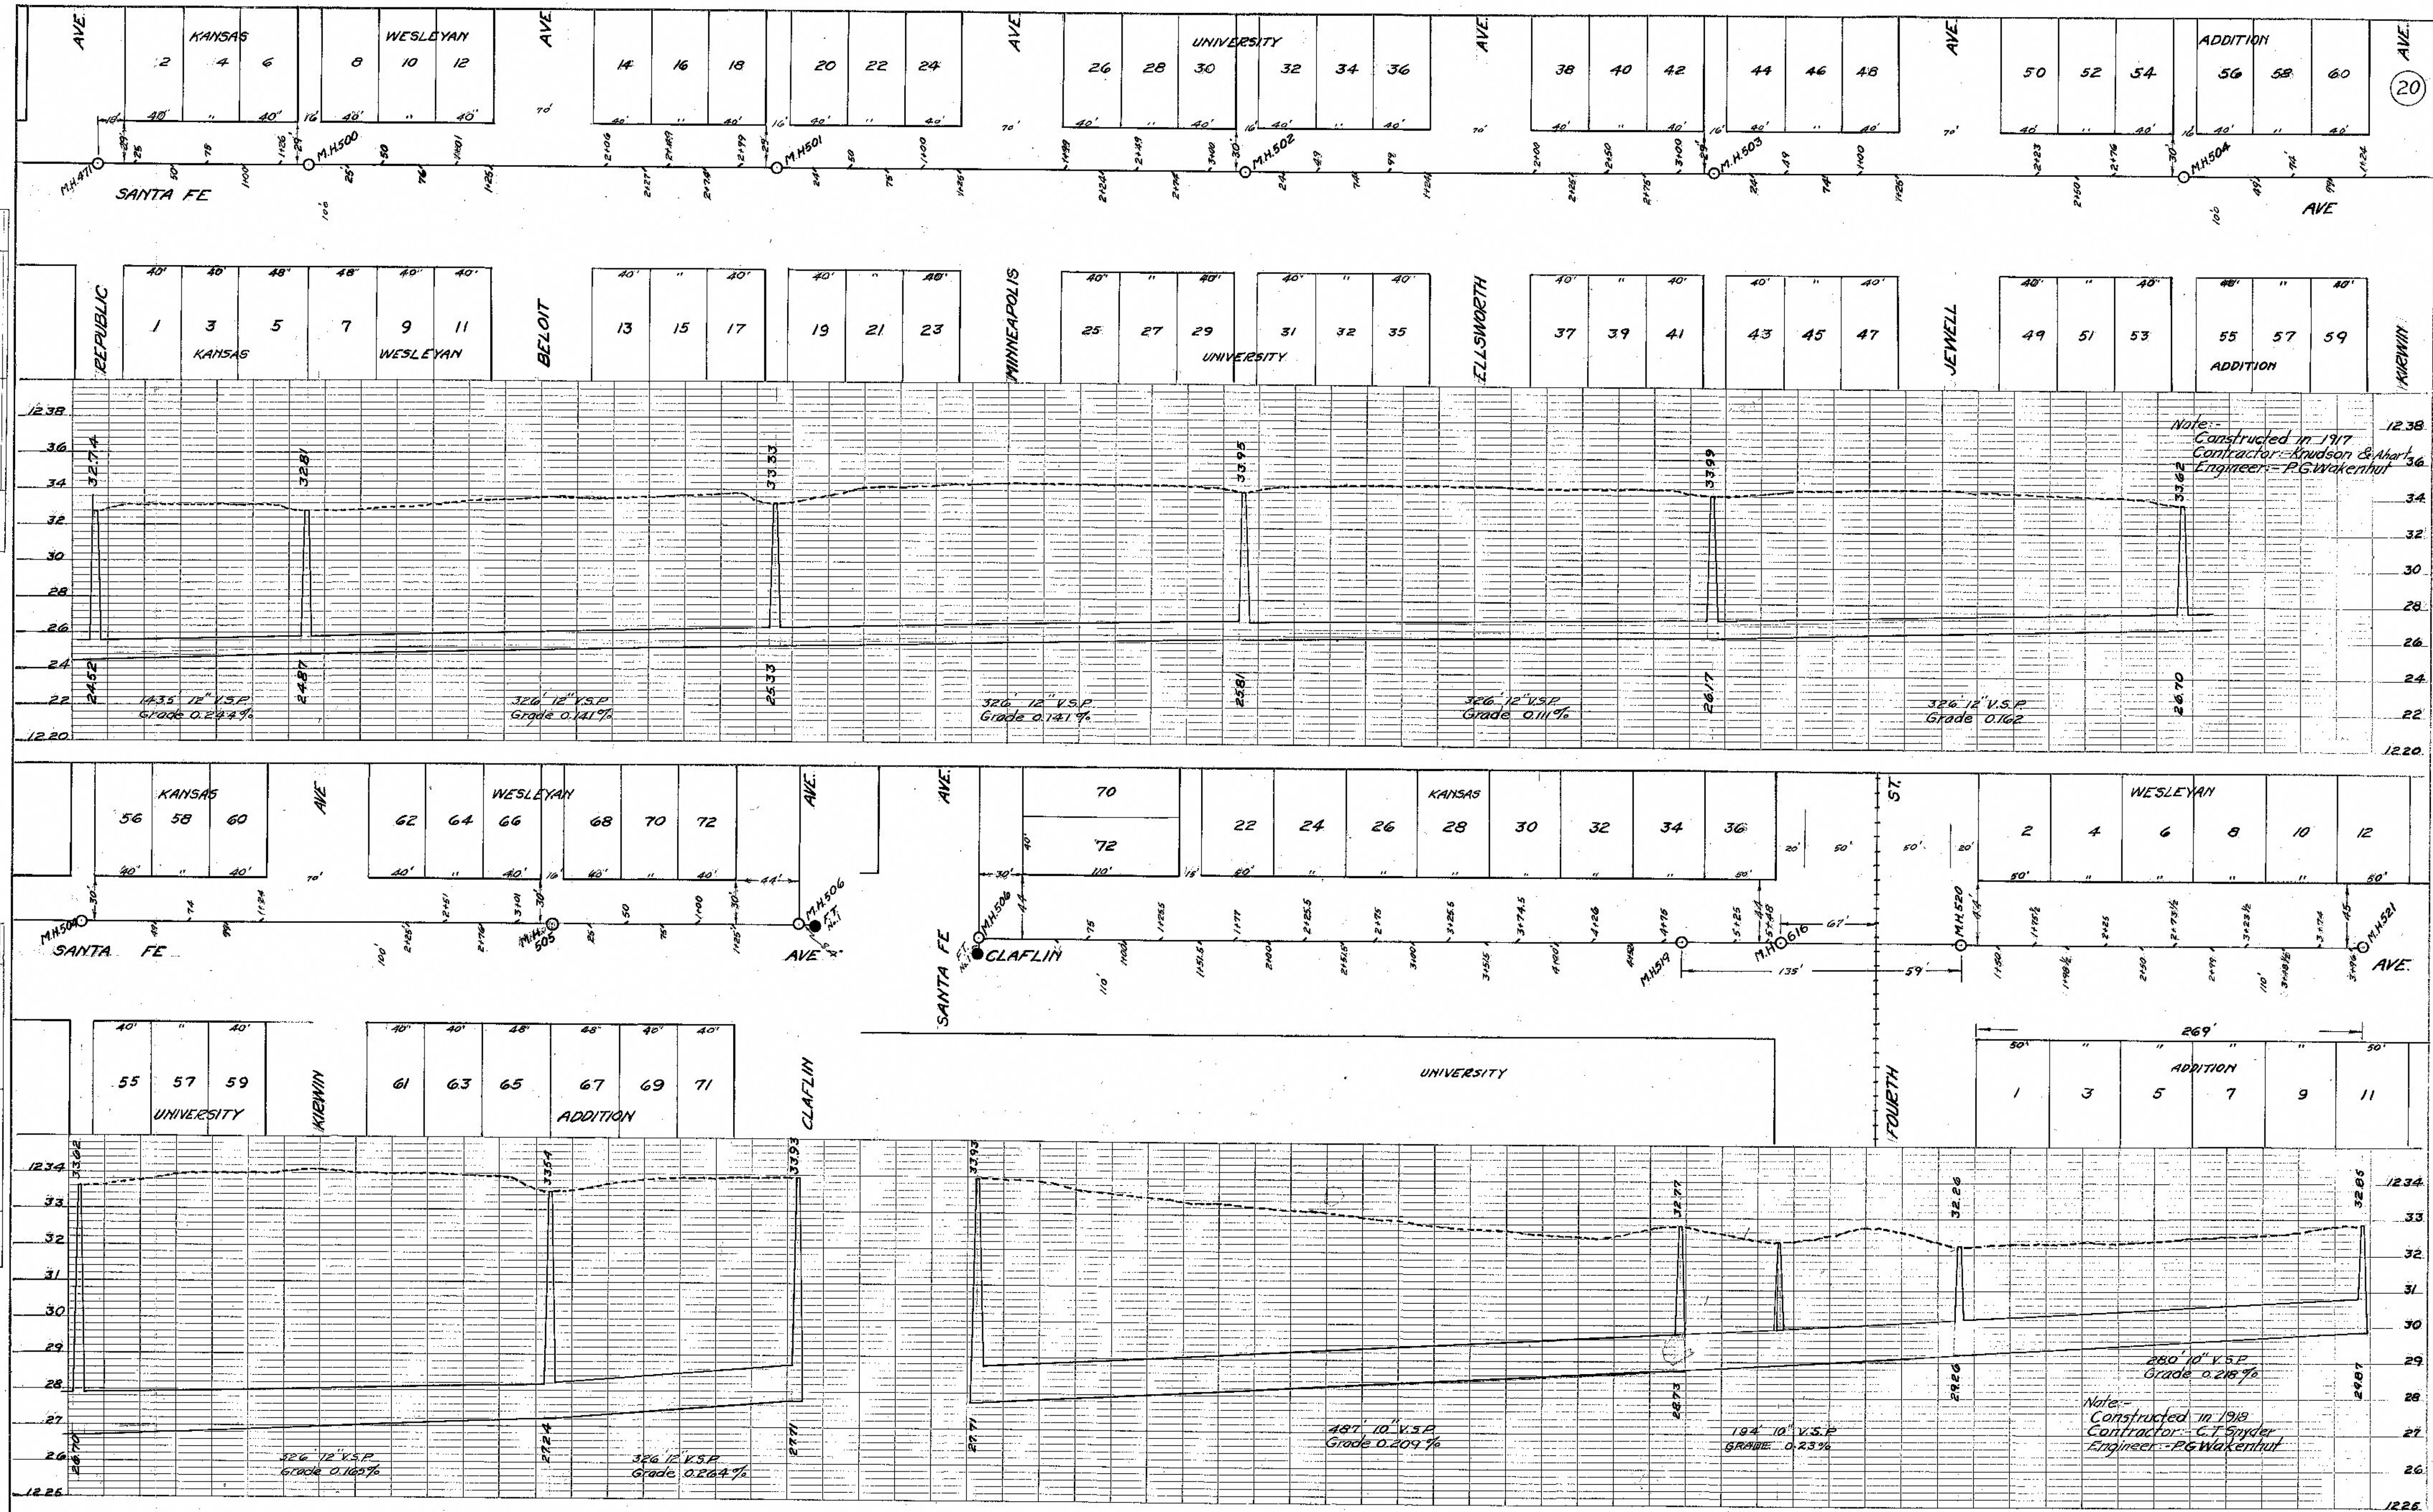

Note:
 Constructed in 1917
 Contractor: Knudson & Ahart
 Engineer: P.G. Wakenhut

Note:
 Constructed in 1918
 Contractor: C.T. Snyder
 Engineer: P.G. Wakenhut

S. SANTA FE AVE and E. CLAFLIN AVE