(21)

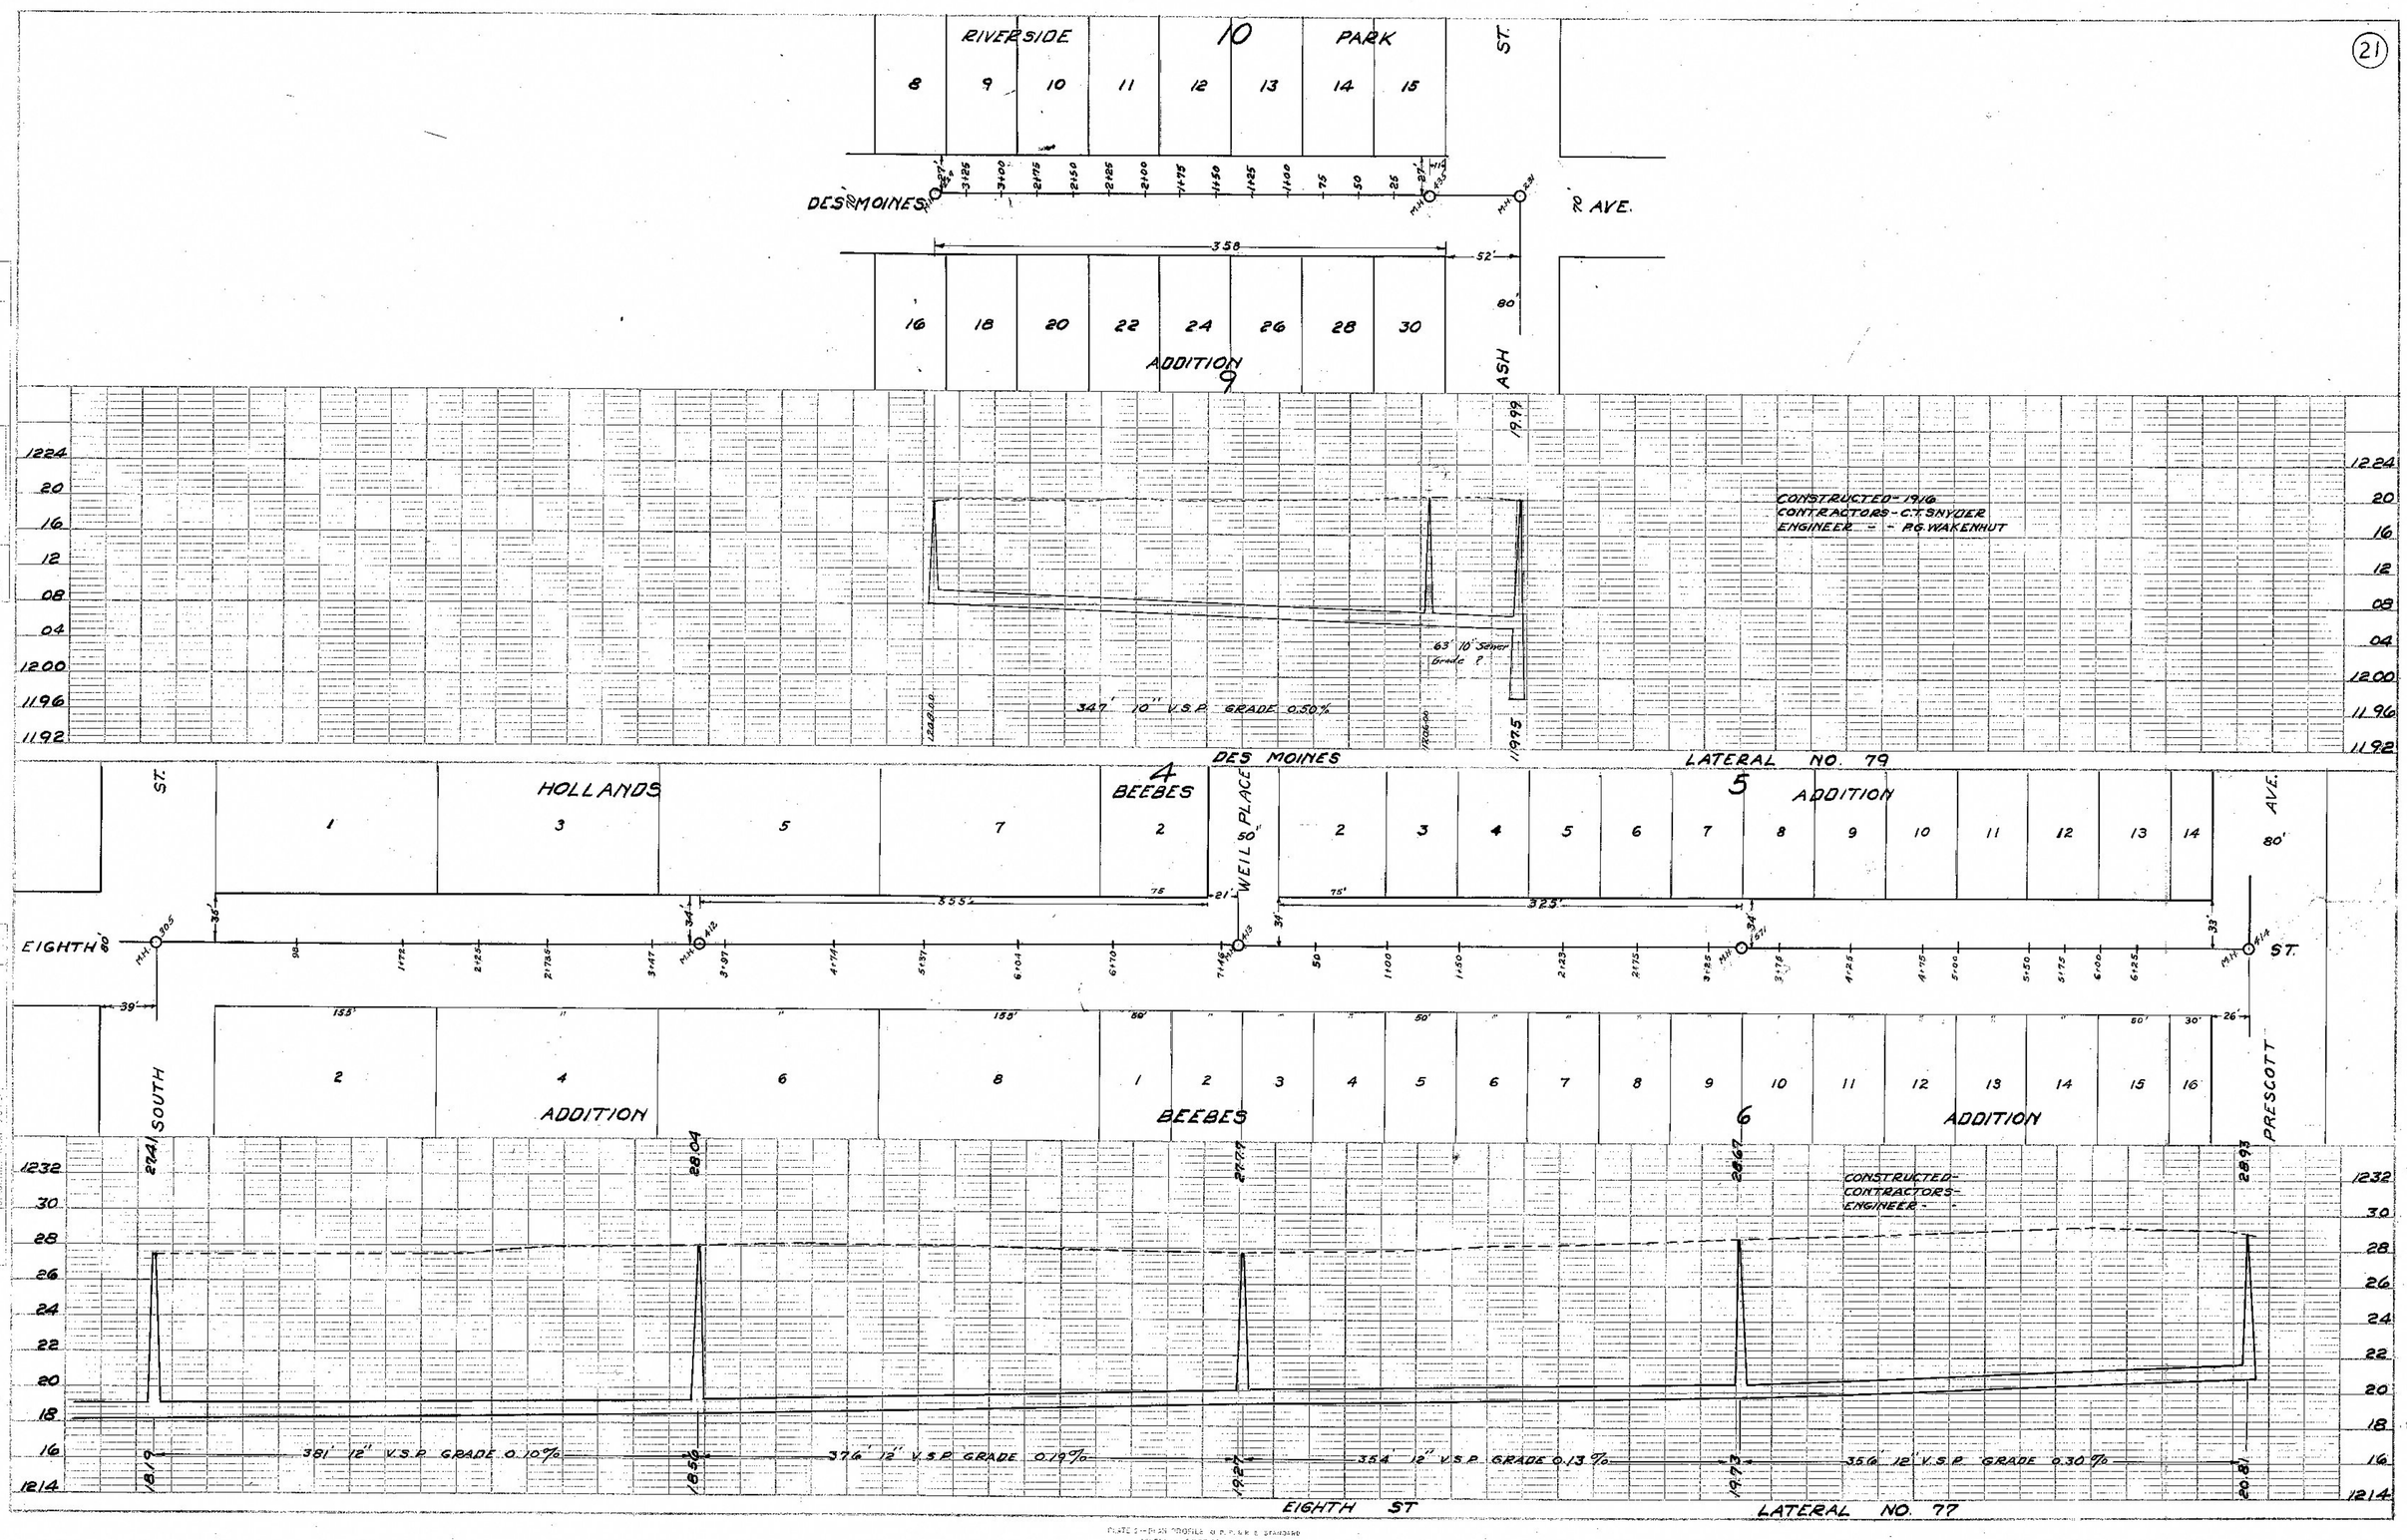

PLATE 2—PLAN AND PROFILE OF P.W.&N. STANDARD
