(24)

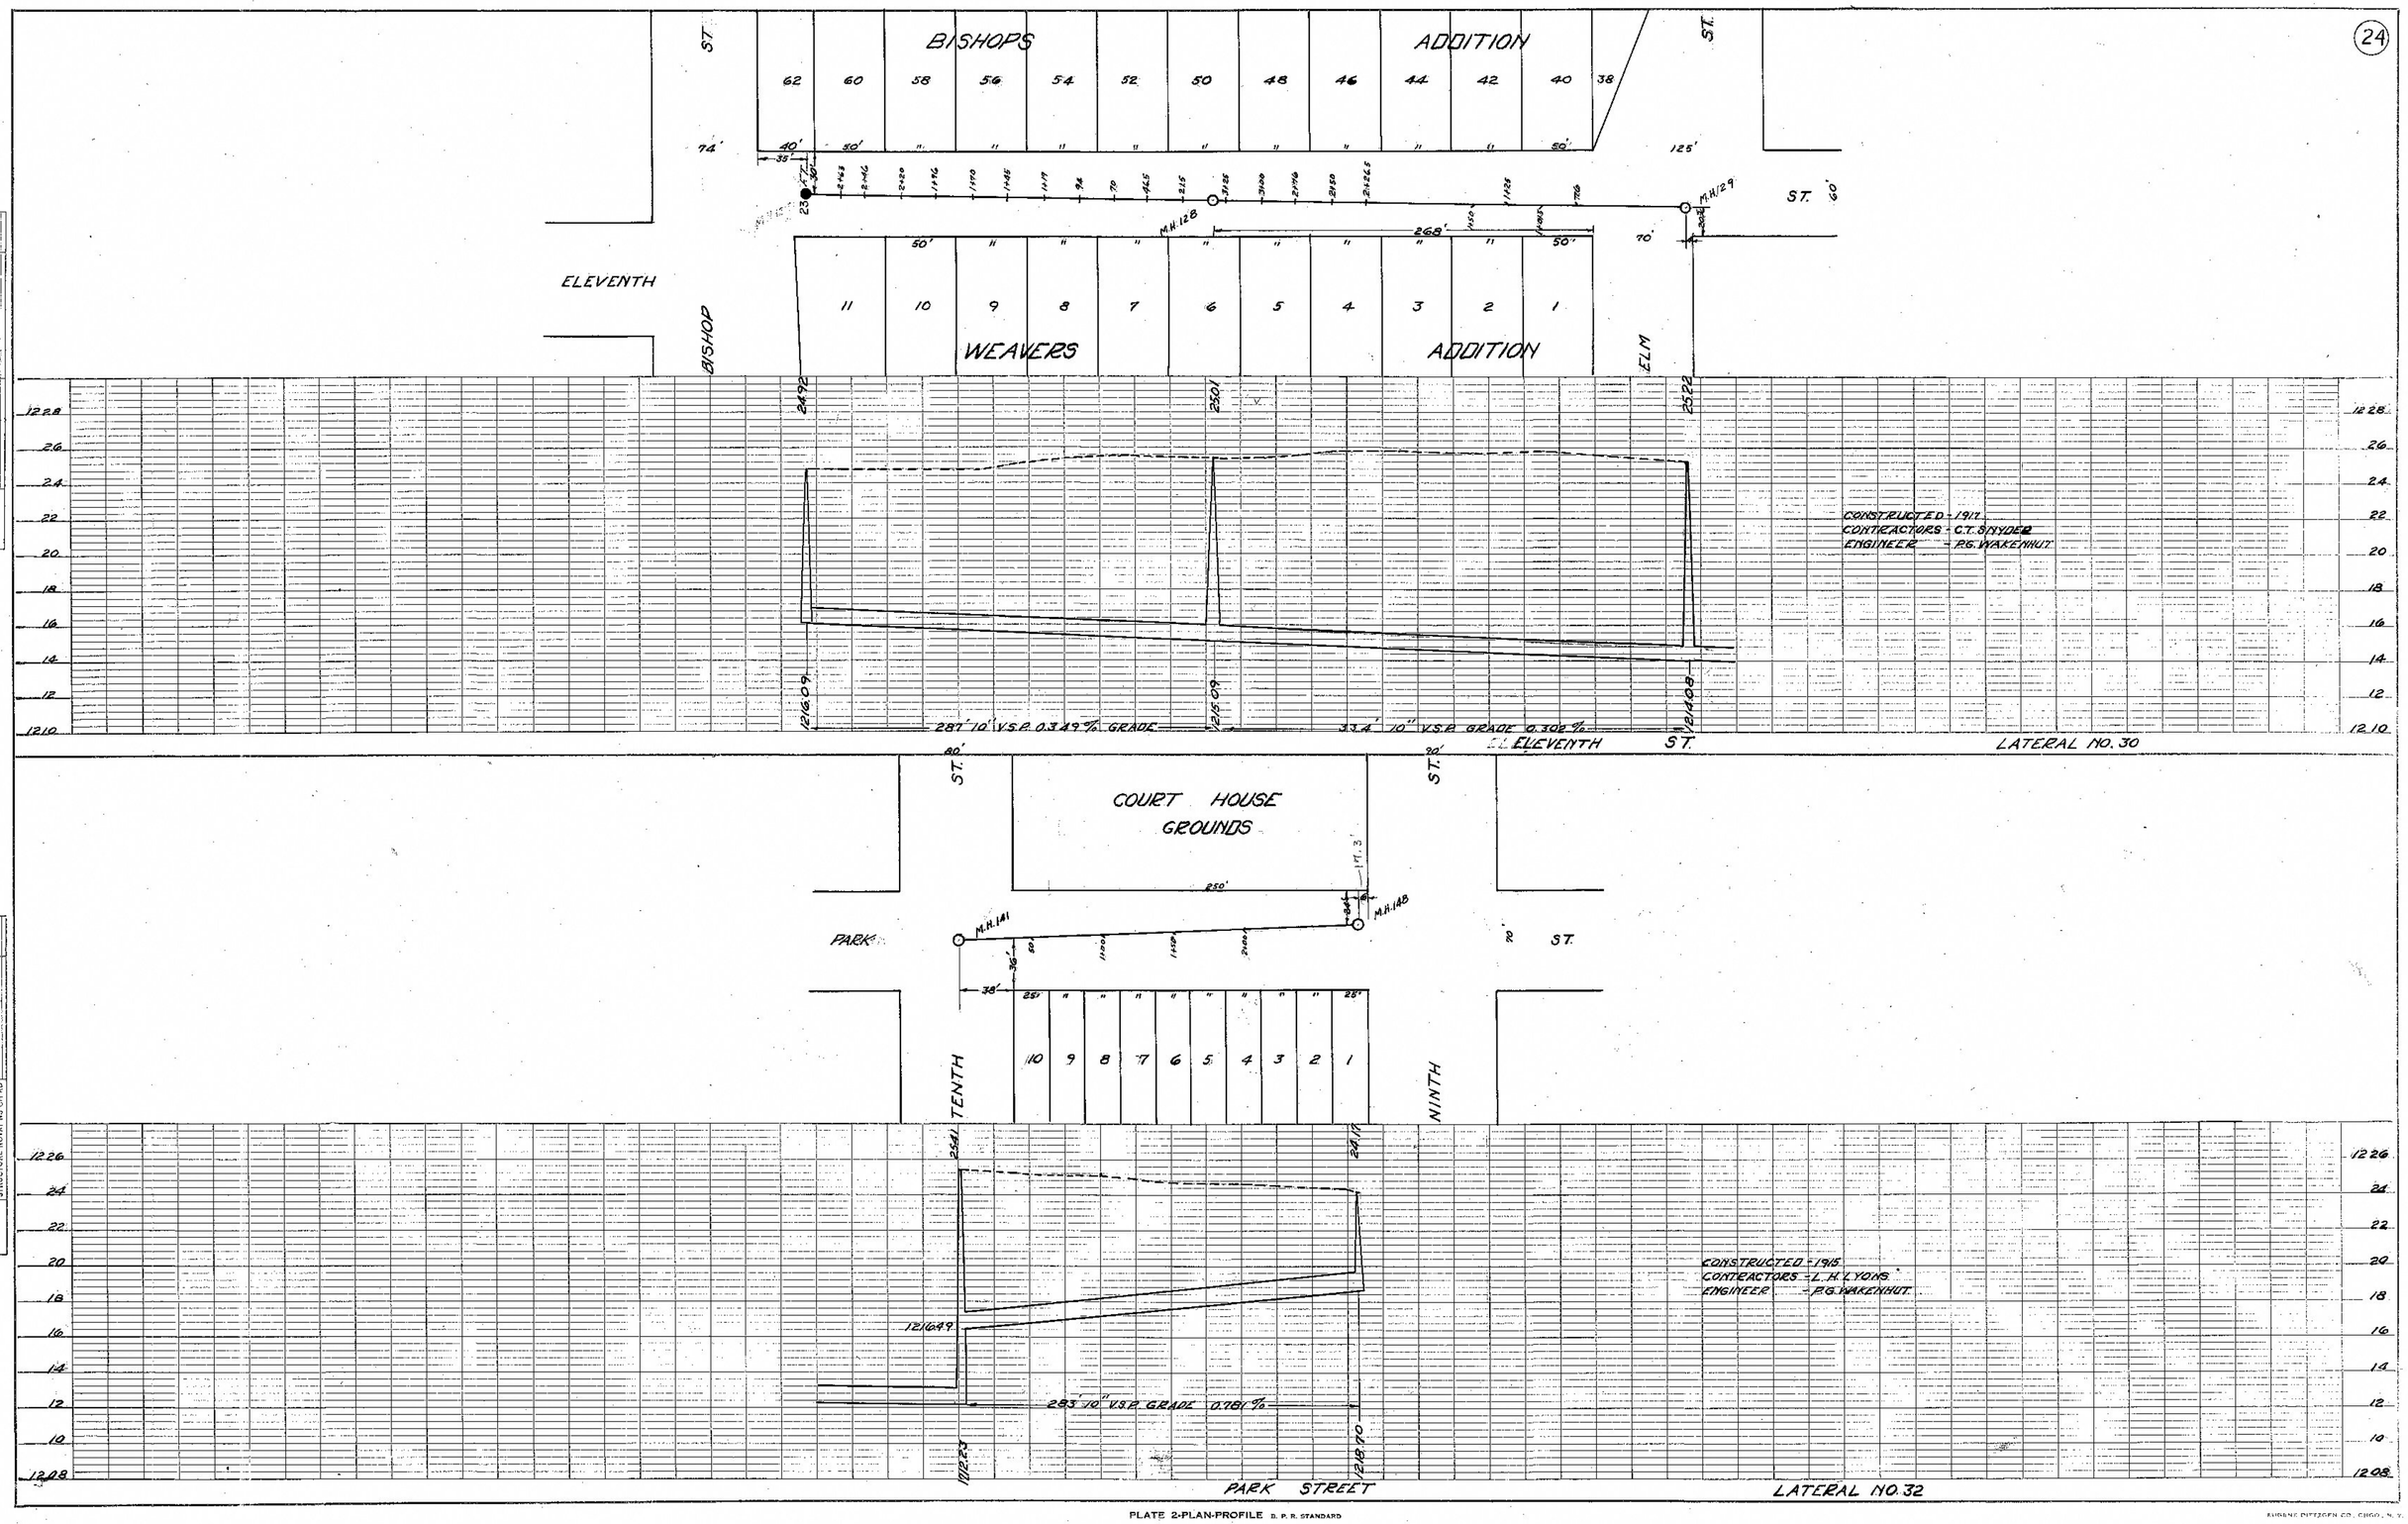

PLAN			
SURVEYED			
PLOTTED			
NOTE BOOK ALIGNMENT CHECKED			
NO. PCT. OF WAY CHECKED			
BY	H.F.W. P.G.W.		
DATE			

PROFILE			
SURVEYED			
PLOTTED			
NOTE BOOK CHECKED			
No. B. Ms. NOTED			
STRUCTURE NOTATIONS CH'KD			
BY	H.F.W. P.G.W.		
DATE			

PLATE 2-PLAN-PROFILE B. P. R. STANDARD

EUGENE DIETZGEN CO. CHGO., N. Y.