25

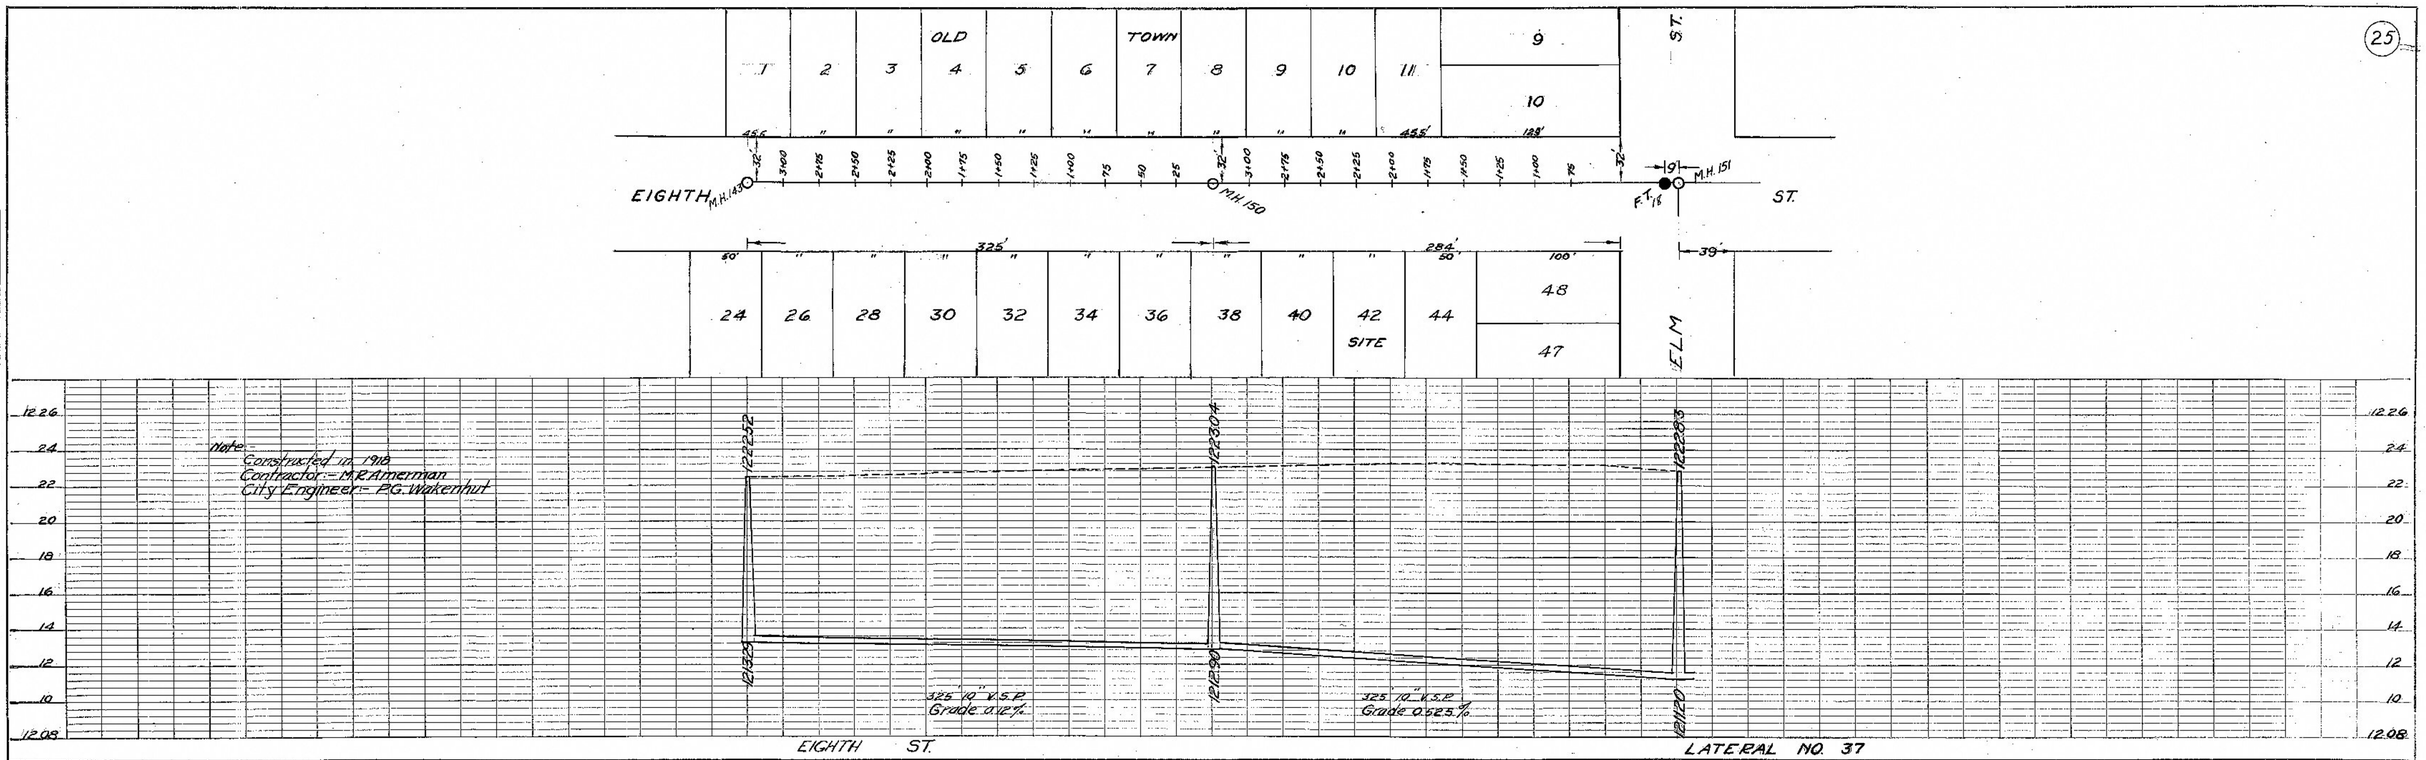

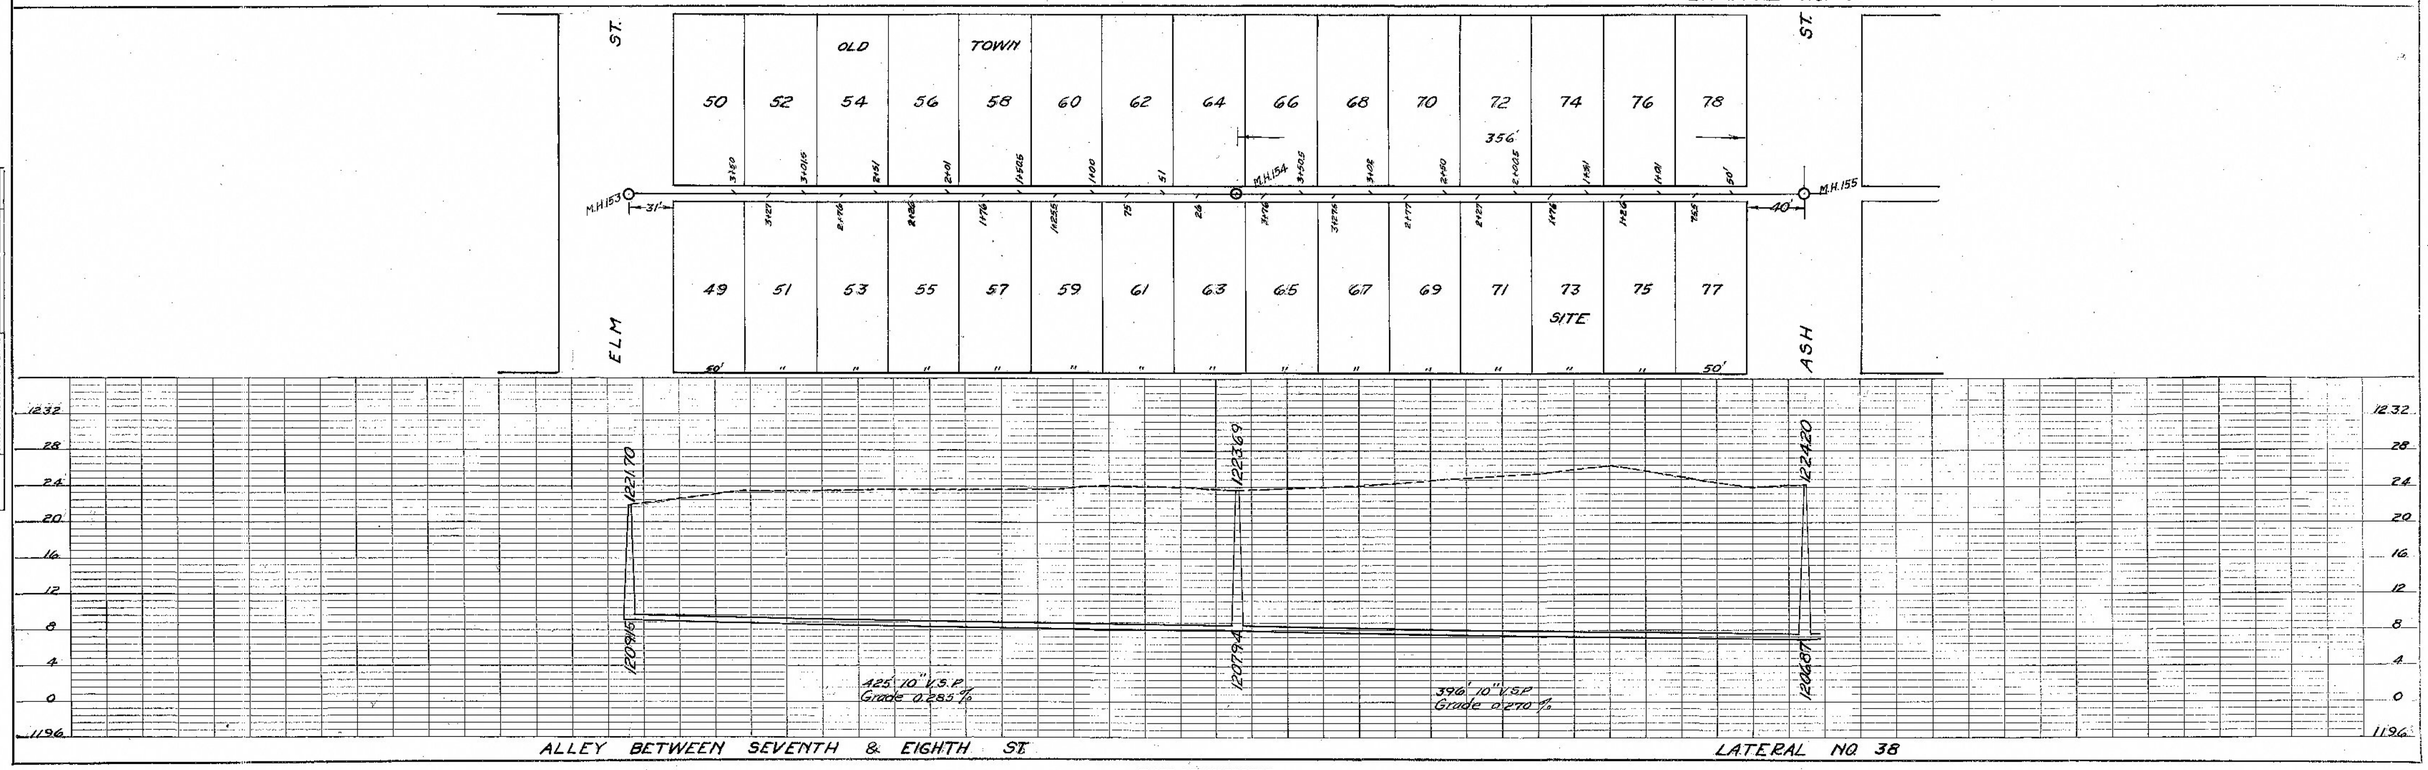

PLAN — NOTE BOOK NO. — SURVEYED — PLOTTED — ALIGNMENT CHECKED — RT. OF WAY CHECKED — BY HFW REB — DATE

PROFILE — NOTE BOOK NO. — SURVEYED — PLOTTED — GRADES CHECKED — B. Ms. NOTED — STRUCTURE NOTATNS CH'KD — BY HFW REB — DATE

PLATE 2-PLAN-PROFILE B. P. R. STANDARD

EUGENE DIETZGEN CO. CHICAGO, N. Y.