



PLAN
 SURVEYED BY
 CHECKED BY
 DATE
 HENRY
 12/28

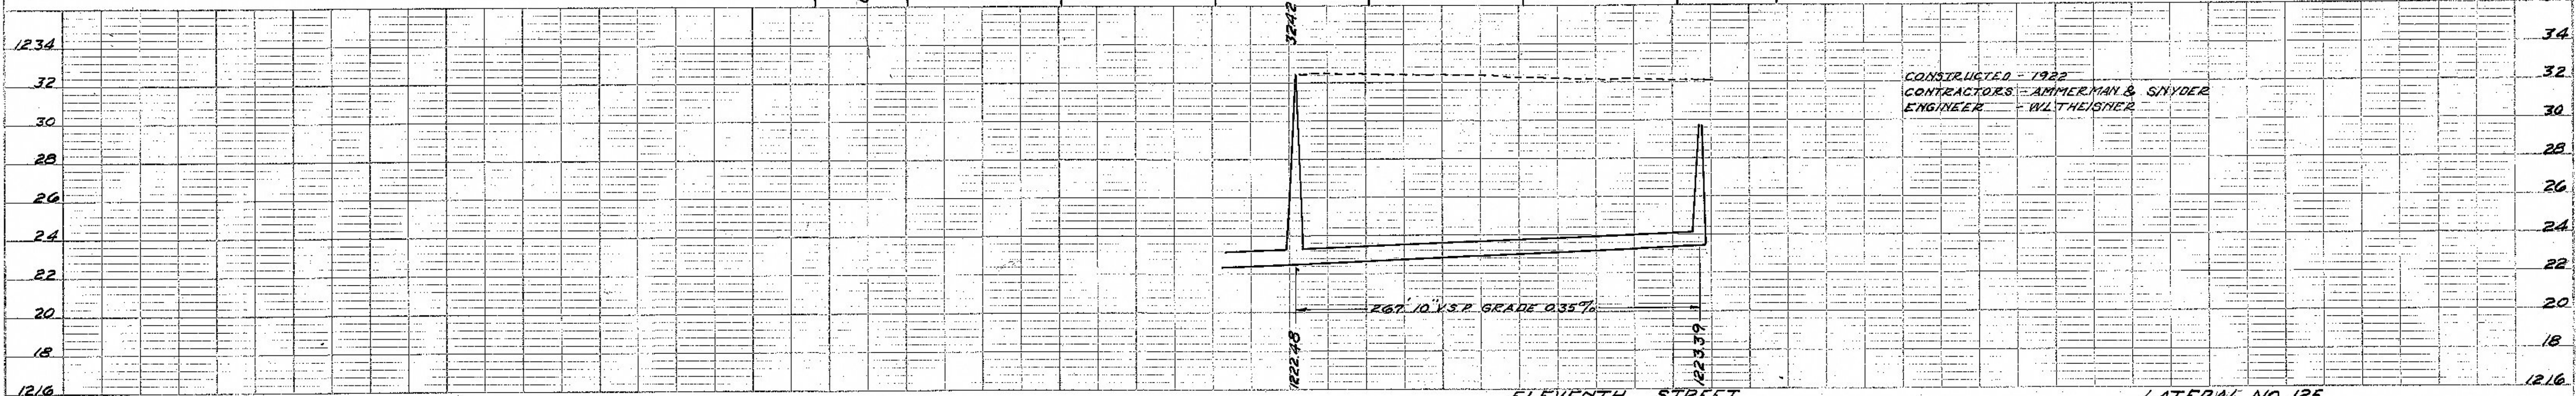

PROFILE
 SURVEYED BY
 CHECKED BY
 DATE
 HENRY
 12/28

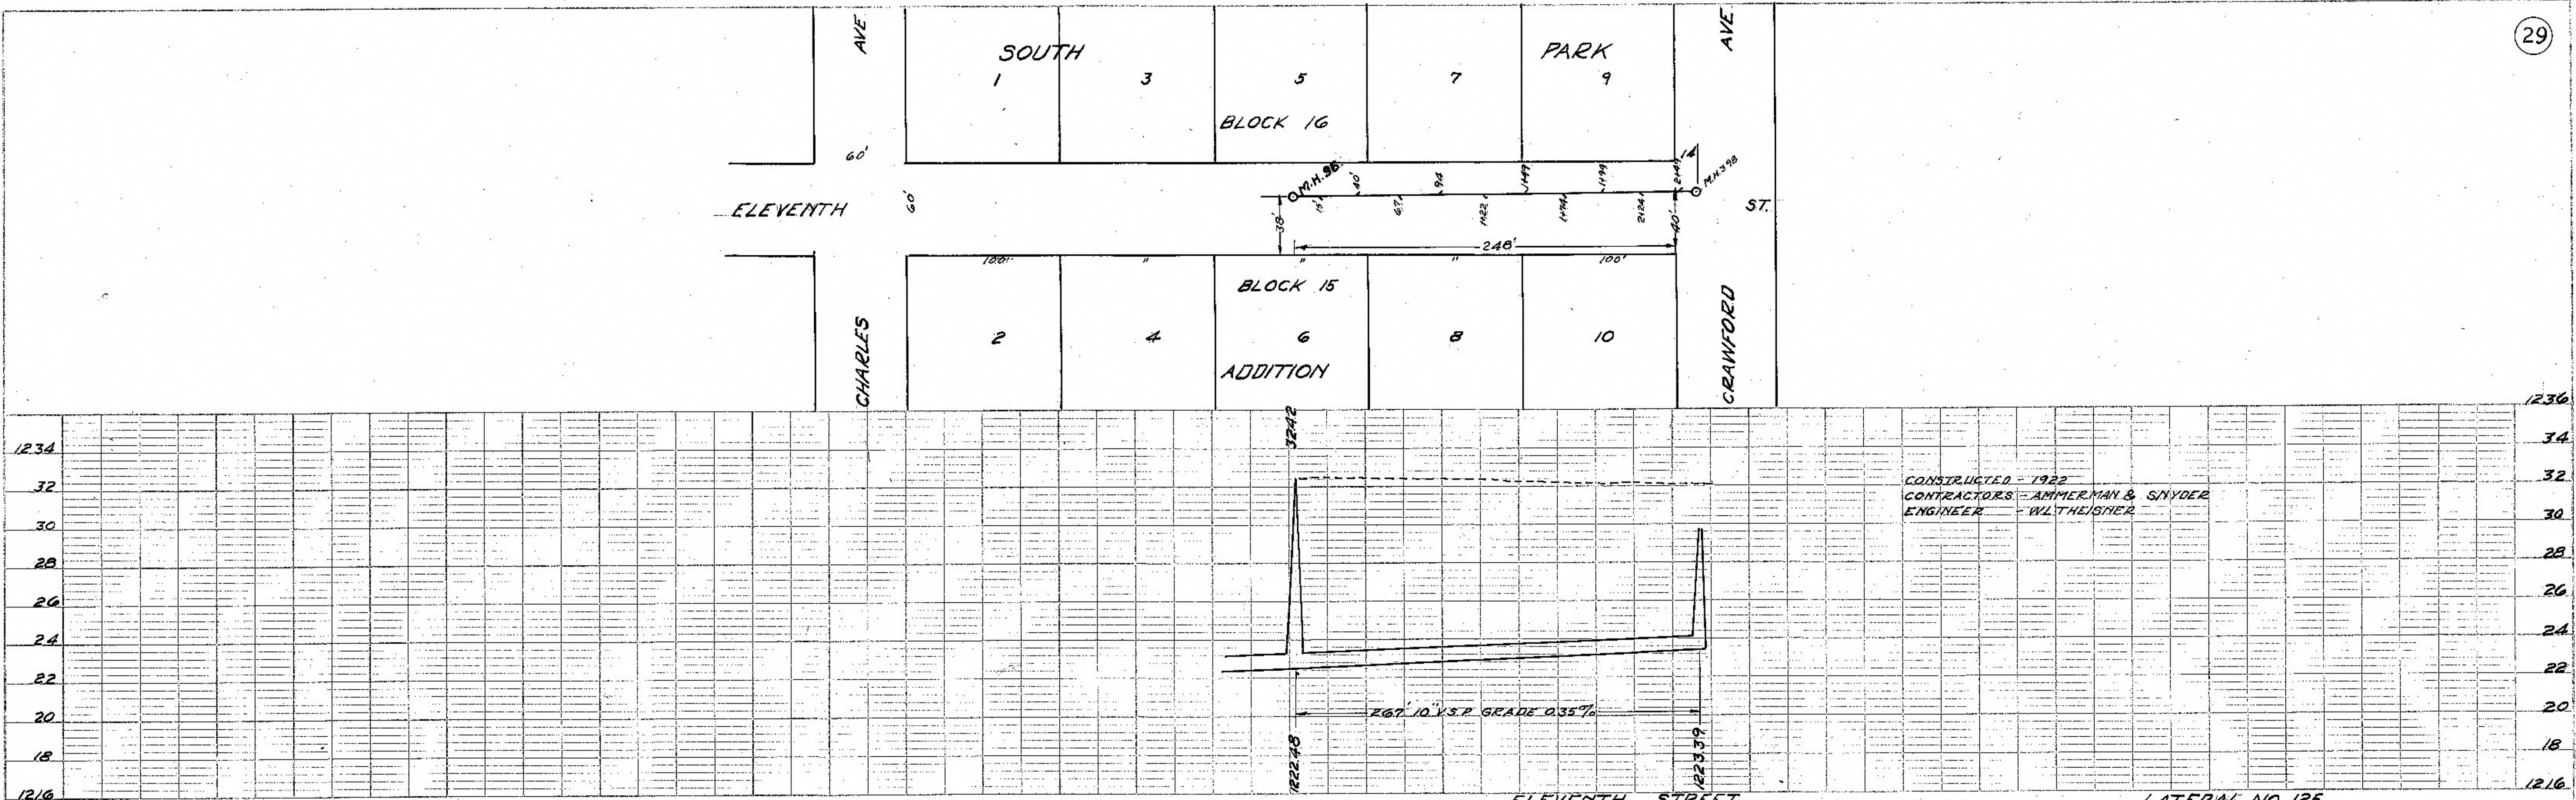